
WATER WE	LL RECORD	Form	WWC-5		vision of Water			AS1	
Original Reco	rd Correction	☐ Chang	ge in Well Use	Res	ources App. No		Well ID		
1 LOCATION OF WATER WELL:			Fraction	Se	ction Number	Township Numb		ge Number	
County: McPherson SW 1/4 SW 1/								□ E ■ W	
2 WELL OWNER: Last Name: First: Street or Rural Address where well is located (if unknown, distance and									
Business: Mid Kansas Coop Association direction from nearest town or intersection): If at owner's address, check her								check here:	
Address: DO Boy 701									
Address: 111 E. Center, Inman									
City: McPherson State: KS ZIP: 67460									
3 LOCATE WE		H OF COM	MPLETED WELL: .	32 f	5 Latitue	le: 38.23219	42	(decimal degrees)	
Denth(s) Groundwater Encountered: 1)									
SECTION BOX:									
WELL'S STATIC WATER LEVEL:									
below land surface, measured on (mo-day-					r)				
above land surface, measured on (mo-day-yr									
Pump test data: Well water was					■ Land Survey □ Topographic Map				
W	s pumping	gpm Online Mapper:							
SW SE	water was f								
W 1	atter.	s pumping				□ Ground	Level TOC		
Estimated Yield:							Land Survey GPS Topographic Map		
S Bore Hole Diameter:			Q in. to				Other		
7 WELL WATER TO BE USED AS: 1. Domestic: 5. □ Public Water Supply: well ID									
1. Domestic:			ater Supply: well ID						
	☐ Household 6. ☐ Dewatering: how many wells?				11. Test Hole: well ID				
	☐ Lawn & Garden 7. ☐ Aquifer Recharge: well ID ☐ Livestock 8. ☐ Monitoring: well ID					☐ Cased ☐ Uncased ☐ Geotechnical  12. Geothermal: how many bores?			
Livestock									
2.				Extraction	a) Closed Loop ☐ Horizontal ☐ Vertical b) Open Loop ☐ Surface Discharge ☐ Inj. of Water				
4. Industrial		Recovery		ZAU action					
Was a chemical/bacteriological sample submitted to KDHE?  Yes No If yes, date sample was submitted:									
Water well disinfected? ☐ Yes ■ No									
8 TYPE OF CASING USED: ☐ Steel ■ PVC ☐ Other									
Casing diameter									
Casing height above land surface5.04 in. Weight lbs./ft. Wall thickness or gauge No. Sch. 40									
TYPE OF SCREEN OR PERFORATION MATERIAL:									
☐ Steel ☐ Stainless Steel ☐ Fiberglass ☐ PVC ☐ Other (Specify)									
☐ Brass ☐ Galvanized Steel ☐ Concrete tile ☐ None used (open hole)									
SCREEN OR PERFORATION OPENINGS ARE:									
☐ Continuous Slot ☐ Mill Slot ☐ Gauze Wrapped ☐ Torch Cut ☐ Drilled Holes ☐ Other (Specify)									
□ Louvered Shutter □ Key Punched □ Wire Wrapped □ Saw Cut □ None (Open Hole)									
SCREEN-PERFORATED INTERVALS: From .30									
GRAVEL PACK INTERVALS: From 28 ft. to 32 ft., From ft. to ft., From ft. to ft.									
9 GROUT MATERIAL: Neat cement Cement grout Bentonite Other Concrete									
Grout Intervals: From									
			□ D: D:	_	T investment Day	Turnet:	-: J- C4		
Septic Tank		Lateral Line			Livestock Pen		cide Storage		
☐ Sewer Lines ☐ Cess Pool ☐ Sewage Lagoon ☐ Fuel Storage ☐ Abandoned Water Well									
□ Watertight Sewer Lines     □ Seepage Pit     □ Feedyard     □ Fertilizer Storage     □ Oil Well/Gas Well       □ Other (Specify)     □ Other (Specify)									
Direction from well?									
10 FROM T		LITHOLO		FROM	TO I	ITHO. LOG (cont.) or	PLUGGIN	GINTERVALS	
0 0.5	Concrete	LITTOLO	OLC DOG	I ICOM	10 1		- 2000111	LEAT TIES	
0.5 1.5	Sand								
1.5		v Dorl D	OWD						
	Clay, sl. silt		OWII						
		Clay, silty, Brown							
16 24		Clay, Brown w/occ. white calc. mat.							
24 26		Clay, sl. silty, Red Brown							
26 27					Notes:				
27 32 Shale, Red Brown mottled Gray Green									
11 CONTRACTOR'S OR LANDOWNER'S CERTIFICATION: This water well was constructed, reconstructed, or plugged									
under my jurisdiction and was completed on (mo-day-year) .12/19/20.18 and this record is true to the best of my knowledge and belief.									
Kansas Water Well Contractor's License No. 521 This Water Well Record was completed on (mpo-day, year) .1/30/2019									
under the business name of GeoCore Inc.  Signature Signature Suprementation of GeoCore Inc.									
Mail 1 white copy along with a fee of \$5.00 for each constructed well to: Kansas Department of Health and Environment, Bureau of Water, GWTS Section, 1000 SW Jackson St., Suite 420, Topeka, Kansas 66612-1367. Mail one to Water Well Owner and retain one for your records. Telephone 785-296-5524.									
						for your records. Teleph	Dovinged	7/10/2015	
Visit us at http://www	v.kdheks.gov/waterwell	/index.html		KSA 82a-12	414		Revised	//10/2013	

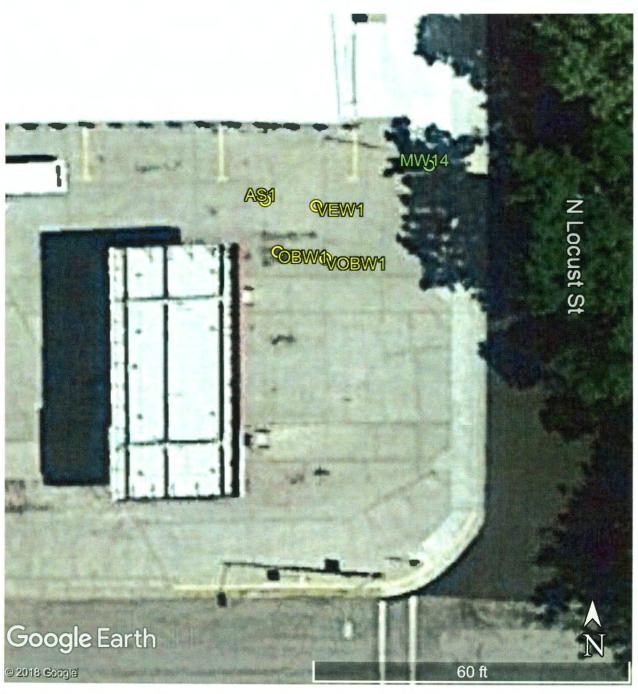

RECEIVED

FEB 21 2019

BUREAU OF WATER

Mid Kansas Coop, Inman 111 E. Center Street

Inman, Kansas

KDHE Project Code: A5 059 40059

## **GPS Coordinates:**

AS1: 38.2321942, -97.7747681 OBW1: 38.2321680, -97.7747598

VEW1: VOBW1: 38.2321918, -97.7747349 38.2321649, -97.7747292