
WATER	WELLI	RECORD Form	WWC-5	D	ivision of Water		VEW1	
Original Record Correction Change in Well Use			Resources App. No.		w	Vell ID		
1 LOCATION OF WATER WELL: Fraction				S	ection Number			
	y: McPhers		9	T 21 S	R 4 🗆 E 🔳 W			
	OWNER:		First:	Street or Rural Address where well is located (if unknown, distance and				
Address:		sas Coop Association	1	direction from nearest town or intersection): If at owner's address, check here:				
Address:	TO DOX 1			111 E. Center, Inman				
City: McPherson State: KS ZIP: 67460								
3 LOCAT		4 DEPTH OF CO	MPLETED WELL:					
WITH "	DN BOX:	Depth(s) Groundwate	r Encountered: 1)					
	N DOA.		3) ft., or 4)		Horizonta	Horizontal Datum: WGS 84 NAD 83 NAD 27		
			ATER LEVEL:			r Latitude/Longitude:	,	
NW	NE		e, measured on (mo-day			(unit make/model: (WAAS enabled? □ Ye		
			Pump test data: Well water was ft.			Land Survey 🔲 Topographic Map		
W								
SW	SW SE after hours pumping							
XI	X Estimated Yield:			gpm	6 Elevation: 1524.63 ft. Ground Level TOC			
S Bore Hole Diameter:1.1 in				ft. and Source: Land Survey GPS Topographic M				
1 mile in. to ft. □ Other								
7 WELL WATER TO BE USED AS:								
1. Domestic: 5. Dublic Water Supply: well ID Dewatering: how many wells?								
	□ Lawn & Garden 7. □ Aquifer Recharge: well ID							
	Livestock 8. Monitoring: well ID				12. Geothern	12. Geothermal: how many bores?		
	2. Irrigation 9. Environmental Remediation: well II							
				Extraction	b) Open Loop □ Surface Discharge □ Inj. of Water 13. □ Other (specify):			
Was a chemical/bacteriological sample submitted to KDHE? Yes No If yes, date sample was submitted:								
Water well disinfected? Yes No								
8 TYPE OF CASING USED: Steel PVC Other CASING JOINTS: Glued Clamped Welded Threaded								
8 TYPE OF CASING USED: □ Steel ■ PVC □ Other								
Casing height above land surface								
TYPE OF SCREEN OR PERFORATION MATERIAL:								
Steel Steel Fiberglass Other (Specify) Brass Galvanized Steel Concrete tile None used (open hole)								
SCREEN OR PERFORATION OPENINGS ARE:								
□ Continuous Slot ■ Mill Slot □ Gauze Wrapped □ Torch Cut □ Drilled Holes □ Other (Specify)								
□ Louvered Shutter □ Key Punched □ Wire Wrapped □ Saw Cut □ None (Open Hole)								
SCREEN-PERFORATED INTERVALS: From								
9 GROUT MATERIAL: Neat cement Cement grout Bentonite Other Concrete								
Grout Intervals: From ft. to ft. From ft. to ft. to ft. to ft.								
Nearest source of possible contamination:								
□ Septic Tank □ Lateral Lines □ Pit Privy □ Livestock Pens □ Insecticide Storage								
Sewer Lines Cess Pool Sewage Lagoon Fuel Storage Abandoned Water Well Watertight Sewer Lines Seepage Pit Feedyard Fertilizer Storage Oil Well/Gas Well								
Other (Specify)								
Direction from well? ft.								
10 FROM	TO	LITHOLO	GIC LOG	FROM	TO LI	THO. LOG (cont.) or PLU	JGGING INTERVALS	
0		Concrete						
8		clay, sl. silty, Dark Brown clay, sl. silty, Brown						
13		Clay, Brown w/white						
		elay, brown w/wille	oulo, mat.					
		a and a second		-		ter orden gegeneren		
				Notes:				
11 CONTRACTOR'S OR LANDOWNER'S CERTIFICATION: This water well was constructed, reconstructed, or plugged under my jurisdiction and was completed on (mo-day-year) .12/18/2018 and this record is true to the best of my knowledge and belief.								
Kansas Water Well Contractor's License No. 527								
under the business name of GeoCore Inc								
Mail 1 white copy along with a fee of \$5.00 for each constructed well to: Kansas Department of Health and Environment, Bureau of Water, GWTS Section,								
1000 SW Jackson St., Suite 420, Topeka, Kansas 66612-1367. Mail one to Water Well Owner and retain one for your records. Telephone 785-296-5524. Visit us at http://www.kdheks.gov/waterwell/index.html KSA 82a-1212 Revised 7/10/2015								
visit us at http://www.kdneks.gov/waterweit/index.html KSA 62a-1212 Revised //10/2015								

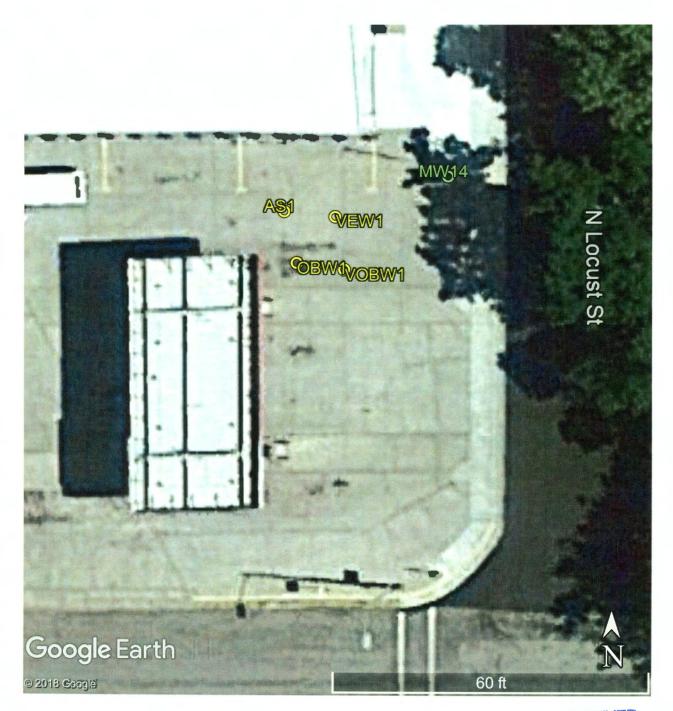

Mid Kansas Coop, Inman 111 E. Center Street Inman, Kansas KDHE Project Code: A5 059 40059

GPS Coordinates:

AS1: 38.2321942, -97.7747681 OBW1: 38.2321680, -97.7747598 RECEIVED FEB 21 2019 BUREAU OF WATER

VEW1: 38.2321918, -97.7747349 VOBW1: 38.2321649, -97.7747292