

WATER WELL RECORD Form WWC-5

Original Record Correction Change in Well Use

Division of Water Resources App. No.

MW7

Well ID

1 LOCATION OF WATER WELL: County: Rice	Fraction NE ¼ NE ¼ NE ¼ SW ¼	Section Number 16	Township Number T 21 S	Range Number R 8 <input type="checkbox"/> E <input checked="" type="checkbox"/> W
--	---------------------------------	----------------------	---------------------------	--

2 WELL OWNER: Last Name: First: Business: Haldon's Inc. Address: 31 Basswood Lane Address: City: Sterling State: KS ZIP: 67579	Street or Rural Address where well is located (if unknown, distance and direction from nearest town or intersection): If at owner's address, check here: <p style="text-align: center;">909 N. Broadway, Sterling</p>
--	---

3 LOCATE WELL WITH "X" IN SECTION BOX:

N

NW	NE
SW	SE

S

1 mile

4 DEPTH OF COMPLETED WELL:15..... ft.

Depth(s) Groundwater Encountered: 1)8..... ft.
 2) ft. 3) ft., or 4) Dry Well

WELL'S STATIC WATER LEVEL:7.22..... ft.

below land surface, measured on (mo-day-yr).....12/31/18.....
 above land surface, measured on (mo-day-yr).....

Pump test data: Well water was ft.
 after hours pumping gpm
 Well water was ft.
 after hours pumping gpm

Estimated Yield:gpm

Bore Hole Diameter:8..... in. to15..... ft. and
 in. to ft.

5 Latitude:38.22382.....(decimal degrees)
Longitude:-98.20719.....(decimal degrees)
Horizontal Datum: WGS 84 NAD 83 NAD 27
Source for Latitude/Longitude:
 GPS (unit make/model: **Spectra Precision Epp**)
 (WAAS enabled? Yes No)
 Land Survey Topographic Map
 Online Mapper:

6 Elevation: **1644.08**.....ft. Ground Level TOC
Source: Land Survey GPS Topographic Map
 Other

7 WELL WATER TO BE USED AS:

1. Domestic: <input type="checkbox"/> Household <input type="checkbox"/> Lawn & Garden <input type="checkbox"/> Livestock 2. <input type="checkbox"/> Irrigation 3. <input type="checkbox"/> Feedlot 4. <input type="checkbox"/> Industrial	5. <input type="checkbox"/> Public Water Supply: well ID	10. <input type="checkbox"/> Oil Field Water Supply: lease
6. <input type="checkbox"/> Dewatering: how many wells?	11. Test Hole: well ID	12. Geothermal: how many bores?
7. <input type="checkbox"/> Aquifer Recharge: well ID	8. <input checked="" type="checkbox"/> Monitoring: well ID MW7	a) Closed Loop <input type="checkbox"/> Horizontal <input type="checkbox"/> Vertical
9. Environmental Remediation: well ID	<input type="checkbox"/> Air Sparge <input type="checkbox"/> Soil Vapor Extraction	b) Open Loop <input type="checkbox"/> Surface Discharge <input type="checkbox"/> Inj. of Water
<input type="checkbox"/> Recovery <input type="checkbox"/> Injection	13. <input type="checkbox"/> Other (specify):	

Was a chemical/bacteriological sample submitted to KDHE? Yes No If yes, date sample was submitted:

Water well disinfected? Yes No

8 TYPE OF CASING USED: Steel PVC Other CASING JOINTS: Glued Clamped Welded Threaded

Casing diameter2..... in. to5..... ft., Diameter in. to ft., Diameter in. to ft.

Casing height above land surface5.52..... in. Weight lbs./ft. Wall thickness or gauge No. **Sch. 40**.....

TYPE OF SCREEN OR PERFORATION MATERIAL:
 Steel Stainless Steel Fiberglass PVC Other (Specify)

Brass Galvanized Steel Concrete tile None used (open hole)

SCREEN OR PERFORATION OPENINGS ARE:
 Continuous Slot Mill Slot Gauze Wrapped Torch Cut Drilled Holes Other (Specify)

Louvered Shutter Key Punched Wire Wrapped Saw Cut None (Open Hole)

SCREEN-PERFORATED INTERVALS: From .5..... ft. to .15..... ft., From ft. to ft., From ft. to ft.

GRAVEL PACK INTERVALS: From .4..... ft. to .15..... ft., From ft. to ft., From ft. to ft.

9 GROUT MATERIAL: Neat cement Cement grout Bentonite Other **Concrete**.....


Grout Intervals: From0..... ft. to1..... ft., From1..... ft. to4..... ft., From ft. to ft.

Nearest source of possible contamination:
 Septic Tank Lateral Lines Pit Privy Livestock Pens Insecticide Storage
 Sewer Lines Cess Pool Sewage Lagoon Fuel Storage Abandoned Water Well
 Watertight Sewer Lines Seepage Pit Feedyard Fertilizer Storage Oil Well/Gas Well
 Other (Specify) **Contaminated site**.....

Direction from well? Distance from well? ft.

10 FROM	TO	LITHOLOGIC LOG	FROM	TO	LITHO. LOG (cont.) or PLUGGING INTERVALS
0	0.5	Concrete			
0.5	3	Hydro excavated			
3	5	Clay, silty, Brown			
5	8	Sand, vf-f, Brown			
8	15	Sand, vf-c w/tr. f gravel, Brown			
Notes:					

11 CONTRACTOR'S OR LANDOWNER'S CERTIFICATION: This water well was constructed, reconstructed, or plugged under my jurisdiction and was completed on (mo-day-year) **12/20/2018**.... and this record is true to the best of my knowledge and belief. Kansas Water Well Contractor's License No. **527**..... This Water Well Record was completed on (mo-day-year) **1/4/2019**..... under the business name of **GeoCore Inc.**..... Signature *[Signature]*.....

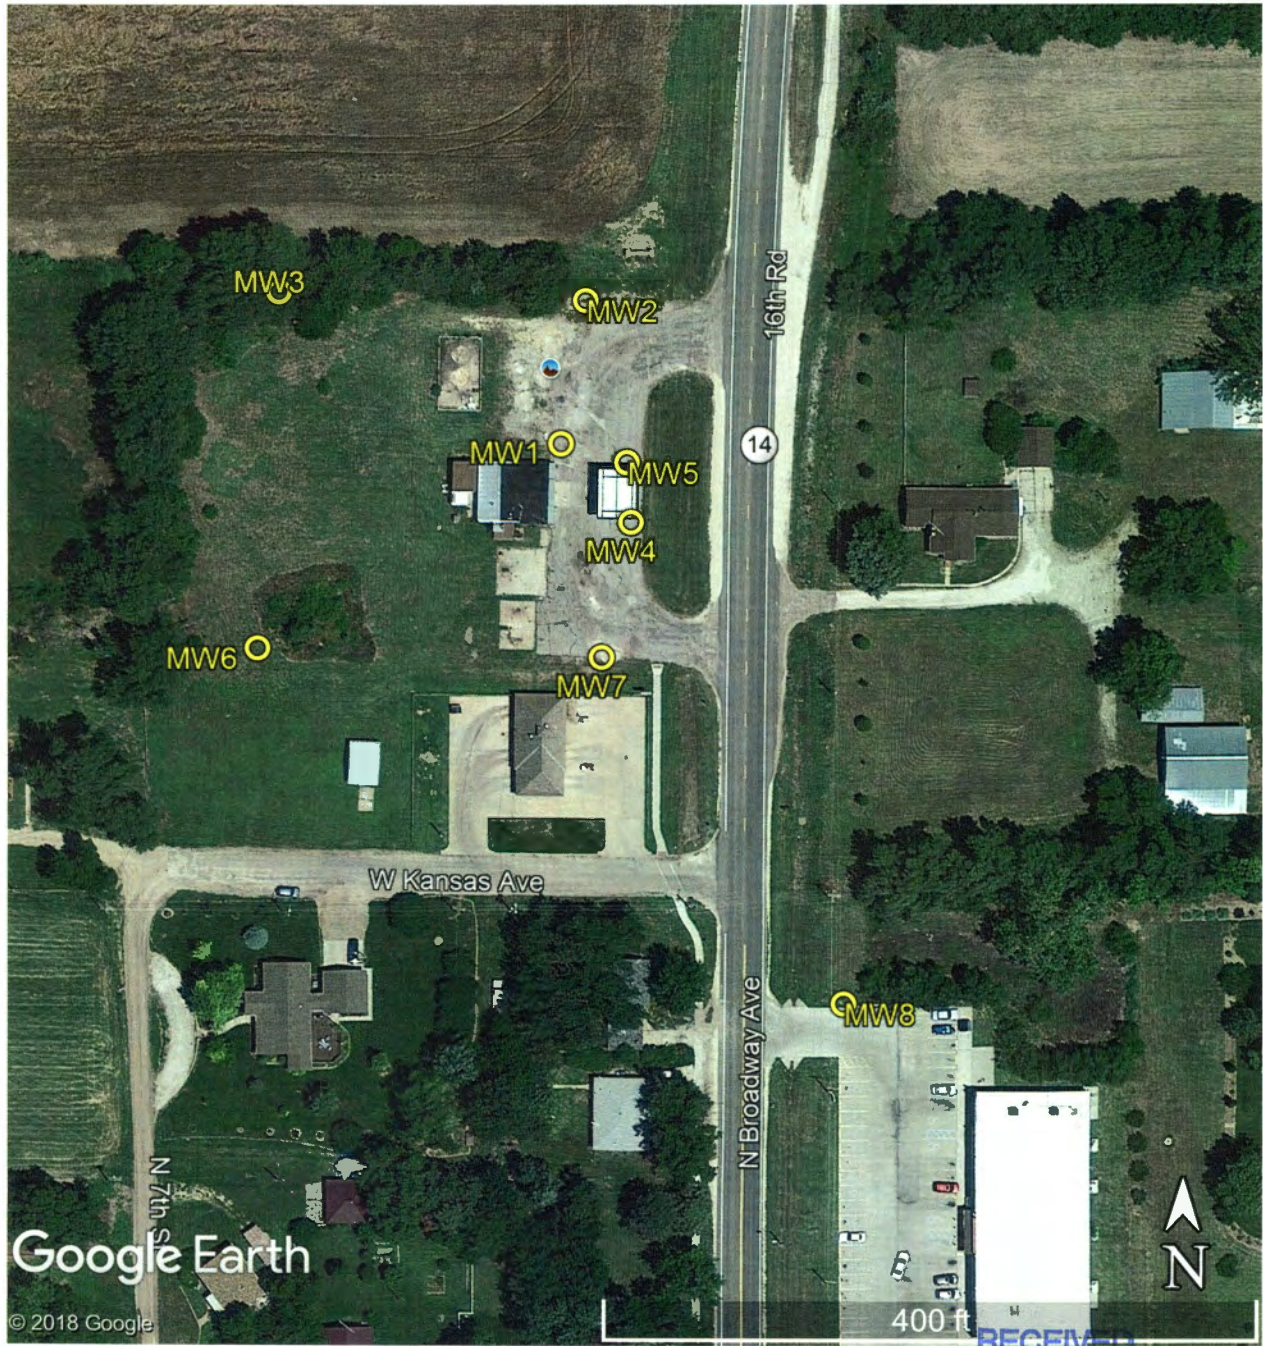

JAN 31 2019

BUREAU OF WATER

Haldon's Inc.
 909 N. Broadway, Sterling, Kansas
 KDHE #U5 080 14906

GPS Coordinates:

MW1: 38.22418, -98.20728
 MW2: 38.22442, -98.20723
 MW3: 38.22443, -98.20788
 MW4: 38.22405, -98.20713

MW5: 38.22415, -98.20714
 MW6: 38.22383, -98.20792
 MW7: 38.22382, -98.20719
 MW8: 38.22324, -98.20667