
| | WELL R | | rm WWC-5 | | | Division of Wa | | | *** *** | OW-1 | |
|---|----------------------|---------------------------------------|---|---------------------------------------|---|--|--|--------------------------|---|--------------|--|
| | l Record | | hange in Well U | se | | esources App. | | T 1: N 1 | Well ID | NT 1 | |
| | | ATER WELL: | Fraction | - 1/ NUA/1/ | | Section Numb | per | Township Numb | | ge Number | |
| | y: Reno | | | Ξ ¼ NW ½ | | 9 | | T 23 S | | □E■W | |
| 2 WELL | OWNER: L | ast Name: | First: | | | | | ere well is located | | | |
| Business: Farmland J Elevator direction from nearest town or intersection): If at owner's address, check her | | | | | | | | | | check here: | |
| | Address: 4th & Carey | | | | | | | | | | |
| City: | Hutchinso | | KS ZIP: 675 | | | | | | | | |
| 3 LOCAT | | | | | 05.54 | | | 00.00404 | | | |
| WITH " | | 4 DEPTH OF C | | | | | | | | | |
| 1 | ON BOX: | | | Encountered: 1) | | | Longitude: -97.882137 (decimal degrees) | | | | |
| | N | 2) f | t. 3) | ft., or 4)[| Dry Well | | | <u> Datum:</u> 🖷 WGS 84 | | 83 🗆 NAD 27 | |
| | | | WELL'S STATIC WATER LEVEL: 13.88 below land surface, measured on (mo-day-yr) | | | | 10/2020 | | | | |
| ' | ' | | | | _ == (================================= | | | | | | |
| NW | NE | | above land surface, measured on (mo-day-yr Pump test data: Well water was ft. | | | ······ (WAAS enabled? ☐ Yes ☐ No ☐ Land Survey ☐ Topographic Map | | | (o) | | |
| w - | <u> </u> | | after hours pumping g | | | | Survey Topogra | iphic Map | | | |
| 1 1 | Е | Well water was ft. | | | | m Online Mapper: | | | • | | |
| sw | SE | after hours pumpingg | | | | ALA | | | | | |
| X | | Estimated Yield gnm | | | | 6 Elevation: NAft. ☐ Ground Level ☐ TOC | | | | | |
| | S | Bore Hole Diameter: 8.75 in. to 25.51 | | | ft. and | d Source: ☐ Land Survey ■ GPS ☐ Topographic N | | | pographic Map | | |
| 1 1 | mile | | in. to ft. | | | | ☐ Other | | | | |
| 7 WELL WATER TO BE USED AS: | | | | | | | | | | | |
| 1. Domestic | | | c Water Supply: | well ID | | 10. 🔲 🤇 | Dil Fie | eld Water Supply: le | ase | | |
| ☐ House | hold | 6. 🔲 Dewa | atering: how man | ny wells? | | 11. Test | | : well ID | | | |
| ☐ Lawn & Garden 7. ☐ Aquifer Re | | | fer Recharge: we | charge: well ID g: well IDOW-1 | | | ☐ Cased ☐ Uncased ☐ Geotechnical | | | | |
| | | | | | | | 12. Geothermal: how many bores? | | | | |
| 2. Irrigation 9. Environmental Remediation: we | | | | | | | | | | | |
| | | | | Soil Vapor Extraction | | | b) Open Loop Surface Discharge Inj. of Water | | | | |
| 4. 🔲 Indust | | Reco | | | | | | (specify): | | | |
| Was a chemical/bacteriological sample submitted to KDHE? ☐ Yes ■ No If yes, date sample was submitted: | | | | | | | | | | | |
| Water well disinfected? ☐ Yes ■ No | | | | | | | | | | | |
| 8 TYPE OF CASING USED: ☐ Steel ☐ PVC ☐ Other CASING JOINTS: ☐ Glued ☐ Clamped ☐ Welded ☐ Threaded | | | | | | | | | | | |
| Casing diameter 2 in to 15.51 ft., Diameter in to ft., Diameter in to ft. Casing height above land surface 0 in. Weight lbs/ft. Wall thickness or gauge No. Sch 40 | | | | | | | | | | | |
| Casing height above land surface | | | | | | | | | | | |
| TYPE OF SCREEN OR PERFORATION MATERIAL: | | | | | | | | | | | |
| ☐ Steel ☐ Stainless Steel ☐ Fiberglass ■ PVC ☐ Other (Specify) | | | | | | | | | | | |
| ☐ Brass ☐ Galvanized Steel ☐ Concrete tile ☐ None used (open hole) | | | | | | | | | | | |
| SCREEN OR PERFORATION OPENINGS ARE: | | | | | | | | | | | |
| ☐ Continuous Slot ☐ Mill Slot ☐ Gauze Wrapped ☐ Torch Cut ☐ Drilled Holes ☐ Other (Specify) | | | | | | | | | | | |
| ☐ Louvered Shutter ☐ Key Punched ☐ Wire Wrapped ☐ Saw Cut ☐ None (Open Hole) | | | | | | | | | | | |
| SCREEN-PERFORATED INTERVALS: From .15.51 ft. to .25.51 ft., From ft. to ft., From ft. to ft. | | | | | | | | | | | |
| GRAVEL PACK INTERVALS: From13.51 ft. to .25.51 ft., From | | | | | | | | | | | |
| 9 GROUT MATERIAL: Neat cement Cement grout Bentonite Other. | | | | | | | | | | | |
| Grout Intervals: From | | | | | | | | | | | |
| Nearest source of possible contamination: Septic Tank | | | | | | | | | | | |
| | | | | Pit Privy | | Livestock P | | | ide Storage | | |
| Sewer | | Cess Po | | Sewage La | _ | Fuel Storag | | | ned Water V | Well | |
| □ Watertight Sewer Lines □ Seepage Pit □ Feedyard □ Fertilizer Storage □ Oil Well/Gas Well □ Other (Specify) □ Oil Well/Gas Well | | | | | | | | | | | |
| Direction from well? Distance from well? ft. | | | | | | | | | | | |
| 10 FROM | ТО | LITHO | LOGIC LOG | HOIII W | FROM | ТО | | HO. LOG (cont.) or | | TINTERVALE | |
| 0 | | ilt, dark brown, p | | | TAOM | 1 1 | | 200 (cont.) or | LUGGIN | 2 HATER VALO | |
| 5 | | layey Silt, brown | | · · · · · · · · · · · · · · · · · · · | | | <u> </u> | | | | |
| 10 | | lay, brown, plast | | · | | | | | | | |
| 16 | | and, brown, fine | | et claves | | | | | | | |
| - | | n part | to medium, w | ci, ciavey | | | - | | | | |
| 23 | | | fine to madi- | DO 11151 | | | | | | | |
| 20 | · | land, dark brown, | inte to mediu | ııı, wet, | NT - 4 | | i | | | | |
| clayey in part Notes: | | | | | | | | | | | |
| | | | | | | | | | | | |
| 11 CONTRACTOR'S OR LANDOW/NED/S CERTIFICATION. The second | | | | | | | | | | | |
| 11 CONTRACTOR'S OR LANDOWNER'S CERTIFICATION: This water well was constructed, \square reconstructed, or \square plugged under my jurisdiction and was completed on (mo-day-year) 5-18-2020 and this record is true to the best of my knowledge, and belief. | | | | | | | | | | | |
| Kansas Water Well Contractor's License No. 604 This Water Well Record was completed on (mo-day-year) | | | | | | | | | | | |
| under the h | usiness name | of Environment | al Priority Sen | , rms wa /ice_Inc | uci well K | ccord was co Signature | nupie | ica on (mo-day-ye | ai) .K/.K. | ٠٠٠ | |
| Mail | 1 white copy alor | ng with a fee of \$5.00 fe | or each constructed | well to: Kar | isas Denartm | ent of Health and | l Envi | ronment, Bureau of Wa | ter, GWTS S | ection. | |
| Mail 1 white copy along with a fee of \$5.00 for each constructed well to: Kansas Department of Health and Environment, Bureau of Water, GWTS Section, 1000 SW Jackson St., Suite 420, Topeka, Kansas 66612-1367. Mail one to Water Well Owner and retain one for your records. Telephone 785-296-5524. | | | | | | | | | | | |
| Visit us at http://www.kdheks.gov/waterwell/index.html KSA 82a-1212 Revised 7/10/2015 | | | | | | | | | | | |

9-T23-R5W



Dale Davis, PG \ Burns & McDonnell Senior Geologist o 816-823-6261 \ M 816-868-0298 \ F 816-822-3494

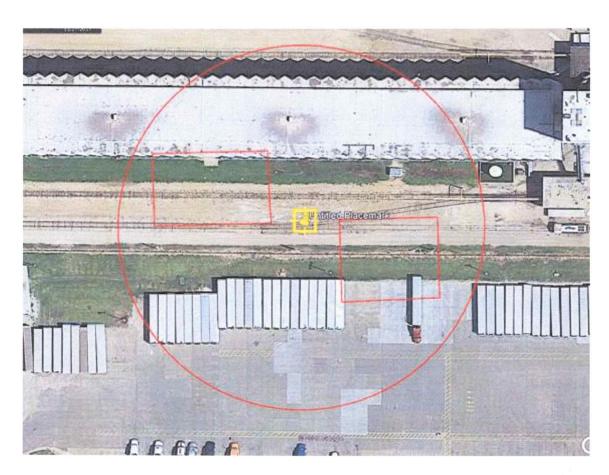