
WATER WELL R		WWC-5		sion of Water		BMW-15					
Original Record		ge in Well Use		urces App. No.		Well ID					
1 LOCATION OF W	ATER WELL:	Fraction		tion Number 33	Township Numb						
County: Edwards		NE 1/4 SW 1/4 NW 1/4	R 19 □ E ■ W								
2 WELL OWNER: L	ast Name:		Street or Rural Address where well is located (if unknown, distant								
Business: KDHE	Inches Of					er's address, check here:					
Address: 1000 SW Address:		of West 4th Street and									
City: Topeka	State: KS	ZIP:	Colony Ave., Kinsley, Ks.								
3 LOCATE WELL				1	07.000	20					
WITH "X" IN		4 DEPTH OF COMPLETED WELL: 20ft. 5 Latitude: 37.92528 (decimal degree									
SECTION BOX:		Encountered: 1)1!		Longitude: -99.41245 (decimal degrees)							
N		3) ft., or 4) □		Horizontal Datum: ■ WGS 84 □ NAD 83 □ NAD 27							
		TER LEVEL:		Source for Latitude/Longitude:							
		e, measured on (mo-day-		,							
NW NE		e, measured on (mo-day-		(WAAS enabled? ☐ Yes ☐ No)							
		water was ft rs pumping		Land Survey Topographic Map							
WE		water was fl		☐ Online Mapper:							
SWSE	1	rs pumping			0.07.40						
	Estimated Yield:		5P'''			t. 🗌 Ground Level 🔳 TOC					
S	Bore Hole Diameter:	8.75 in. to 20	. ft. and	Source:	■ Land Survey □	GPS					
1 mile	2010 11010 2141101011	in. to	ft.] Other						
7 WELL WATER TO											
1. Domestic:		ater Supply: well ID	••••	10. ☐ Oil Fi	eld Water Supply: 1	ease					
Household		ng: how many wells?			e: well ID						
☐ Lawn & Garden	7. 🗌 Aquifer I	Recharge: well ID			□ Uncased □						
☐ Livestock	8. Monitori	ng: well ID BMV	N15	12. Geothern	nal: how many bore	s?					
2. 🔲 Irrigation		tal Remediation: well ID			d Loop Horizon						
3. Feedlot	Air Sparg		extraction			ischarge Inj. of Water					
4. Industrial	☐ Recovery	☐ Injection		13. 🗌 Other	(specify):						
Was a chemical/bacter	riological sample subr	nitted to KDHE?	Yes No	If yes, date sa	mple was submitte	ed:					
Water well disinfected?				,	•						
		/C \(\sum \) Other	CASIN	IG JOINTS: [☐ Glued ☐ Clampe	d Welded Threaded					
8 TYPE OF CASING USED: Steel PVC Other											
Casing height above land surface 0 in. Weight lbs./ft. Wall thickness or gauge No. Sch 40.											
TYPE OF SCREEN OR PERFORATION MATERIAL:											
☐ Steel ☐ Stainless Steel ☐ Fiberglass ■ PVC ☐ Other (Specify)											
☐ Brass ☐ Galvanized Steel ☐ Concrete tile ☐ None used (open hole)											
SCREEN OR PERFORATION OPENINGS ARE:											
☐ Continuous Slot ■ Mill Slot ☐ Gauze Wrapped ☐ Torch Cut ☐ Drilled Holes ☐ Other (Specify)											
☐ Louvered Shutter ☐ Key Punched ☐ Wire Wrapped ☐ Saw Cut ☐ None (Open Hole)											
SCREEN-PERFORATED INTERVALS: From . 10 ft. to .20 ft., From ft., From ft., From ft. to ft.											
						ft. to ft.					
9 GROUT MATERIAL: Neat cement Cement grout Bentonite Other Cement pad											
Grout Intervals: From	1 ft. to 8	ft., FromQ	ft. to1	ft., From	ft. to	ft.					
Nearest source of possible	le contamination:										
☐ Septic Tank	Lateral Lin			Livestock Pens		icide Storage					
☐ Sewer Lines	Cess Pool			Fuel Storage		loned Water Well					
☐ Watertight Sewer Lines ☐ Seepage Pit ☐ Feedyard ☐ Fertilizer Storage ☐ Oil Well/Gas Well ☐ Other (Specify) .contaminated site											
Direction Community	ntaminated site	D:									
Direction from well?											
10 FROM TO	LITHOLO	GICLOG	FROM	10 11	THU. LUG (cont.) o	or PLUGGING INTERVALS					
	Gravel	http://www.									
	Clay, brown, soft, slig		-								
3 9	Silty Clay, gray to bro	wir, damp	-								
9 10	Sandy Clay, gray, mo	dist fuel odor									
10 20 5	Sand, gray, fine, wet										
			Notes:								
Salaria resala											
11 CONTRACTOR'S OR LANDOWNER'S CERTIFICATION: This water well was constructed, reconstructed, or plugged											
under my jurisdiction and was completed on (mo-day-year) .6/28/2022 and this record is true to the best of my knowledge and belief.											
Kansas Water Well Contractor's License No. 604. This Water Well Record was completed on (mo-day-year) . 1.2.2. under the business name of Environmental Pricrity Service, Inc. Signature											
under the business name of Environmental Pricrity Service, Inc. Signature											
	t., Suite 420, Topeka, Kansa				or your records. Telep	Revised 7/10/2015					
Visit us at http://www.kdheks	s.gov/waterwell/index.html		KSA 82a-12	14		Reviseu //10/2015					

TZ4 RI9W Sec. 33 KSA 8Za-1212 Edwards

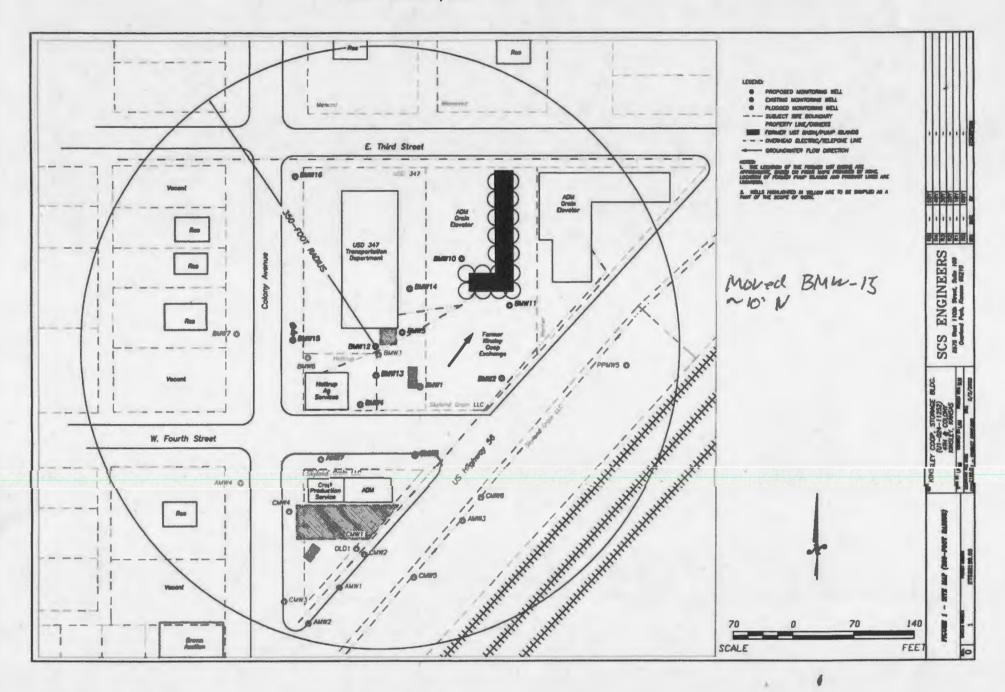

July 11, 2022

SCS Engineers Leah Meyer 6161 S. Syracuse Way, Suite 210 Greenwood Village, Colorado 80111

RE:

Project No. 2206-0238

Leah.

The following is the information requested on a Monitoring Well Site, Kinsley Coop, Storage Building, Kinsley, Edwards County, Kansas.

Point	North Coord.	East Coord.	Distance SE Cor. North	From S.33 West	Elev. Top Of Rim or PK Nail	elev. Top of PVC Pipe	Latitude North	Longitude West		
SE Corner	10000	40000								
S.33-T24S- R19W	10000	10000								
BMW15	14299.30	7876.99	4299.30	2123.01	2168.07	2167.42	37.92528	99.41245		
BMW16	14490.71	7878.99	4490.71	2121.01	2168.15	2167.61	37.92581	99.41245		
Site BM	14338.02	8086.49	4338.02	1913.51		SBM Elevation = 2168.74				

Description: Chiseled "X" on southwest corner of concrete slab at the southwest corner of the grain elevators.

BMW15 and BMW16 are in the:

NE% SW% NW% NE% S.33-T24S-R19W

If you have any questions, please do not hesitate in giving us a call.

Sincerely,

COLORADO SPRINGS 411 South Tejon Street, Suite i Colorado Springs, CO 80903

P: 719-465-2145

Tim Sloan, L.S.
SMH CONSULTANTS

DODGE CITY 707 3rd Avenue, Suite A Dodge City, KS 67801 P: 620-255-1952 MANHATTAN - HO 2017 Vanesta Place, Suite 110 Manhattan, KS 66503 P: 785-776-0541 KANSAS CITY 5201 Johnson Drive, Suite 405 Mission, KS 66205 P: 913-444-9615