

CORRECTION(S) TO WATER WELL RECORD (WWC-5)
(to rectify lacking or incorrect information)

Location listed as:

Section-Township-Range: _____

Fraction ($\frac{1}{4}$ $\frac{1}{4}$ $\frac{1}{4}$): _____

County: Harvey
Location ~~changed to~~:

24-245-3W

SW SW SW SE

Other changes: Initial statements: Sedgwick County

Changed to: Harvey County


Comments: _____

verification method: Latitude & longitude, KGS' "LEO" conversion tool,
and mapping tool on KGS website.

initials: ARL date: 3/21/2012

submitted by: Kansas Geological Survey, Data Resources Library, 1930 Constant Ave., Lawrence, KS 66047-3726
to: Kansas Dept of Health & Environment, Bureau of Water, 1000 SW Jackson, Suite 420, Topeka, KS 66612-1367.

1	LOCATION OF WATER WELL:	Fraction	Section Number	Township Number	Range Number																											
	County: SEDGWICK	SW 1/4 SW 1/4 SE 1/4	24	24 S	3 E-W																											
Distance and direction from nearest town or city street address of well if located within city? N 37.94145 N 97.60048																																
2	WATER WELL OWNER: City of Wichita 6016 S. Spring Lake Rd RR #, St. Address, Box #: Halstead, KS 67056 City, State, ZIP Code : Halstead, KS 67056																															
Board of Agriculture, Division of Water Resources Application Number:																																
3	MARK WELL'S LOCATION WITH AN "X" IN SECTION BOX:		4 DEPTH OF WELL 243 ft.																													
N W E SW SE S X			WELL'S STATIC WATER LEVEL 18.2 ft.																													
			WELL WAS USED AS:																													
			1 Domestic 2 Irrigation 3 Feedlot 4 Industrial 5 Public Water Supply 6 Oil Field Water Supply 7 Domestic (Lawn & Garden) 8 Air Conditioning 9 Dewatering 10 Monitoring Well 11 Injection Well 12 Other																													
			Was a chemical / bacteriological sample submitted to Department? Yes No X If yes, mo/day/yr sample was submitted																													
Water Well Disinfected: Yes X No																																
5	TYPE OF BLANK CASING USED:																															
1 Steel 2 PVC 3 RMP (SR) 4 ABS 5 Wrought 6 Asbestos-Cement 7 Fiberglass 8 Concrete Tile 9 Other (Specify below)																																
Blank casing diameter 18 in. Was casing pulled? Yes X No If yes, how much 4'																																
Casing height above or below land surface in.																																
6	GROUT PLUG MATERIAL: 1 Neat cement 2 Cement grout 3 Bentonite 4 Other																															
Grout Plug Intervals: From 24 ft. to 4 ft., From ft. to ft., From to ft.																																
What is the nearest source of possible contamination:																																
1 Septic tank 2 Sewer lines 3 Watertight sewer lines 4 Lateral lines 5 Cess pool 6 Seepage pit 7 Pit privy 8 Sewage lagoon 9 Feedyard 10 Livestock pens 11 Fuel storage 12 Fertilizer storage 13 Insecticide storage 14 Abandoned water well 15 Oil well/Gas well 16 Other (specify below) None Known																																
Direction from well? How many feet?																																
<table border="1" style="width:100%; border-collapse: collapse;"><thead><tr><th style="width:15%;">FROM</th><th style="width:15%;">TO</th><th style="width:70%;">PLUGGING MATERIALS</th></tr></thead><tbody><tr><td>243</td><td>24</td><td>Chlorinated Sand</td></tr><tr><td>24</td><td>4</td><td>Cement Grout</td></tr><tr><td>4</td><td>0</td><td>Native Soil</td></tr><tr><td> </td><td> </td><td> </td></tr><tr><td> </td><td> </td><td> </td></tr><tr><td> </td><td> </td><td> </td></tr><tr><td> </td><td> </td><td> </td></tr><tr><td> </td><td> </td><td> </td></tr></tbody></table>						FROM	TO	PLUGGING MATERIALS	243	24	Chlorinated Sand	24	4	Cement Grout	4	0	Native Soil															
FROM	TO	PLUGGING MATERIALS																														
243	24	Chlorinated Sand																														
24	4	Cement Grout																														
4	0	Native Soil																														
7	CONTRACTOR'S OF LANDOWNER'S CERTIFICATION: This water well was plugged under my jurisdiction and was completed on (mo/day/year) 9/2/11 and this record is true to the best of my knowledge and belief. Kansas Water Well Contractor's License No. This Water Well Record was completed on (mo/day/year) under the business name of LAYNE CHRISTENSEN COMPANY by (signature) CHAD NEMAN PROJECT MANAGER																															
INSTRUCTIONS: Use typewriter or ball point pen. Please press firmly and print clearly. Please fill in blanks, underline or circle the correct answers. Send top three copies to Kansas Department of Health and Environment, Bureau of Water, Geology Section, 1000 SW Jackson St., Ste. 420, Topeka, Kansas 66612-1367. Telephone: 785/296-5522. Send one to Water Well Owner and retain one for your records.																																

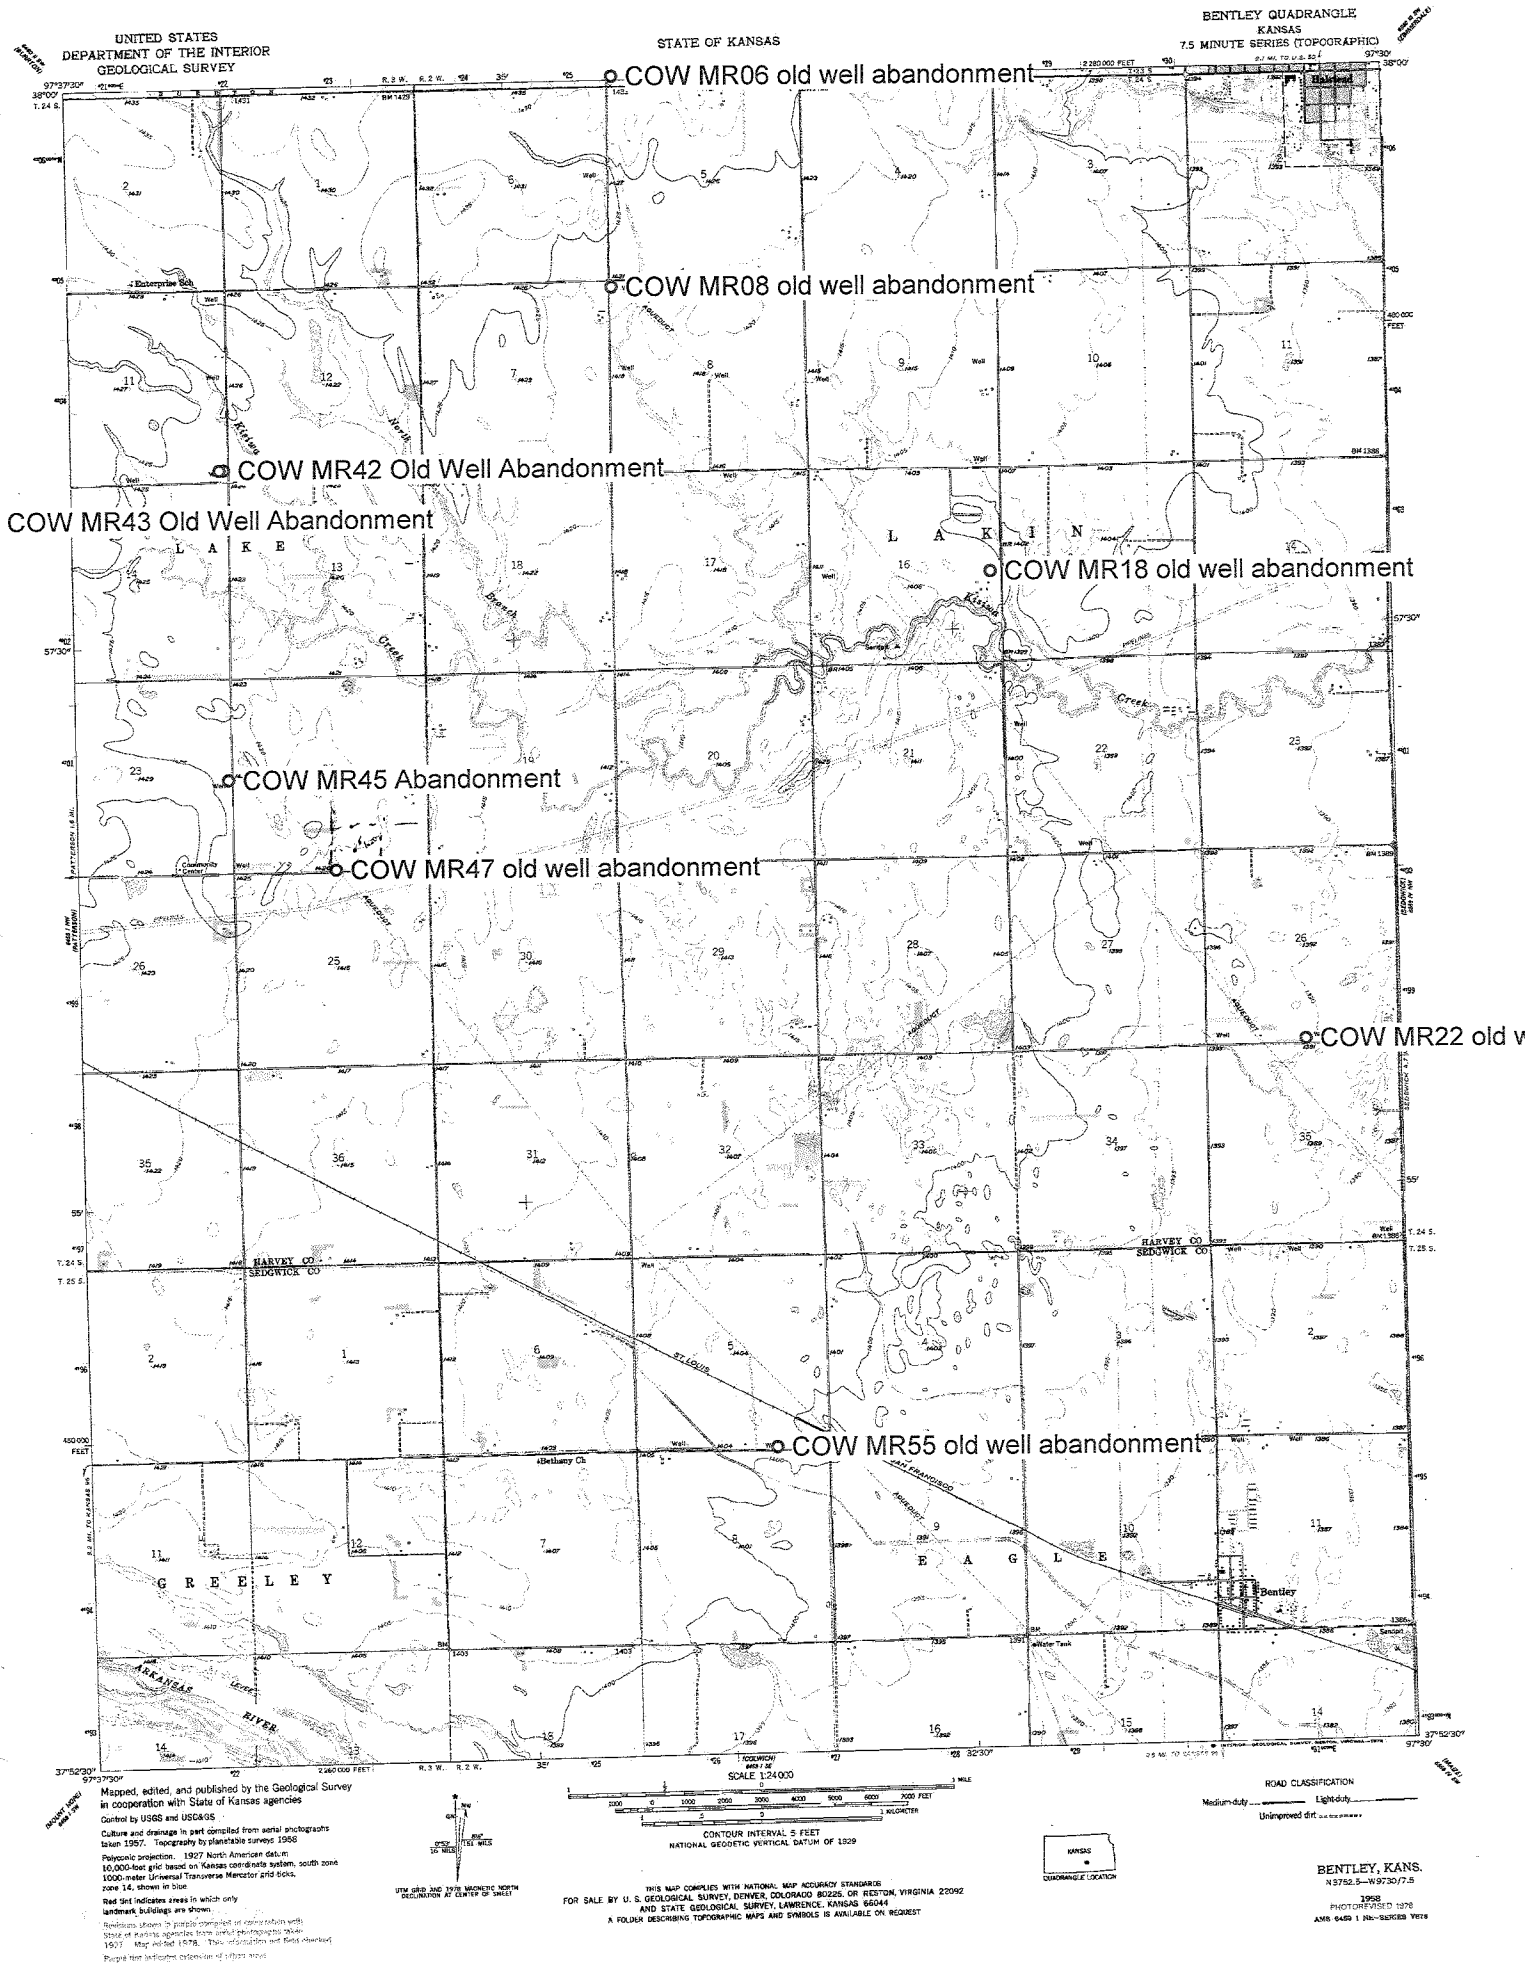

UNITED STATES
DEPARTMENT OF THE INTERIOR
GEOLOGICAL SURVEY

STATE OF KANSAS

BENTLEY QUADRANGLE
KANSAS
7.5 MINUTE SERIES (TOPOGRAPHIC)

COW MR43 Old Well Abandonment

COW MR06 old well abandonment

COW MR08 old well abandonment

COW MR42 Old Well Abandonment

COW MR18 old well abandonment

COW MR45 Abandonment

COW MR47 old well abandonment

COW MR22 old v

COW MR55 old well abandonment

Mapped, edited, and published by the Geological Survey
in cooperation with State of Kansas agencies
Control by USGS and USGARS
Culture and drainage in part compiled from aerial photographs
taken 1957. Topography by planimetric surveys 1958
Polyconic projection. 1927 North American datum
10,000-foot grid based on Kansas coordinate system, south zone
1000-meter Universal Transverse Mercator grid ticks,
zone 14, shown in blue
Red ink indicates areas in which only
landmark buildings are shown
Boundaries shown in purple compiled on correspondence with
State or Kansas agencies from aerial photographs taken
1957. Inter-related 1978. This information not field observed
Purple lines indicate extension of 1957 survey

UTM GRID AND 1978 MONETIC NORTH
REDUCTION OF CENTER OF GRAVITY

SCALE 1:24,000
CONTOUR INTERVAL 5 FEET
NATIONAL GEODETIC VERTICAL DATUM OF 1929

THIS MAP COMPLEYS WITH NATIONAL MAP ACCURACY STANDARDS
FOR SALE BY U.S. GEOLOGICAL SURVEY, DENVER, COLORADO 80225, OR RESTON, VIRGINIA 22092
AND STATE GEOLOGICAL SURVEY, LAWRENCE, KANSAS 66044
A FOLDER DESCRIBING TOPOGRAPHIC MAPS AND SYMBOLS IS AVAILABLE ON REQUEST

KANSAS
QUADRANGLE LOCATION

ROAD CLASSIFICATION
Medium-duty _____ Light-duty _____
Unimproved dirt _____

BENTLEY, KANS.
N 3750.5-W 9730.7/5
1958
PHOTOGRAPHED 1978
AMS 645 1 140-32000-78