
		RECORD		WWC-5		ision of Wat		MNIZ		
				ge in Well Use		ources App. 1		Well ID		
1 LOCATION OF WATER WELL: County: Finney			Fraction							
				NE 1/4 SE 1/4 SE 1/4						
2 WELL OWNER: Last Name: First: Street or Rural Address where well is located (if unknown, distance and direction from nearest town or intersection): If at owner's address, check here:										
Business: Crop Production Services direction from nearest town or intersection): If at owner's address, check here:										
Address:										
City:	Garden	Citv	State: KS	ZIP: 67846						
3 LOCAT		4 DEPTH	OF COM	APLETED WELL: .	185 fi	5 Latit	ude: 37.9298	311(decimal degrees)		
WITH '					Encountered: 1) 146 ft.			34401 (decimal degrees)		
1	ON BOX: N		2) ft. 3) ft., or 4) 🔲 I			Horizontal Datum: ■ WGS 84 □ NAD 83 □ NAD 27				
		WELL'S ST	WELL'S STATIC WATER LEVEL: 146				e for Latitude/Longitude	le:		
'	'		below land surface, measured on (mo-day-yr).							
NW	NE		above land surface, measured on (mo-day-yr). Pump test data: Well water was ft.				(
w	 	1 .	after hours pumpinggpm			☐ Land Survey ☐ Topographic Map ☐ Online Mapper:				
1 1 1	E		Well water was ft.			— Опше маррег.				
sw	SE		after hours pumping gpm			(F)				
		Estimated Y	Estimated Yield: gpm			6 Elevation:ft. Ground Level TOC				
S Bore Hole			ole Diameter: 6 in. to 185 ft. an			Source: ☐ Land Survey ■ GPS ☐ Topographic Map ☐ Other				
1 mile in. to										
1. Domestic				ater Supply: well ID		10 🗆 0	il Field Water Supply:	lease		
House		5. ∟ 6. □] Public wa] Dewaterin	ng: how many wells?	•••••		Hole: well ID			
				echarge: well ID			Cased Uncased Geotechnical			
☐ Livest	☐ Livestock 8. ■ Monitorin			charge: well ID						
					Remediation: well ID a) Closed Loop Horiz					
3. ☐ Feedlot ☐ Air Sparge					apor Extraction b) Open Loop ☐ Surface Discharge [
4. Indust] Recovery							
Was a chemical/bacteriological sample submitted to KDHE? ☐ Yes ■ No If yes, date sample was submitted:										
Water well disinfected? ☐ Yes ■ No										
8 TYPE OF CASING USED: ☐ Steel ■ PVC ☐ Other										
Casing diameter 2 in. to 150 ft., Diameter in. to ft., Diameter in. to ft. Casing height above land surface 30 in. Weight 70 lbs./ft. Wall thickness or gauge No. SCH 40										
TYPE OF SCREEN OR PERFORATION MATERIAL:										
☐ Steel ☐ Stainless Steel ☐ Fiberglass ■ PVC ☐ Other (Specify)										
☐ Brass ☐ Galvanized Steel ☐ Concrete tile ☐ None used (open hole)										
SCREEN OR PERFORATION OPENINGS ARE:										
☐ Continuous Slot ☐ Mill Slot ☐ Gauze Wrapped ☐ Torch Cut ☐ Drilled Holes ☐ Other (Specify)										
□ Louvered Shutter □ Key Punched □ Wire Wrapped □ Saw Cut □ None (Open Hole)										
SCREEN-PERFORATED INTERVALS: From185										
9 CPOUT MATERIAL Next sement Coment grout Dentaria Codes										
9 GROUT MATERIAL: ■ Neat cement □ Cement grout □ Bentonite □ Other										
Nearest source of possible contamination:										
☐ Septic Tank ☐ Lateral Lines ☐ Pit Privy ☐ Livestock Pens ☐ Insecticide Storage										
Sewer		_	Cess Pool	☐ Sewage La		Fuel Storage		doned Water Well		
□ Watertight Sewer Lines □ Seepage Pit □ Feedyard □ Fertilizer Storage □ Oil Well/Gas Well ■ Other (Specify) N/A										
Direction from well?										
10 FROM	ТО	i	ITHOLO	GIC LOG	FROM	TO		or PLUGGING INTERVALS		
0	28	Sand								
28	44	Clay								
44	126	Sand								
126	157	Clay/Sand								
157	185	Clay								
					Notes:					
11 CONTRACTORS OF LANDOWNEDS CERTIFICATION. This was all to the state of the state										
11 CONTRACTOR'S OR LANDOWNER'S CERTIFICATION: This water well was constructed, reconstructed, or plugged under my jurisdiction and was completed on (mo-day-year) .6-12-1.7 and this record is true to the best of my knowledge and belief.										
Kansas W	ater Well Co	ontractor's Lie	ense No.	597 This Wa	iter Well Rec	cord was co	mpleted on Amo-day-	year) .7131.7		
under the l	business nar	ne of .C.ascac	te. Drilling	L	Si	gnatures	steve John	LON		
Mail I white copy along with a fee of \$5.00 for each constructed well to: Kansas Department of Health and Environment Jureau of Water, GWTS Section, 1000 SW Jackson St., Suite 420, Topeka, Kansas 66612-1367. Mail one to Water Well Owner and retain one for your records. Telephone 785-296-5524.										
							one for your records. Tele	phone 785-296-5524.		
Visit us at htt	tp://www.kdhe	ks.gov/waterwell/	index.html		KSA 82a-12	:12		Revised 7/10/2015		

Google Maps 2025 S Old Hwy 83

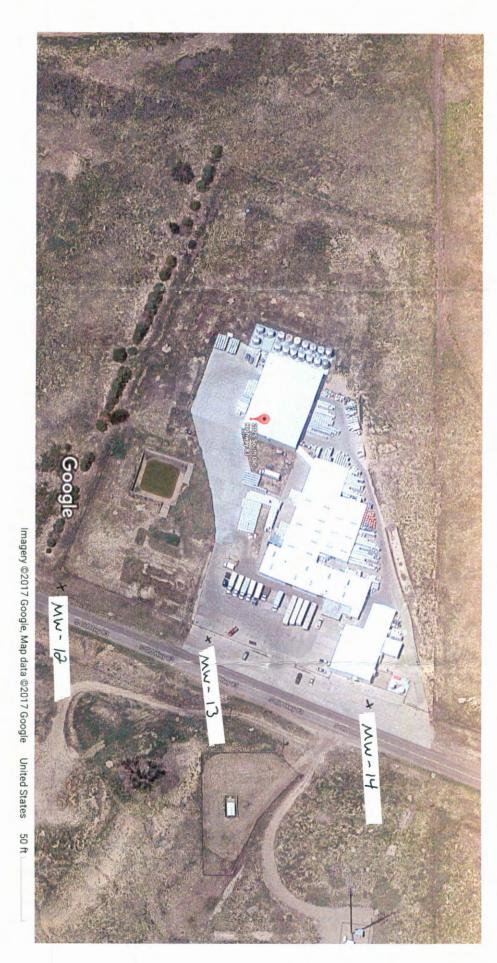

RECEIVED

BUREAU OF WATER