
		RECORD	Form <b>V</b>	WWC-5	Div	ision of Water		Wellin MW 13	
		Correction		e in Well Use		urces App. No		WCILID	
1 LOCAT	TON OF V	VATER WEL	L:	Fraction	1	tion Number			
	: Finney			NE 1/4 SE 1/4 SE 1/4				R 33 □E ■ W	
2 WELL OWNER: Last Name: First: Street or Rural Address where well is located (if unknown, distance and									
Business: Crop Production Services direction from nearest town or intersection): If at owner's address, check here:									
Address: 2025 South Old HWY 83 Address:									
City:	Garden (	City	State: KS	ZIP: 67846					
3 LOCATE WELL WITH "Y" IN 4 DEPTH OF COMPLETED WELL: 180 ft. 5 Latitude: 37.930550(decimal degrees)									
Double Coundwater Engagement 1) 146 th 1 to the 100 884030								4039 (decimal degrees)	
SECTIO				3) ft., or 4)				4 NAD 83 NAD 27	
l N		WELL'S ST	WELL'S STATIC WATER LEVEL:				Source for Latitude/Longitude:		
			below land surface, measured on (mo-day-yr)6-10-1				GPS (unit make/model: IPhone 5C)		
NW	NE		above land surface, measured on (mo-day-yr)			(,,,,,,,,,,,,,,,,,,,,,,,,,,,,,,,,,,,,,,			
		Pump test data: Well water was			☐ Land Survey ☐ Topographic Map				
W	Well wa								
				s pumping					
	Estimated Yield			ønm			6 Elevation:ft. ☐ Ground Level ☐ TOC Source: ☐ Land Survey ■ GPS ☐ Topographic Map		
1	S	Bore Hole I							
1 mile  in. to ft.									
7 WELL WATER TO BE USED AS: 1. Domestic: 5. Public Water Supply: well ID									
House									
							est Hole: well ID		
☐ Livestock 8. ■ Monitoring				g: well IDMW	ge: well ID Cased				
	2. ☐ Irrigation 9. Environmental Remediation: well					. a) Closed Loop			
3. Feedlot Air Sparge					extraction				
4. ☐ Industrial ☐ Recovery ☐ Injection 13. ☐ Other (specify):									
Was a chemical/bacteriological sample submitted to KDHE? ☐ Yes ■ No If yes, date sample was submitted:									
Water well disinfected? ☐ Yes ■ No									
8 TYPE OF CASING USED: ☐ Steel ■ PVC ☐ Other									
Casing diameter									
TYPE OF SCREEN OR PERFORATION MATERIAL:									
☐ Steel ☐ Stainless Steel ☐ Fiberglass ■ PVC ☐ Other (Specify)									
☐ Brass ☐ Galvanized Steel ☐ Concrete tile ☐ None used (open hole)									
SCREEN OR PERFORATION OPENINGS ARE:									
☐ Continuous Slot ☐ Mill Slot ☐ Gauze Wrapped ☐ Torch Cut ☐ Drilled Holes ☐ Other (Specify)									
☐ Louvered Shutter ☐ Key Punched ☐ Wire Wrapped ☐ Saw Cut ☐ None (Open Hole)									
SCREEN-PERFORATED INTERVALS: From180									
GRAVEL PACK INTERVALS: From 180 ft. to 146 ft., From ft. to ft., From ft. to ft., From ft. to ft.									
9 GROUT MATERIAL: Neat cement Cement grout Bentonite Other									
Nearest source of possible contamination:									
☐ Septic Tank ☐ Lateral Lines ☐ Pit Privy ☐ Livestock Pens ☐ Insecticide Storage									
Sewer Lines Cess Pool Sewage Lagoon Fuel Storage Abandoned Water Well									
	ight Sewer L		Seepage Pit			Fertilizer Stor	age	ell/Gas Well	
■ Other (Specify) .N/A.  Direction from well?									
10 FROM	TO		LITHOLO		FROM			or PLUGGING INTERVALS	
0	30	Sand		3.0 <u>1</u> 00	, ROM	- 10			
30	44	Clay							
44	112	Sand							
112	170	Clay/Sand							
170	180	Clay							
					Notes:				
44 CONVENION CONTRACTOR OF TAXABLE PROPERTY OF									
11 CONTRACTOR'S OR LANDOWNER'S CERTIFICATION: This water well was constructed, reconstructed, or plugged									
under my jurisdiction and was completed on (mo-day-year) .6-10-1.7 and this record is true to the best of my knowledge and belief.  Kansas Water Well Contractor's License No597 This Water Well Record was completed on (mo-day-year) .7-13-1.7									
under the business name of Cascade Drilling Signature Stave Johnson									
Mail 1 white copy along with a fee of \$5.00 for each constructed well to: Kansas Department of Health and Environment, Bureau of Water, GWTS Section,									
1000 SW Jackson St., Suite 420, Topeka, Kansas 66612-1367. Mail one to Water Well Owner and retain one for your records. Telephone 785-296-5524.									
Visit us at http://www.kdheks.gov/waterwell/index.html KSA 82a-1212 Revised 7/10/2015									

## Google Maps 2025 S Old Hwy 83

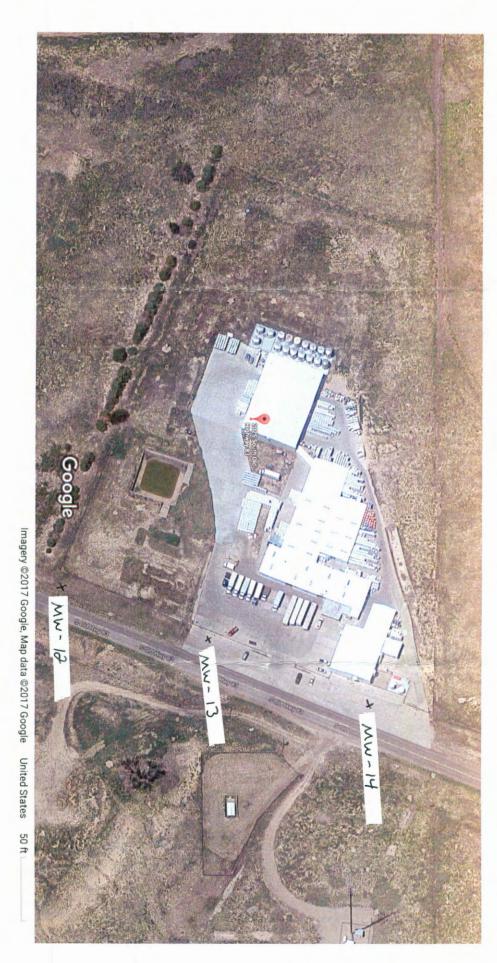

RECEIVED

BUREAU OF WATER