
			Form V				sion of Wate	I		MW 14	
Original Record Correction Chang						irces App. N			Well ID Range Number		
1 LOCATION OF WATER WELL: County: Finney			Fraction NE 1/4 SE 1/4 SE	Section Number Township Number 36 T 24 S					R 33 □ E ■ W		
		oot Nome:			Street or Rural Address where well is located (if unknown, distance and						
2 WELL OWNER: Last Name: First: Street or Rural Address where well is located (if unknown, distance a direction from nearest town or intersection): If at owner's address, check her											
Address: 2025 South Old HWY 83											
Address:											
City: Garden City State: KS ZIP: 67846											
3 LOCAT		4 DEPTH	OF COM	1PLETED WELL	:185	ft.	5 Latitu	ıde: 37.9	31263	(decimal degrees)	
WITH "		Depth(s) Gr	Encountered: 1)160 ft. Longitud				itude: 100	.88369	O(decimal degrees)		
1	N 2) ft.								GS 84 [☐ NAD 83 ☐ NAD 27	
WELL'S STATIC WA			TER LEVEL: 156 ft.				e for Latitude/Long	itude:	FC		
			measured on (mo-day-yr)6-8-17 measured on (mo-day-yr)						none 5C		
NW NE							(WAAS enable and Survey ☐ To				
w	w after hours			pumpinggpm							
CV	Well w				ater was ft.						
SW	anternours			pumping gpm				tion:	θГ	Ground Level TOC	
	Estimated Yield: Bore Hole Diameter:									S Topographic Map	
1								- =			
7 WELL WATER TO BE USED AS:											
1. Domestic:				ater Supply: well ID			10. □ Oi	il Field Water Supr	ly: lease	e	
☐ Household 6. ☐ Dewaterin			g: how many wells?		11. Test	11. Test Hole: well ID					
			echarge: well ID	A\A\ 4 A			ased Uncased				
							hermal: how many bores?				
2. ☐ Irrigati 3. ☐ Feedlo					l Remediation: well ID				rizontal ce Disch	☐ Vertical narge ☐ Inj. of Water	
4. Industr			Recovery			JII					
4. ☐ Industrial ☐ Recovery ☐ Injection ☐ 13. ☐ Other (specify):											
Water well disinfected? Yes No											
8 TYPE OF CASING USED: ☐ Steel ■ PVC ☐ Other											
Casing diameter 2 in to 155 ft. Diameter in to ft. Diameter in to ft.											
Casing diameter											
TYPE OF SCREEN OR PERFORATION MATERIAL:											
☐ Steel ☐ Stainless Steel ☐ Fiberglass ■ PVC ☐ Other (Specify)											
☐ Brass ☐ Galvanized Steel ☐ Concrete tile ☐ None used (open hole)											
SCREEN OR PERFORATION OPENINGS ARE:											
☐ Continuous Slot ☐ Mill Slot ☐ Gauze Wrapped ☐ Torch Cut ☐ Drilled Holes ☐ Other (Specify)											
SCREEN-PERFORATED INTERVALS: From185											
GRAVEL PACK INTERVALS: From 185 ft. to 151 ft., From ft. to ft., From ft. o ft.											
9 GROUT MATERIAL: Neat cement Cement grout Bentonite Other											
Grout Intervals: From											
Nearest source of possible contamination: □ Septic Tank □ Lateral Lines □ Pit Privy □ Livestock Pens □ Insecticide Storage											
			Lateral Line Cess Pool								
☐ Sewer Lines ☐ Cess Pool ☐ Sewage Lagoon ☐ Fuel Storage ☐ Abandoned Water Well ☐ Watertight Sewer Lines ☐ Seepage Pit ☐ Feedyard ☐ Fertilizer Storage ☐ Oil Well/Gas Well											
■ Other (Specify) .N/A. Direction from well?											
Direction fro	om well?			Distance from	well?						
10 FROM	TO		LITHOLO	GIC LOG	FR	OM	TO	LITHO. LOG (co	nt.) or PI	LUGGING INTERVALS	
0	36	Sand									
36	63	Clay									
63 80	91	Sand									
91	136	Clay Sand									
136	155	Clay									
155	185	Sand			Not	es:					
100	100	Jano				-51					
11 CONT	11 CONTRACTOR'S OR LANDOWNER'S CERTIFICATION: This water well was constructed, reconstructed, or plugged under my jurisdiction and was completed on (mo-day-year) .6-8-17										
under my j	urisdiction	and was comp	leted on (r	no-day-year) .6-8-	17	and t	his record	is true to the best	of my l	knowledge and belief.	
Kansas Wa	ater Well Co	ontractor's Lic	ense No de Drilling	マヌ1 This	water W	eli Reco	ord was co	mpleted on tmo-	iay-yeai Masan	r) .71317	
Mail	1 white copy a	long with a fee or	f \$5.00 for ea	ch constructed well to:	Kansas Der	artment	of Health and	Environment, Burea	u of Wate	r, GWTS Section,	
under the business name of Cascade Drilling. Mail 1 white copy along with a fee of \$5.00 for each constructed well to: Kansas Department of Health and Environment, Bureau of Water, GWTS Section, 1000 SW Jackson St., Suite 420, Topeka, Kansas 66612-1367. Mail one to Water Well Owner and retain one for your records. Telephone 785-296-5524.											
Visit us at http://www.kdheks.gov/waterwell/index.html KSA 82a-1212 Revised 7/10/2015											

Google Maps 2025 S Old Hwy 83

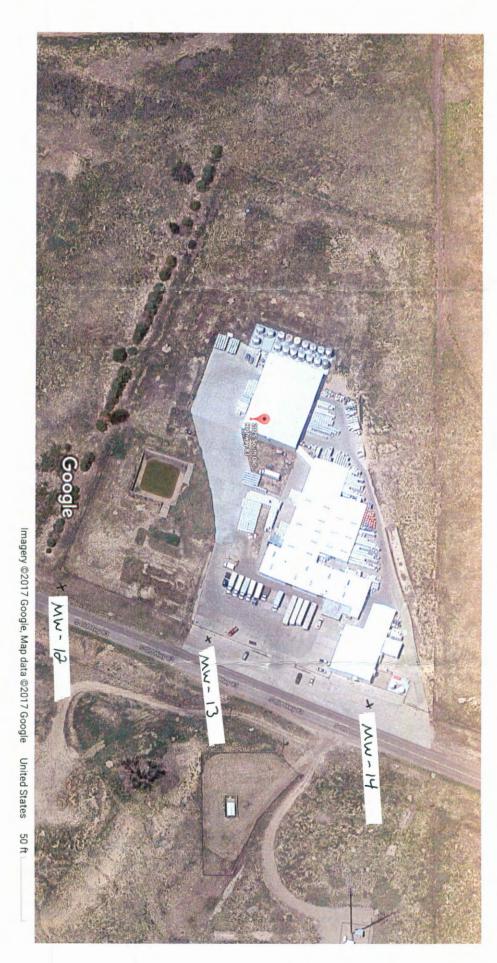

RECEIVED

BUREAU OF WATER