
WATER WELL F	_	WWC-5		ision of Water		AS1R		
Original Record		ge in Well Use		ources App. No.	I	Well ID		
1 LOCATION OF W	ATER WELL:	Fraction		tion Number 16	Township Numb			
County: Reno	NW 1/4 NE 1/4 NW 1/4 First:	1 21 3 12 1						
2 WELL OWNER: I Business: Central P	Street or Rural Address where well is located (if unknown, distance and							
Address: PO Box 6				irection from nearest town or intersection): If at owner's address, check here:				
Address: STN. Walli, Faithuge								
City: Nickerson State: KS ZIP: 67561								
3 LOCATE WELL	4 DEPTH OF CO	5 Latitude	37,9694	(desimal degrees)				
WITH "X" IN	Doubles Committee Francisco 1 27				.42 ft. 5 Latitude: 37.96943 (decimal degrees) Longitude: -98.09343 (decimal degrees)			
SECTION BOX:	2) ft. 3) ft., or 4)				Dry Well Horizontal Datum: WGS 84 NAD 83 NAD 27			
WELL'S STATIC WATER LEVEL:				ft. Source for Latitude/Longitude:				
below land surface, measured on (mo-day-y				····· GPS (unit make/model:)				
NW NE	above land surface, measured on (mo-day-y			1	(WAAS enabled? □			
Pump test data: Well water was				■ Land Survey □ Topographic Map □ Online Mapper:				
Well water was ft					ie Mapper:			
SW SE after hours pumping g					4040.04			
	Estimated Yield:gpm			6 Elevation:ft. Ground Level TOC				
Bore Hole Diameter:8 in. to42								
1 mile in. to ft.								
7 WELL WATER TO BE USED AS: 1. Domestic: 5. □ Public Water Supply: well ID								
1. Domestic: Household	5. ☐ Public W	ater Supply: well ID		10. ☐ Oil Fi	eld Water Supply: le	ease		
☐ Lawn & Garden								
Livestock	☐ Livestock Adulter Recharge: Well ID							
2. ☐ Irrigation 9. Environmental Remediation: well ID:								
3. ☐ Feedlot ☐ Air Sparge ☐ Soil Vapor Ext								
4. Industrial	☐ Recovery	☐ Injection		13. 🗌 Other	(specify):			
Was a chemical/bacteriological sample submitted to KDHE? Yes No If yes, date sample was submitted:								
Water well disinfected? ☐ Yes ■ No								
8 TYPE OF CASING USED: ☐ Steel PVC ☐ Other CASING JOINTS: ☐ Glued ☐ Clamped ☐ Welded ■ Threaded								
8 TYPE OF CASING USED: ☐ Steel ☐ PVC ☐ Other								
Casing height above land surface								
TYPE OF SCREEN OR PERFORATION MATERIAL:								
☐ Steel ☐ Stainless Steel ☐ Fiberglass ☐ PVC ☐ Other (Specify) ☐ Brass ☐ Galvanized Steel ☐ Concrete tile ☐ None used (open hole)								
☐ Brass ☐ Galvanized Steel ☐ Concrete tile ☐ None used (open hole) SCREEN OR PERFORATION OPENINGS ARE:								
☐ Continuous Slot ■ Mill Slot ☐ Gauze Wrapped ☐ Torch Cut ☐ Drilled Holes ☐ Other (Specify)								
□ Louvered Shutter □ Key Punched □ Wire Wrapped □ Saw Cut □ None (Open Hole)								
SCREEN-PERFORATED INTERVALS: From .40								
GRAVEL PACK INTERVALS: From								
9 GROUT MATERIAL: ☐ Neat cement ☐ Cement grout ☐ Bentonite ☐ Other								
Grout Intervals: From								
Nearest source of possible contamination:								
□ Septic Tank □ Lateral Lines □ Pit Privy □ Livestock Pens □ Insecticide Storage □ Sewer Lines □ Cess Pool □ Sewage Lagoon □ Fuel Storage □ Abandoned Water Well								
□ Sewer Lines □ Cess Pool □ Sewage Lagoon □ Fuel Storage □ Abandoned Water Well □ Watertight Sewer Lines □ Seepage Pit □ Feedyard □ Fertilizer Storage □ Oil Well/Gas Well								
Other (Specify) Contaminated site.								
Direction from well?								
10 FROM TO	LITHOLO		FROM			PLUGGING INTERVALS		
0 4.5	Clay, silty, Brown							
	Sand, f-c, Lt. Brown							
	and, vf-c, Brown grdg to Red Brown			2				
	and, vf-c, Gray Brown							
35 42 5	Sand, vf-c, Brown to I	Red Brown						
			ļ.,					
Notes: KDHE Project Code A2-078-40201								
11 CONTRACTORS OR LANDOWNERS CERTIFICATION. This is the second of the se								
11 CONTRACTOR'S OR LANDOWNER'S CERTIFICATION: This water well was constructed, reconstructed, or plugged under my jurisdiction and was completed on (mo-day-year) 10/20/2021 and this record is true to the best of my knowledge and belief								
under my jurisdiction and was completed on (mo-day-year) 10/20/2021 and this record is true to the best of my knowledge and belief. Kansas Water Well Contractor's License No. 527 This Water Well Record was completed on (mo-day-year) 10/29/2021								
under the business name of GeoCore, LLC. Signature Wal Nebb.								
Mail 1 white copy along with a fee of \$5.00 for each constructed well to: Kansas Department of Health and Environment, Bureau of Water, GWTS Section,								
1000 SW Jackson St., Suite 420, Topeka, Kansas 66612-1367. Mail one to Water Well Owner and retain one for your records. Telephone 785-296-5524. Visit us at http://www.kdheks.gov/waterwell/index.html KSA 82a-1212 Revised 7/10/2015								
Visit us at http://www.kdheks	s.gov/waterwell/index.html		KSA 82a-12	12		Revised 7/10/2015		

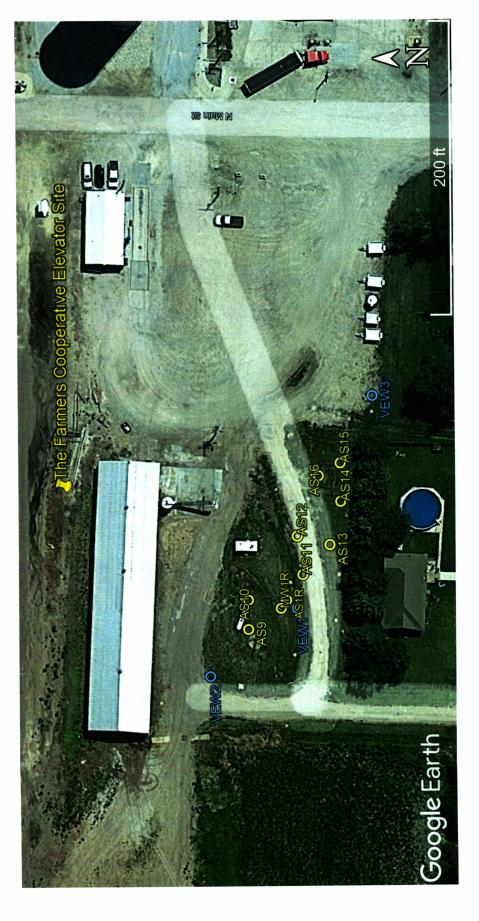

Project Site:

The Farmers Coop Elevator, 31 N. Main, Partridge

KDHE Project Code: A2-078-40201

GPS Coordinates:

37.96950, -98.09350 37.96950, -98.09343 37.96943, -98.09343 AS1R: AS9:

AS11: AS10:

37.96940, -98.09337 37.96941, -98.09328 AS12:

37.96935, -98.09330 37.96933, -98.09320 AS14: AS13:

37.96937, -98.09314 37.96933, -98.09311 AS16: AS15:

MW1R: 37.96944, -98.09345