
		RECORD		WWC-5		vision of Water	1		AS9	
		Correction	☐ Chang	ge in Well Use		ources App. No		Well ID	N7 1	
1 LOCATION OF WATER WELL: County: Reno				Fraction NW ¼ NE ¼ NW ½	Section Number Township Number 16 T 24 S				nge Number	
	OWNER:	I act Name:			NE ¼ 16 T 24 S R 7 □ E ■ W Street or Rural Address where well is located (if unknown, distance and					
Business	Central F	Prairie Co-op		First:	direction from nearest town or intersection): If at owner's address, check here:					
Address:	PO Box 6	3			31 N. Main, Partridge					
Address.										
City:	Nickerso	n	State: KS	ZIP: 67561						
3 LOCAT				APLETED WELL:						
1	SECTION BOY. Depth(s) Groundwater Encountered: 1)					2/ ft. Longitude: -98.09350 (decimal degrees)				
	N	2)	ft.	3) ft., or 4) TER LEVEL:	☐ Dry Well		ntal Datum: WGS 8		83 🗆 NAD 27	
	IXI			, measured on (mo-day			Source for Latitude/Longitude: GPS (unit make/model:)			
NW-	NE		above land surface, measured on (mo-day-y				(WAAS enabled?			
		Pump test of	lata: Well v	vater was	ft.	1	■ Land Survey ☐ Topographic Map			
W	E	after		s pumping			☐ Online Mapper:			
sw	SE	after	Well water was ft. after hours pumping gr							
		Estimated Yield:gpm				6 Elevation: 1610.88ft. ■ Ground Level □ TOC				
	S	Bore Hole	Bore Hole Diameter:8 in. to45			ft. and Source: Land Survey GPS Topographic Map			opographic Map	
mile in. to ft. Uther										
7 WELL WATER TO BE USED AS:										
1. Domestic		5.	Public Wa	ater Supply: well ID			Field Water Supply: 1			
_	☐ Household 6. ☐ Dewatering: how many ☐ Lawn & Garden 7. ☐ Aquifer Recharge: wel				11. Test Hole: well ID					
_	☐ Livestock Aquite Recharge: Well ID									
_	☐ Irrigation 9. Environmental Remediation: well					a) Closed Loop Horizontal Vertical				
	3. ☐ Feedlot ☐ Air Sparge ☐ Soil Va					b) Open Loop Surface Discharge Inj. of Water				
4. ☐ Industrial ☐ Recovery ☐ Injection 13. ☐ Other (specify):										
Was a chemical/bacteriological sample submitted to KDHE? ☐ Yes ■ No If yes, date sample was submitted:										
Water well disinfected? ☐ Yes ■ No										
8 TYPE OF CASING USED: ☐ Steel ☐ PVC ☐ Other										
8 TYPE OF CASING USED: ☐ Steel ☐ PVC ☐ Other										
Casing height above land surface										
☐ Steel ☐ Stainless Steel ☐ Fiberglass ■ PVC ☐ Other (Specify)										
☐ Brass ☐ Galvanized Steel ☐ Concrete tile ☐ None used (open hole)										
SCREEN OR PERFORATION OPENINGS ARE:										
☐ Continuous Slot ☐ Mill Slot ☐ Gauze Wrapped ☐ Torch Cut ☐ Drilled Holes ☐ Other (Specify)										
□ Louvered Shutter □ Key Punched □ Wire Wrapped □ Saw Cut □ None (Open Hole)										
SCREEN-PERFORATED INTERVALS: From 40										
GRAVEL PACK INTERVALS: From 38 ft. to 45 ft., From ft. to ft., From ft. to ft.										
9 GROUT MATERIAL: ☐ Neat cement ☐ Cement grout ☐ Bentonite ☐ Other										
Nearest source of possible contamination:										
☐ Septic Tank ☐ Lateral Lines ☐ Pit Privy ☐ Livestock Pens ☐ Insecticide Storage										
☐ Sewer Lines ☐ Cess Pool ☐ Sewage Lagoon ☐ Fuel Storage ☐ Abandoned Water Well										
□ Watertight Sewer Lines □ Seepage Pit □ Feedyard □ Fertilizer Storage □ Oil Well/Gas Well ■ Other (Specify) Contaminated site										
Direction from well?										
10 FROM	TO		LITHOLOG		FROM		LITHO. LOG (cont.) or		GINTERVALS	
0		Clay, silty, B	rown							
9.5	20	Sand, f-c, Lt	. Brown							
20		Sand, vf-c, L								
30		Sand, vf-c, C								
33		Sand, vf-c, E								
42	45	Clay, v. sl. s	ilty, Red B	Brown	1					
Notes: KDHE Project Code A2-078-40201										
11 CONTRACTOR'S OR LANDOWNER'S CERTIFICATION: This water well was constructed, reconstructed, or plugged										
under my jurisdiction and was completed on (mo-day-year) .10/.18/2021 and this record is true to the best of my knowledge and belief.										
Kansas Water Well Contractor's License No. 527 This Water Well Record was completed on (mo day-year) 10/29/2021										
under the business name of GeoCore, LLC Signature Walk Kelf										
Mail 1 white copy along with a fee of \$5.00 for each constructed well to: Kansas Department of Health and Environment, Bureau of Water, GWTS Section, 1000 SW Jackson St., Suite 420, Topeka, Kansas 66612-1367. Mail one to Water Well Owner and retain one for your records. Telephone 785-296-5524.										
	Visit us at http://www.kdheks.gov/waterwell/index.html KSA 82a-1212 Revised 7/10/2015									

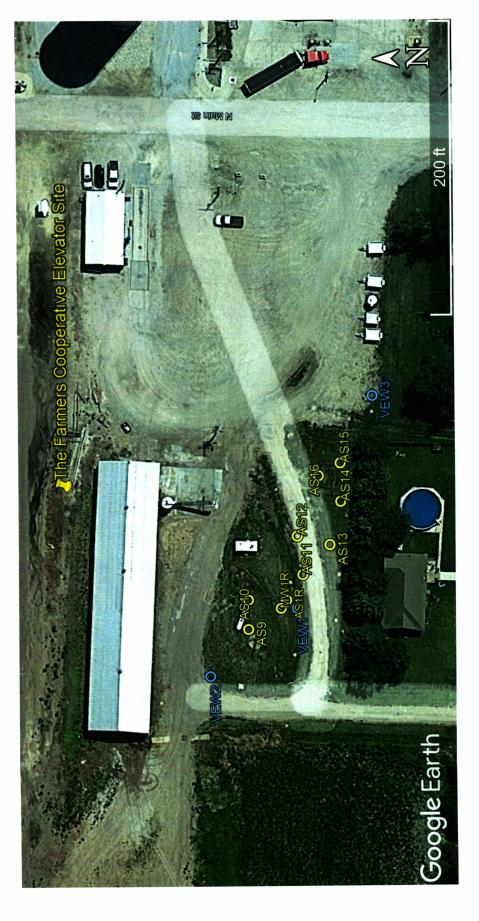

Project Site:

The Farmers Coop Elevator, 31 N. Main, Partridge

KDHE Project Code: A2-078-40201

GPS Coordinates:

37.96950, -98.09350 37.96950, -98.09343 37.96943, -98.09343 AS1R: AS9:

AS11: AS10:

37.96940, -98.09337 37.96941, -98.09328 AS12:

37.96935, -98.09330 37.96933, -98.09320 AS14: AS13:

37.96937, -98.09314 37.96933, -98.09311 AS16: AS15:

MW1R: 37.96944, -98.09345