


1 LOCATION OF WATER WELL: Fraction Section Number Township Number Range Number
 COUNTY: EDWARDS SE 1/4 NW 1/4 NW 1/4 26 T 25 S R 19 W

Distance and direction from nearest town or city street address of well if located within city?
 5 MILES SOUTH OF KINSLEY

2 WATER WELL OWNER: MILLER, JACK Board of Agriculture, Division of Water Resources
 RR#, St. Address, Box #: 314 NORTH COLONY
 City, State, ZIP code: KINSLEY, KS 67547- Application Number:

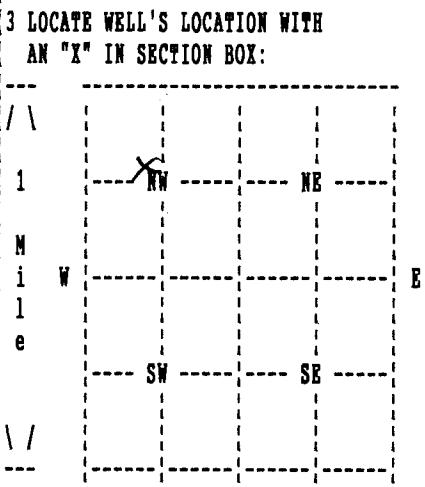

4 DEPTH OF COMPLETED WELL 87 ELEVATION: 0
 Depth(s) Groundwater Encountered 1. 0 ft. 2. 0 ft. 3. 0 ft.
 WELL'S STATIC WATER LEVEL 30 ft. below land surface measured on mo/day/yr 12/31/03
 Pump testdata: Well water was 0 ft. after 0 hours pumping 0 gpm
 Estimated Yield 0 gpm: Well water was 0 ft. after 0 hours pumping 0 gpm
 Bore Hole Diameter 8.75 in. to 87 ft., and in. to 0 ft.
 WELL WATER TO BE USED AS: LIVESTOCK
 Was a chemical/bacteriological sample submitted to department? No ;
 If yes, mo/day/yr sample was submitted Water well disinfected? Yes

5 TYPE OF BLANK CASING USED: PVC CASING JOINTS: GLUED
 Blank casing diameter 5 in. to 77 ft., Dia in. to 0 ft., Dia in. to 0 ft.
 Casing height above land surface 12 in., weight 0 lbs/ft. Wall thickness or gauge No. 26
 TYPE OF SCREEN OR PERFORATION MATERIAL: PVC
 SCREEN OR PERFORATION OPENINGS ARE: SAW CUT

SCREEN PERFORATED INTERVALS: From 77 ft. to 87 ft., From 0 ft. to 0 ft.
 From 0 ft. to 0 ft., From 0 ft. to 0 ft.
 GRAVEL PACK INTERVALS: From 25 ft. to 87 ft., From 0 ft. to 0 ft.
 From 0 ft. to 0 ft., From 0 ft. to 0 ft.

6 GROUT MATERIAL BENTONITE
 Grout Intervals: From 0 ft. to 25 ft., From 0 ft. to 0 ft., From 0 ft. to 0 ft.
 What is the nearest source of possible contamination: SEPTIC TANK
 Direction from well? SOUTHEAST How many feet? 1500

FROM	TO	LITHOLOGIC LOG	FROM	TO	PLUGGING INTERVALS
0	3	SILT AND SAND			
3	8	SAND			
8	45	SAND AND GRAVEL			
45	50	TAN CLAY			
50	75	SAND AND GRAVEL			
75	77	TAN CLAY			

7 CONTRACTOR'S OR LANDOWNER'S CERTIFICATION: This water well was Constructed under my jurisdiction and was completed on (mo/day/year) 12/31/03 and this record is true to the best of my knowledge and belief. Kansas Water Well Contractor's License No. 653A This Water Well Record was completed on (mo/day/yr) 12/31/03 under the business name of DAN HAYSE WATER WELL SVC. by (signature) Dan Hayse