


1 LOCATION OF WATER WELL: Fraction Section Number Township Number Range Number
 COUNTY: 029 FORD SE 1/4 SE 1/4 SW 1/4 10 T 25 S R 21 W

Distance and direction from nearest town or city street address of well if located within city?
 10 N, 2 E, OF BUCKLIN, KS

2 WATER WELL OWNER: TILLEY, TONY K. 151 Board of Agriculture, Division of Water Resources
 RR#, St. Address, Box #: RT.2
 City, State, ZIP code: BUCKLIN, KS 67834- Application Number:

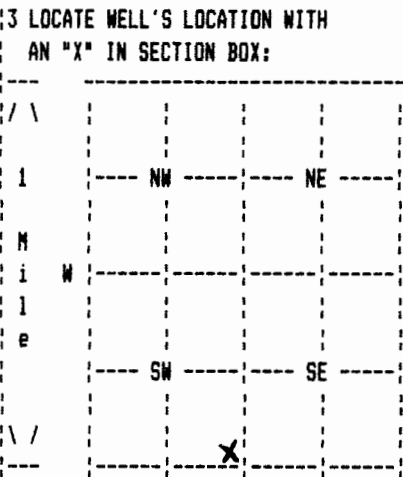

4 DEPTH OF COMPLETED WELL 22 ELEVATION:
 Depth(s) Groundwater Encountered 1. 11 ft. 2. ft. 3. ft.
 WELL'S STATIC WATER LEVEL 11 ft. below land surface measured on mo/day/yr
 Pump test data: Well water was ft. after hours pumping gpm
 Estimated Yield gpm: Well water was ft. after hours pumping gpm
 Bore Hole Diameter 12.5 in. to 22 ft., and in. to ft.
 WELL WATER TO BE USED AS: 01 DOMESTIC
 Was a chemical/bacteriological sample submitted to department? No;
 If yes, mo/day/yr sample was submitted Water well disinfected? Yes

5 TYPE OF BLANK CASING USED: 02 PVC CASING JOINTS: GLUED
 Blank casing diameter 5 in. to 17 ft., Dia in. to ft., Dia in. to ft.
 Casing height above land surface 12 in., weight lbs/ft. Wall thickness or gauge No. 26
 TYPE OF SCREEN OR PERFORATION MATERIAL: 07 PVC
 SCREEN OR PERFORATION OPENINGS ARE: 08 SAM CUT

SCREEN PERFORATED INTERVALS: From 17 ft. to 22 ft., From ft. to ft.
 GRAVEL PACK INTERVALS: From ft. to ft., From ft. to ft.
 From 15 ft. to 22 ft., From ft. to ft.
 From ft. to ft., From ft. to ft.

6 GROUT MATERIAL 03 BENTONITE
 Grout Intervals: From 4 ft. to 15 ft., From ft. to ft., From ft. to ft.
 What is the nearest source of possible contamination: 01 SEPTIC TANK
 Direction from well? SE How many feet? 90

FROM	TO	LITHOLOGIC LOG	FROM	TO	PLUGGING INTERVALS
	3	SILT & SAND			
3	18	05 SAND AND 17 GRAVEL			
18	22	TAN CLAY			

7 CONTRACTOR'S OR LANDOWNER'S CERTIFICATION: This water well was Constructed under my jurisdiction and was completed on (mo/day/year) 5 /30/92 and this record is true to the best of my knowledge and belief. Kansas Water Well Contractor's License No. 224 This Water Well Record was completed on (mo/day/yr) 06/16/92 under the business name of CARL HAYSE WATER WELL SVC by (signature) Carl Hayse