

USE TYPEWRITER OR BALL POINT PEN—PRESS FIRMLY, PRINT CLEARLY.

WATER WELL RECORD  
KSA 82a-1201-1215


Kansas Department of Health and Environment—Division of Environment  
(Water Well Contractors)  
Topeka, Kansas 66620

WRIGHT

1. Location of well: 70 Yards SE 1/4 SE 1/4 SW 1/4 I O T 26 S R 24 E/W

2. Distance and direction from nearest town or city: I 1/2 W, 1/2 N.  
Street address of well location if in city: of Wright,

3. Owner of well: Robert Slattery  
R.R. or street:  
City, state, zip code: Wright, Kansas 67882

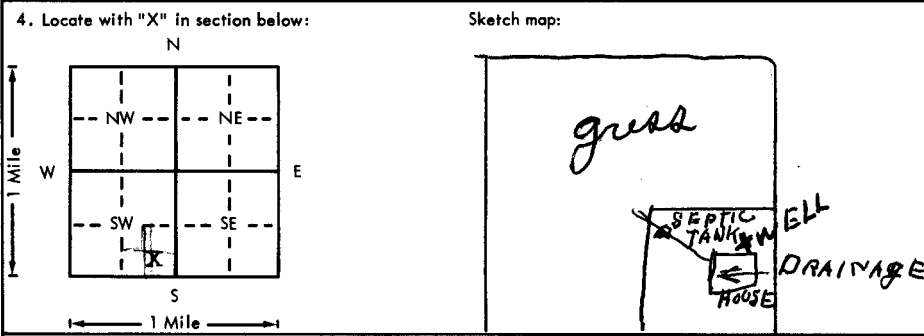

6. Bore hole dia. 8 in. Completion date 11-8-76  
Well depth 110 ft.

7.  Cable tool  Rotary  Driven  Dug  
 Hollow rod  Jetted  Bored  Reverse rotary

8. Use:  Domestic  Public supply  Industry  
 Irrigation  Air conditioning  Stock  
 Lawn  Oil field water  Other

9. Casing: Material Plastic Height: Above or below  
Threaded  Welded 81 Surface I 2 in.  
RMP  PVC  Weight \_\_\_\_\_ lbs./ft.  
Dia. 5 in. to 45 ft. depth Wall Thickness: inches or  
Dia. 55 in. to 75 ft. depth gage No. 250

5. Type and color of material	From	To
Topsoil	0	4
White Clay	4	27
White rock	27	39
Blue Clay	39	45
Sand	45	50
<del>White Clay</del>	<del>50</del>	<del>75</del>
<del>Fine Sand</del>	<del>75</del>	<del>95</del>
<del>Clay</del>	<del>95</del>	<del>110</del>
<del>NOT TO BLOCK</del>		

10. Screen: Manufacturer's name Sunflower Plastics, Pipe Inc.  
Type RMP Dia. 5 in  
Slot/gauze (1/16) Length 30  
Set between 45 ft. and 55 ft.  
75 ft. and 95 ft.  
Gravel pack?  Size range of material 4-1/8

11. Static water level: \_\_\_\_\_ mo./day/yr.  
40 ft. below land surface Date 10-6-76

12. Pumping level below land surfaces:  
45 ft. after 2 hrs. pumping 20 g.p.m.  
\_\_\_\_\_ ft. after \_\_\_\_\_ hrs. pumping \_\_\_\_\_ g.p.m.  
Estimated maximum yield 25 g.p.m.

13. Water sample submitted: \_\_\_\_\_ mo./day/yr.  
Yes  No  Date \_\_\_\_\_

14. Well head completion:  
 Pitless adapter I 2 inches above grade

15. Well grouted? Yes  
With:  Neat cement  Bentonite  Concrete  
Depth: From 3 ft. to 15 ft.

16. Nearest source of possible contamination: septic tank  
ft. 150 Direction W Type \_\_\_\_\_  
Well disinfected upon completion?  Yes  No

17. Pump: \_\_\_\_\_ Not installed  
Manufacturer's name Aermotor  
Model number SD-12 HP 1/2 Volts 220  
Length of drop pipe 84 ft. capacity 15 g.p.m.  
Type:  
 Submersible  Turbine  
 Jet  Reciprocating  
 Centrifugal  Other

18. Elevation: \_\_\_\_\_

19. Remarks: Concrete slab was installed  
TOPO 2494

20. Water well contractor's certification:  
This well was drilled under my jurisdiction and this report is true to the best of my knowledge and belief.  
Knoefler Bros. Drilling  
Business name \_\_\_\_\_ License No. \_\_\_\_\_  
Address Jetmore, I 30  
Signed Dale Knoefler Date 12-2-76  
Authorized representative

26 240 10 SE SE SW 1/4 1/4