

WATER WELL RECORD

Form WWC-5

Division of Water Resources App. No.


RFI 1

1 LOCATION OF WATER WELL: County: FORD	Fraction SW 1/4 SE 1/4 SW 1/4 SW 1/4	Section Number 25	Township No. T 26 S	Range Number R 25 <input type="checkbox"/> E <input checked="" type="checkbox"/> W
---	--	-----------------------------	-------------------------------	--

Street/Rural Address of Well Location; if unknown, distance & direction from nearest town or intersection: If at owner's address, check here .
600 East Trail Street, Dodge City, KS

Global Positioning System (GPS) information:
Latitude: **37.751442** (in decimal degrees)
Longitude: **100.011446** (in decimal degrees)
Elevation: _____
Datum: WGS 84, NAD 83, NAD 27
Collection Method:
 GPS unit (Make/Model: **iPhone 5C**)
 Digital Map/Photo, Topographic Map, Land Survey
Est. Accuracy: <3 m, 3-5 m, 5-15 m, >15 m

2 WATER WELL OWNER: Safety-Kleen Systems Inc. Brian Culnan
RR#, Street Address, Box #: **1050 North 3rd Street, Suite M**
City, State, ZIP Code : **Laramie, WY 82071**
307-742-6150

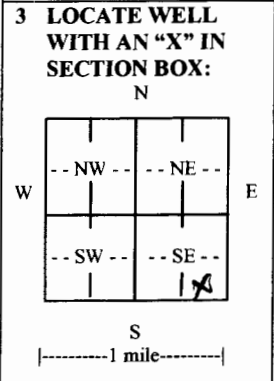

4 DEPTH OF COMPLETED WELL **28** ft.

Depth(s) Groundwater Encountered (1) **0** ft. (2) _____ ft. (3) _____ ft.

WELL'S STATIC WATER LEVEL **0** ft. below land surface measured on mo/day/yr. **7-16-16**

Pump test data: Well water was _____ ft. after _____ hours pumping _____ gpm

EST. YIELD _____ gpm. Well water was _____ ft. after _____ hours pumping _____ gpm

Bore Hole Diameter **6** in. to _____ ft., and _____ in. to _____ ft.

WELL WATER TO BE USED AS: Public water supply Geothermal Injection well
 Domestic Feedlot Oil field water supply Dewatering Other (Specify below)
 Irrigation Industrial Domestic-lawn & garden Monitoring well **RFI 1**

Was a chemical/bacteriological sample submitted to Department? Yes No
If yes, mo/day/yr sample was submitted: _____

Water well disinfected? Yes No

5 TYPE OF CASING USED: Steel PVC Other _____

CASING JOINTS: Glued Clamped Welded Threaded

Casing diameter **2** in. to **13** ft., Diameter _____ in. to _____ ft., Diameter _____ in. to _____ ft.
Casing height above land surface _____ in., Weight **70** lbs./ft., Wall thickness or gauge No. **SCH. 40**

TYPE OF SCREEN OR PERFORATION MATERIAL:
 Steel Stainless Steel PVC Other (Specify) _____
 Brass Galvanized Steel None used (open hole)

SCREEN OR PERFORATION OPENINGS ARE:
 Continuous slot Mill slot Gauze wrapped Torch cut Drilled holes None (open hole)
 Louvered shutter Key punched Wire wrapped Saw cut Other (specify) _____

SCREEN-PERFORATED INTERVALS: From **28** ft. to **13** ft., From _____ ft. to _____ ft.
From _____ ft. to _____ ft., From _____ ft. to _____ ft.

GRAVEL PACK INTERVALS: From **28** ft. to **11** ft., From _____ ft. to _____ ft.
From _____ ft. to _____ ft., From _____ ft. to _____ ft.

6 GROUT MATERIAL: Neat cement Cement grout Bentonite Other _____

Grout Intervals: From **9** ft. to **0** ft., From _____ ft. to _____ ft., From _____ ft. to _____ ft.


What is the nearest source of possible contamination:
 Septic tank Lateral lines Pit privy Livestock pens Insecticide storage Other (specify below)
 Sewer lines Cesspool Sewage lagoon Fuel storage Abandoned water well
 Watertight sewer lines Seepage pit Feedyard Fertilizer storage Oil well/gas well **Unknown**

Direction from well _____ Distance from well _____

FROM	TO	LITHOLOGIC LOG	FROM	TO	LITHO. LOG (cont.) or PLUGGING INTERVALS
0	2	Concrete			
2	10	Clay			
10	28	Sand			

7 CONTRACTOR'S OR LANDOWNER'S CERTIFICATION: This water well was constructed, reconstructed, or plugged under my jurisdiction and was completed on (mo/day/year) **7-16-16** and this record is true to the best of my knowledge and belief.
Kansas Water Well Contractor's License No. **597**. This Water Well Record was completed on (mo/day/year) _____ under the business name of **Cascade Drilling L.P.** by (signature) *[Signature]*

INSTRUCTIONS: Use typewriter or ball point pen. **PLEASE PRESS FIRMLY** and **PRINT** clearly. Please fill in blanks and check the correct answers. Send three copies (white, blue, pink) to Kansas Department of Health and Environment, Bureau of Water, Geology Section, 1000 SW Jackson St., Suite 420, Topeka, Kansas 66612-1367. Telephone 785-296-5522. Send one copy to WATER WELL OWNER and retain one for your records. Include fee of \$5.00 for each constructed well. Visit us at <http://www.kdheks.gov/waterwell/index.html>.

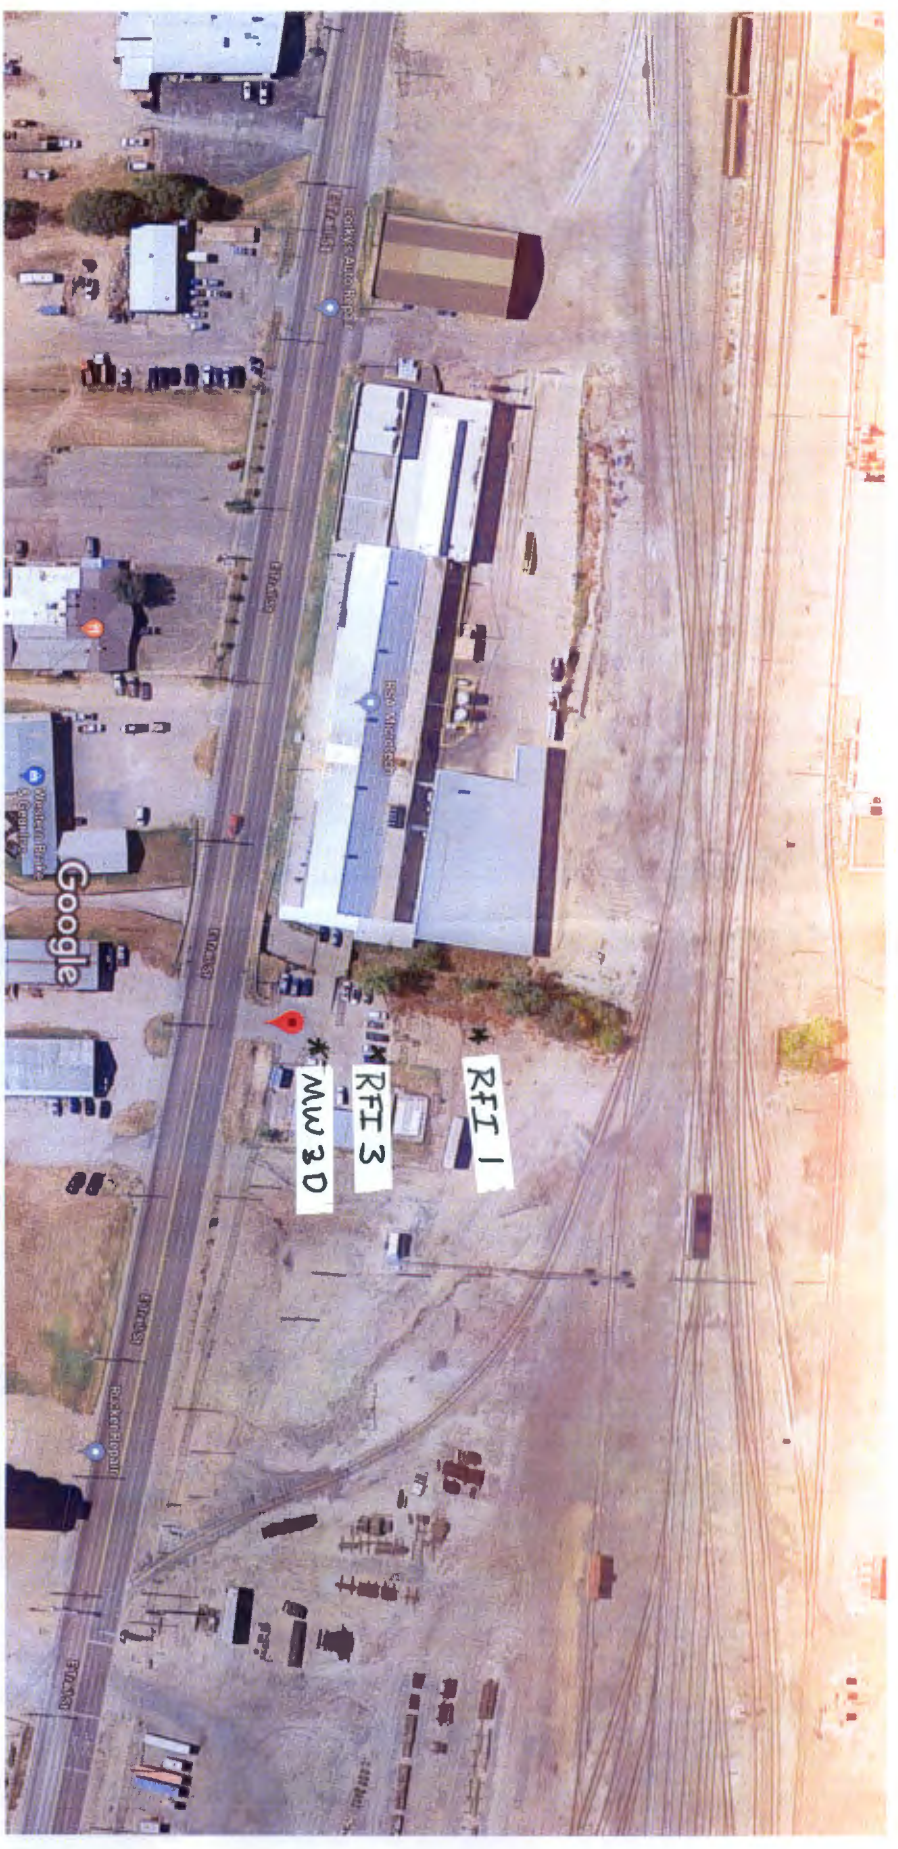

Imagery ©2018 Google, Map data ©2018 Google

50 ft