

WATER WELL RECORD Form WWC-5

Division of Water Resources App. No.

IAS-15

Original Record Correction Change in Well Use

Well ID

1 LOCATION OF WATER WELL: County: Sedgwick Fraction SE 1/4 NW 1/4 NE 1/4 NE 1/4 Section Number 20 Township Number T 27 S Range Number R 1 E W

2 WELL OWNER: Last Name: Business: KDHE BER Address: 1000 SW Jackson St., Ste. 410 City: Topeka State: KS ZIP: 66612 Street or Rural Address where well is located: Westlink Shopping Center, behind businesses at 8829-8999 W. Central Ave. - Wichita, KS

3 LOCATE WELL WITH 'X' IN SECTION BOX: N W E S 1 mile. 4 DEPTH OF COMPLETED WELL: 35 ft. 5 Latitude: 37.69239 Longitude: 97.44676 Elevation: 1331.29 ft. TOC

7 WELL WATER TO BE USED AS: 1. Domestic: 2. Irrigation 3. Feedlot 4. Industrial 5. Public Water Supply 6. Dewatering 7. Aquifer Recharge 8. Monitoring 9. Environmental Remediation 10. Oil Field Water Supply 11. Test Hole 12. Geothermal 13. Other


Was a chemical/bacteriological sample submitted to KDHE? Water well disinfected?

8 TYPE OF CASING USED: Steel PVC Other CASING JOINTS: Glued Clamped Welded Threaded Casing diameter 2 in. to 33 ft. TYPE OF SCREEN OR PERFORATION MATERIAL: Steel Stainless Steel PVC Other SCREEN OR PERFORATION OPENINGS ARE: Continuous Slot Mill Slot Gauze Wrapped Torch Cut Drilled Holes Other SCREEN-PERFORATED INTERVALS: From 33 ft. to 35 ft. GRAVEL PACK INTERVALS: From 30 ft. to 35 ft.

9 GROUT MATERIAL: Neat cement Cement grout Bentonite Other Grout Intervals: From 1 ft. to 30 ft. Nearest source of possible contamination: No potential source of contamination within 200 ft.

Table with 6 columns: FROM, TO, LITHOLOGIC LOG, FROM, TO, LITHO. LOG (cont.) or PLUGGING INTERVALS. Rows show lithology from 0 to 35 feet depth.

11 CONTRACTOR'S OR LANDOWNER'S CERTIFICATION: This water well was constructed, reconstructed, or plugged under my jurisdiction and was completed on (mo-day-year) 07/18/2019 and this record is true to the best of my knowledge and belief. Kansas Water Well Contractor's License No. 531 This Water Well Record was completed on (mo-day-year) 05/04/2020 under the business name of GSI Engineering, LLC

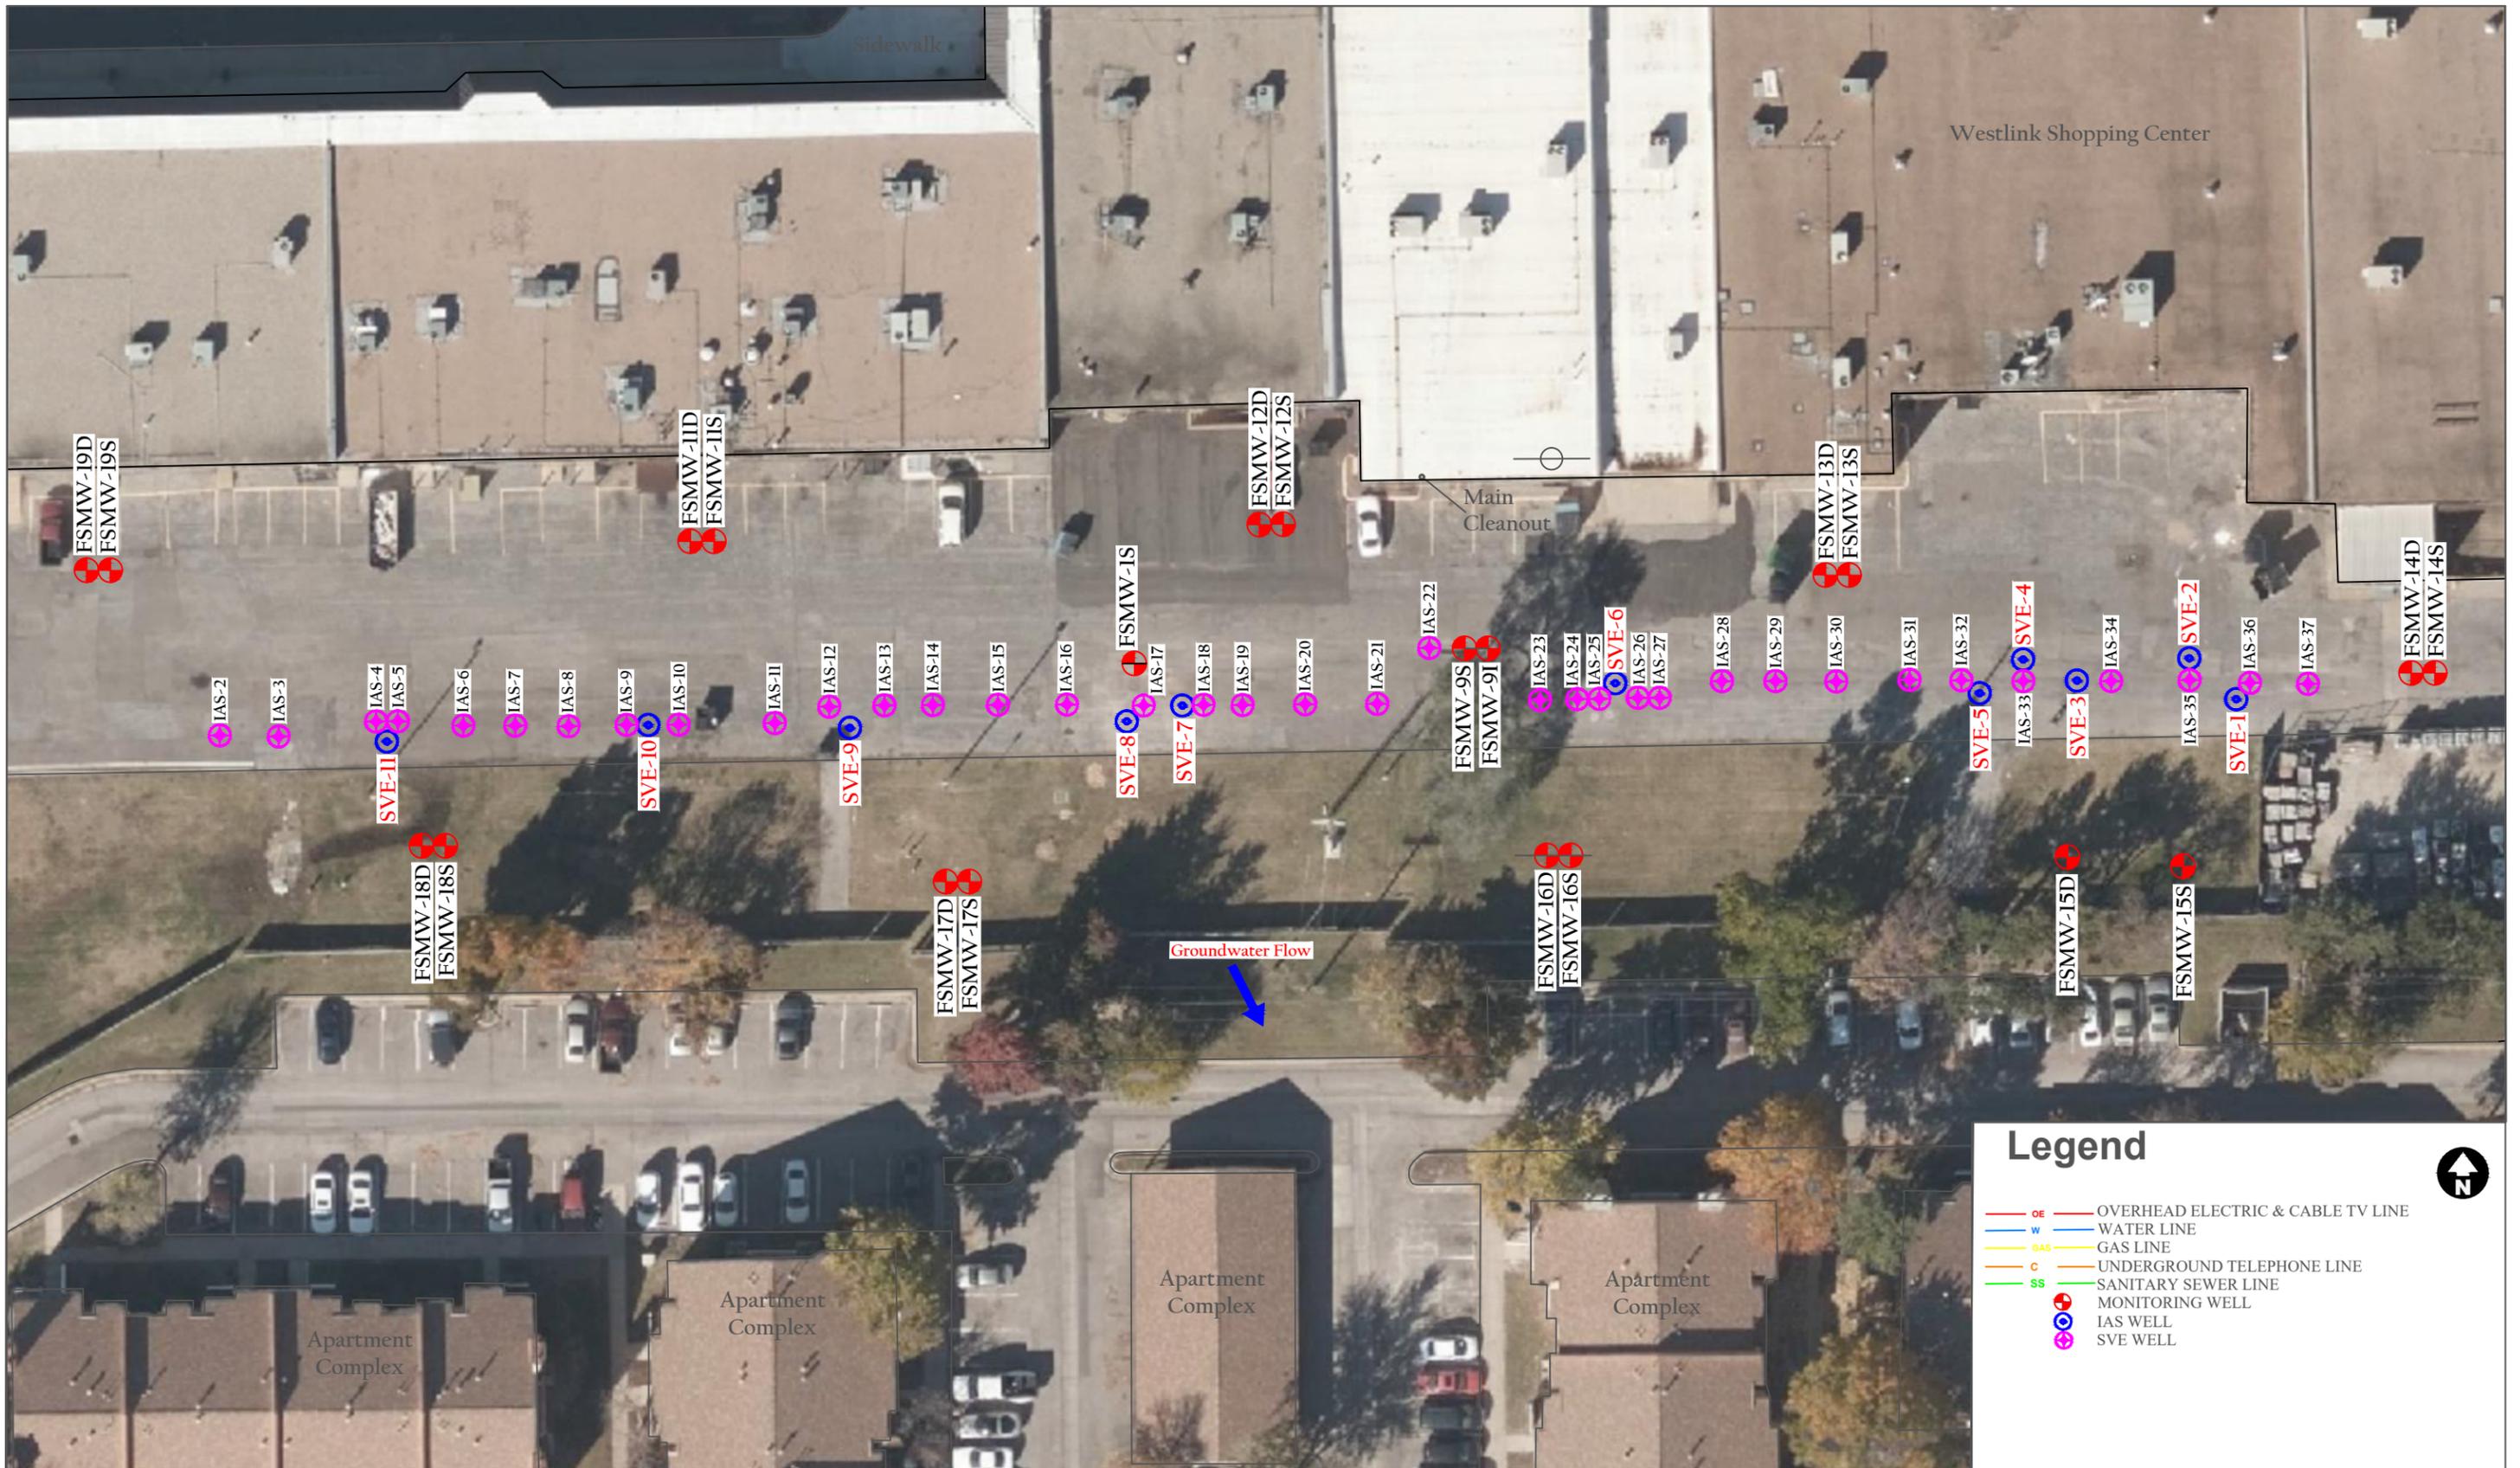


Legend

- OE OVERHEAD ELECTRIC & CABLE TV LINE
- W WATER LINE
- GAS GAS LINE
- C UNDERGROUND TELEPHONE LINE
- SS SANITARY SEWER LINE
- MONITORING WELL
- IAS WELL
- SVE WELL

	FIGURE: XX.XX	FIGURE NAME: SITE BASE MAP
	DATE: 02-07-20	PROJECT NUMBER: 1874118
	DRAWN BY: RN	PROJECT MANAGER: SGE

FORMER FOUR SEASONS
 8947 WEST CENTRAL
 WICHITA, KANSAS
 KDHE #: C2-087-73100

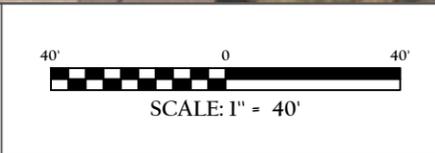

ALL LOCATIONS AND BOUNDARIES ARE APPROXIMATE