

NE SW NE SE

WATER WELL RECORD

Form WWC-5


KSA 82a-1212

1 LOCATION OF WATER WELL: County: Sedgwick	Fraction See Att. Map N.E. 1/4 OF S.E. 1/4	Section Number 20	Township Number T27 S	Range Number R1 West E(N)
---	---	----------------------	--------------------------	------------------------------

Distance and direction from nearest town or city street address of well if located within city?

City of Wichita-So 128.5ft West 185 ft. Westfield Acres Addition (See att. Map)

2 WATER WELL OWNER: H. K. Tatum RF#, St. Address, Box # : 156 North Byron Road City, State, ZIP Code : Wichita, KS 67212	Board of Agriculture, Division of Water Resources Application Number:
--	--

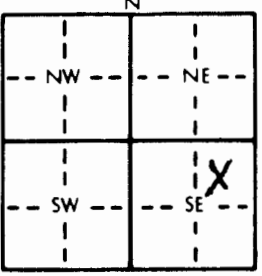3 LOCATE WELL'S LOCATION WITH AN "X" IN SECTION BOX: 	4 DEPTH OF COMPLETED WELL. 55ft 6 in. ft. ELEVATION: Unknown Depth(s) Groundwater Encountered 1. 24ft 5 in. ft. 2. ft. 3. ft. WELL'S STATIC WATER LEVEL 24ft 5 in. ft. below land surface measured on mo/day/yr 4-8-1991 Pump test data: Well water was NA. (No ft. after hours pumping gpm Est. Yield gpm: Well water was Test. run) ft. after hours pumping gpm Bore Hole Diameter in. to ft., and in. to ft. WELL WATER TO BE USED AS: 1 Domestic 3 Feedlot 6 Oil field water supply 9 Dewatering 12 Other (Specify below) 2 Irrigation 4 Industrial 7 Lawn and garden only 10 Monitoring well Was a chemical/bacteriological sample submitted to Department? Yes No X; If yes, mo/day/yr sample was submitted Water Well Disinfected? Yes X No
--	--


5 TYPE OF BLANK CASING USED: 1 Steel X (Galv 6") RMP (SR) 2 PVC 4 ABS Blank casing diameter All 6 in. to ft., Dia in. to ft., Dia in. to ft. Casing height above land surface 6 in. in., weight Unknown lbs./ft. Wall thickness or gauge No. Unknown	3 Wrought iron 8 Concrete tile CASING JOINTS: Glued Clamped 6 Asbestos-Cement 9 Other (specify below) Welded 7 Fiberglass Threaded XX TYPE OF SCREEN OR PERFORATION MATERIAL: 1 Steel 3 Stainless steel 5 Fiberglass 8 RMP (SR) 11 Other (specify) 2 Brass 4 Galvanized steel 6 Concrete tile 9 ABS 12 None used (open hole) SCREEN OR PERFORATION OPENINGS ARE: 1 Continuous slot 3 Mill slot 5 Gauzed wrapped 8 Saw cut 11 None (open hole) 2 Louvered shutter 4 Key punched 6 Wire wrapped 9 Drilled holes 7 Torch cut 10 Other (specify) SCREEN-PERFORATED INTERVALS: From 45ft 6 in. ft. to 55ft 6 in. ft., From ft. to ft. GRAVEL PACK INTERVALS: From NONE ft. to ft., From ft. to ft.
--	--

6 GROUT MATERIAL: 1 Neat cement 2 Cement grout 3 Bentonite 4 Other Grout Intervals: From Surface ft. to 5 ft. ft., From ft. to ft., From ft. to ft. What is the nearest source of possible contamination: 1 Septic tank 4 Lateral lines 7 Pit privy 10 Livestock pens 14 Abandoned water well 2 Sewer lines 5 Cess pool 8 Sewage lagoon 11 Fuel storage 15 Oil well/Gas well 3 Watertight sewer lines 6 Seepage pit 9 Feedyard 12 Fertilizer storage 16 Other (specify below) 13 Insecticide storage None known	Direction from well? How many feet?
---	-------------------------------------

FROM	TO	LITHOLOGIC LOG	FROM	TO	PLUGGING INTERVALS
		This 6 inch cased well was installed in the year 1955 to water garden & Lawn. It is no longer needed and was plugged 4-8-1991 in accordance with field demonstration instructions and in accordance with bulletin "Plugging Abandoned Wells" MF-935 Revised February 1990.			
		Little information is available, and the information above is believed to be as accurate as possible.			
		The well was pumped with a Berkley one-half HP Vertical shaft Jet Pump until it was abandoned (and a yard sprinkling system installed in 1990.)			

7 CONTRACTOR'S OR LANDOWNER'S CERTIFICATION: This water well was (1) constructed, (2) reconstructed, or (3) plugged under my jurisdiction and was completed on (mo/day/year) 4-8-1991 and this record is true to the best of my knowledge and belief. Kansas Water Well Contractor's License No. Done by Owner: This Water Well Record was completed on (mo/day/yr) 4-8-1991 under the business name of H.K. Tatum by (signature) H.K. Tatum
--

INSTRUCTIONS: Use typewriter or ball point pen. PLEASE PRESS FIRMLY and PRINT clearly. Please fill in blanks, underline or circle the correct answers. Send top three copies to Kansas Department of Health and Environment, Bureau of Water, Topeka, Kansas 66620-7320. Telephone: 913-296-5545. Send one to WATER WELL OWNER and retain one for your records.

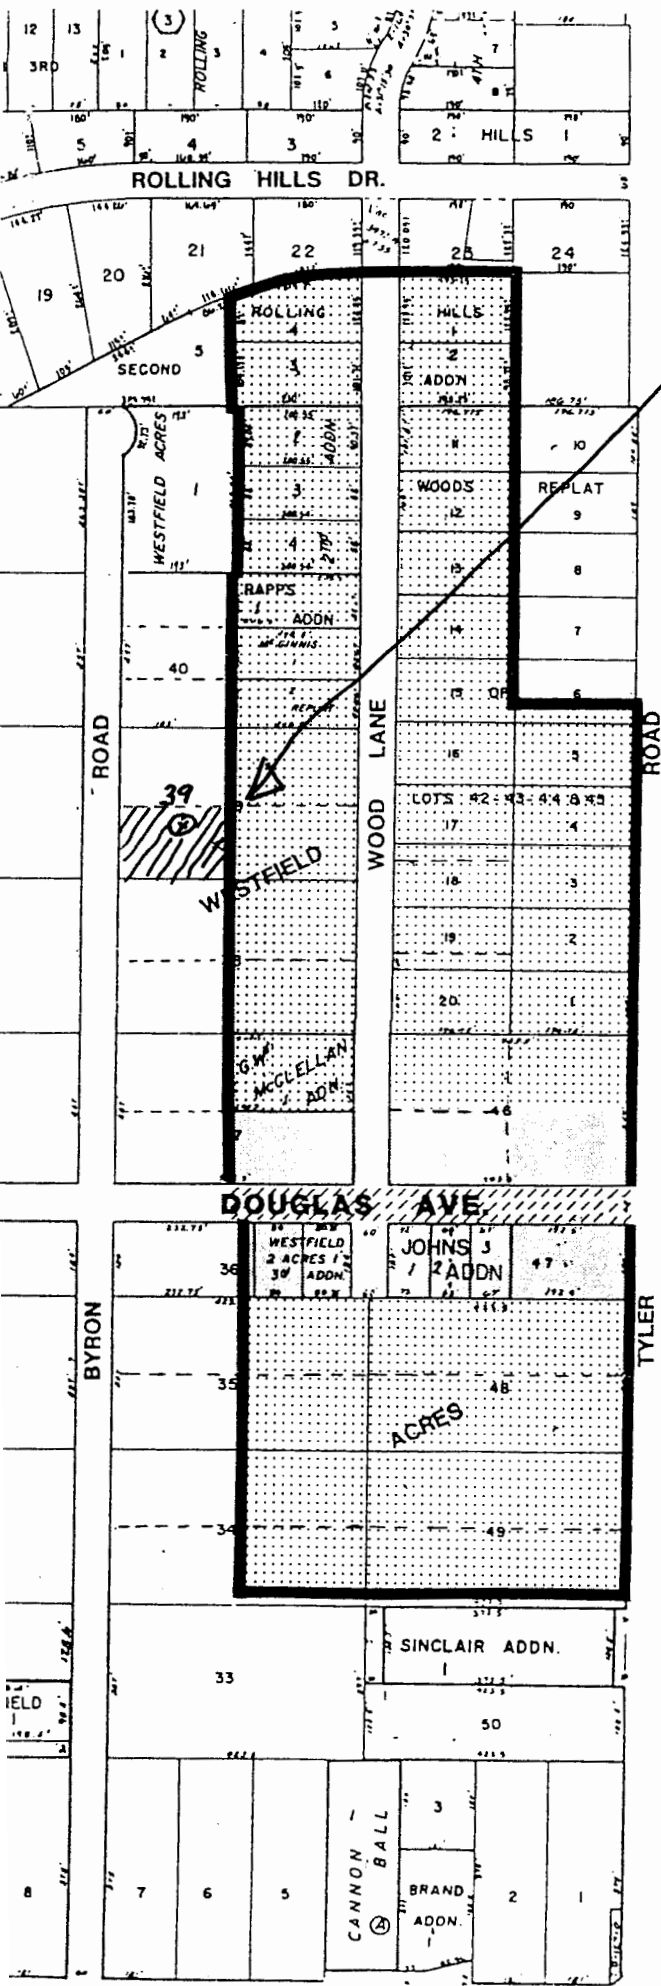

Section of City of Wichita Map showing location of S 128.5 ft W 185 Ft Lot 39, TWN 27 S RNG 1 W Section 20 in Sedwick County, Kansas where Abandoned Well is located

Lot is in S.E. Quarter of Section 20