


258

WATER WELL RECORD Form WWC-5 KSA 82a-1212

1 LOCATION OF WATER WELL: COUNTY: FORD	Fraction NE 1/4 NE 1/4 NE 1/4	Section Number 18	Township Number T 27 S	Range Number R 21 W
---	----------------------------------	----------------------	---------------------------	------------------------

Distance and direction from nearest town or city street address of well if located within city?
10 MILES NORTH OF BUCKLIN

2 WATER WELL OWNER: TILLEY, TODD
 RR#, St. Address, Box #: RT 2 BOX 61
 City, State, ZIP code: BUCKLIN, KS 67834-
 Board of Agriculture, Division of Water Resources
 Application Number:

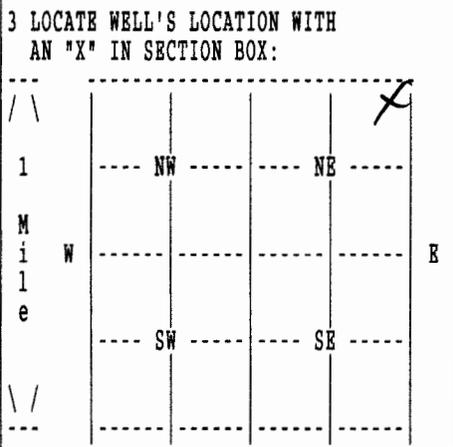

4 DEPTH OF COMPLETED WELL 62 ELEVATION: 0
 Depth(s) Groundwater Encountered 1. 0 ft. 2. 0 ft. 3. 0 ft.

WELL'S STATIC WATER LEVEL 41 ft. below land surface measured on mo/day/yr 10/30/05
 Pump test data: Well water was 0 ft. after 0 hours pumping 0 gpm

Estimated Yield 0 gpm: Well water was 0 ft. after 0 hours pumping 0 gpm

Bore Hole Diameter 8.75 in. to 62 ft., and in. to 0 ft.

WELL WATER TO BE USED AS: LIVESTOCK

Was a chemical/bacteriological sample submitted to department? No ;
 If yes, mo/day/yr sample was submitted Water well disinfected? Yes

5 TYPE OF BLANK CASING USED: PVC CASING JOINTS: GLUED
 Blank casing diameter 5 in. to 47 ft., Dia in. to 0 ft., Dia in. to 0 ft.
 Casing height above land surface 12 in., weight 0 lbs/ft. Wall thickness or gauge No. 26
 TYPE OF SCREEN OR PERFORATION MATERIAL: PVC
 SCREEN OR PERFORATION OPENINGS ARE: SAW CUT

SCREEN PERFORATED INTERVALS: From 47 ft. to 62 ft., From 0 ft. to 0 ft.
 From 0 ft. to 0 ft., From 0 ft. to 0 ft.

GRAVEL PACK INTERVALS: From 25 ft. to 62 ft., From 0 ft. to 0 ft.
 From 0 ft. to 0 ft., From 0 ft. to 0 ft.

6 GROUT MATERIAL BENTONITE
 Grout Intervals: From 4 ft. to 25 ft., From 0 ft. to 0 ft., From 0 ft. to 0 ft.
 What is the nearest source of possible contamination: SEPTIC TANK
 Direction from well? EAST How many feet? 800

FROM	TO	LITHOLOGIC LOG	FROM	TO	PLUGGING INTERVALS
0	33	TAN CLAY			
33	36	GRAY CLAY			
36	38	WHITE CLAY			
38	49	SAND AND GRAVEL			
49	51	TAN CLAY			
51	58	SAND AND GRAVEL			
58	62	WHITE ROCK			
62	63	BLACK SHALE			

7 CONTRACTOR'S OR LANDOWNER'S CERTIFICATION: This water well was Constructed under my jurisdiction and was completed on (mo/day/year) 10/30/05 and this record is true to the best of my knowledge and belief, Kansas
 Water Well Contractor's License No. 653 This Water Well Record was completed on (mo/day/yr) 12/03/05
 under the business name of DAN HAYSE WATER WELL SERV by (signature) *Dan Hayse*