


WATER WELL RECORD Form WWC-5 KSA 82a-1212

1 LOCATION OF WATER WELL: Fraction Section Number Township Number Range Number  
 COUNTY: KIOWA NW 1/4 NW 1/4 NW 1/4 12 T 28 S R 17 W

Distance and direction from nearest town or city street address of well if located within city?  
 1 MILE NORTH, 2 MILES WEST OF HAVILAND

2 WATER WELL OWNER: GOERTZEN, HERMAN Board of Agriculture, Division of Water Resources  
 RR#, St. Address, Box #: RT. 1  
 City, State, ZIP code: HAVILAND, KS 67059- Application Number:

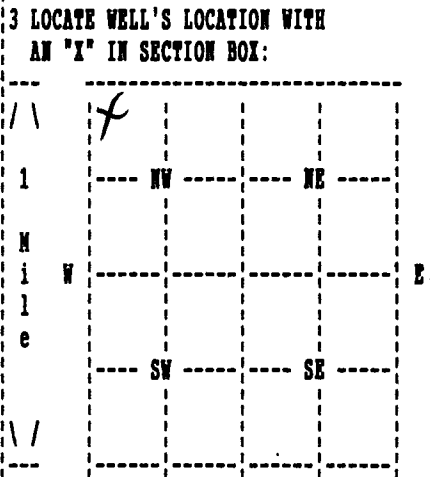

4 DEPTH OF COMPLETED WELL 140 ELEVATION: 0  
 Depth(s) Groundwater Encountered 1. 0 ft. 2. 0 ft. 3. 0 ft.  
 WELL'S STATIC WATER LEVEL 73 ft. below land surface measured on no/day/yr 07/03/03  
 Pump test data: Well water was 0 ft. after 0 hours pumping 0 gpm  
 Estimated Yield 0 gpm: Well water was 0 ft. after 0 hours pumping 0 gpm  
 Bore Hole Diameter 8.75 in. to 140 ft., and in. to 0 ft.  
 WELL WATER TO BE USED AS: DOMESTIC  
 Was a chemical/bacteriological sample submitted to department? No ;  
 If yes, no/day/yr sample was submitted Water well disinfected? Yes

5 TYPE OF BLANK CASING USED: PVC CASING JOINTS: GLOUED  
 Blank casing diameter 5 in. to 120 ft., Dia in. to 0 ft., Dia in. to 0 ft.  
 Casing height above land surface 12 in., weight 0 lbs/ft. Wall thickness or gauge No. 26  
 TYPE OF SCREEN OR PERFORATION MATERIAL: PVC  
 SCREEN OR PERFORATION OPENINGS ARE: SAW CUT

SCREEN PERFORATED INTERVALS: From 120 ft. to 140 ft., From 0 ft. to 0 ft.  
 From 0 ft. to 0 ft., From 0 ft. to 0 ft.  
 GRAVEL PACK INTERVALS: From 25 ft. to 140 ft., From 0 ft. to 0 ft.  
 From 0 ft. to 0 ft., From 0 ft. to 0 ft.

6 GROUT MATERIAL BENTONITE  
 Grout Intervals: From 5 ft. to 25 ft., From 0 ft. to 0 ft., From 0 ft. to 0 ft.  
 What is the nearest source of possible contamination: SEPTIC TANK  
 Direction from well? SOUTH How many feet? 100

FROM	TO	LITHOLOGIC LOG	FROM	TO	PLUGGING INTERVALS
0	10	SILT AND SAND			
10	56	TAN CLAY			
56	76	SAND AND GRAVEL			
76	78	TAN CLAY			
78	94	SAND AND GRAVEL			
94	97	TAN CLAY			
97	140	SAND AND GRAVEL			

7 CONTRACTOR'S OR LANDOWNER'S CERTIFICATION: This water well was Constructed under my jurisdiction and was completed on (no/day/year) 07/03/03 and this record is true to the best of my knowledge and belief. Kansas Water Well Contractor's License No. 653A This Water Well Record was completed on (no/day/yr) 10/09/03 under the business name of DAN HAYSE WATER WELL SVC. by (signature) *Don Hayse*