


WATER WELL RECORD Form WWC-5 KSA 82a-1212

1 LOCATION OF WATER WELL: Fraction Section Number Township Number Range Number
 COUNTY: KIOWA NW 1/4 NE 1/4 SW 1/4 4 T 28 S R 18 W

Distance and direction from nearest town or city street address of well if located within city?
 1 MILE NORTH OF GREENSBURG

2 WATER WELL OWNER: WHITE, DAVID Board of Agriculture, Division of Water Resources
 RR#, St. Address, Box #: RT 1 BOX 112
 City, State, ZIP code: GREENSBURG, KS 67054- Application Number:

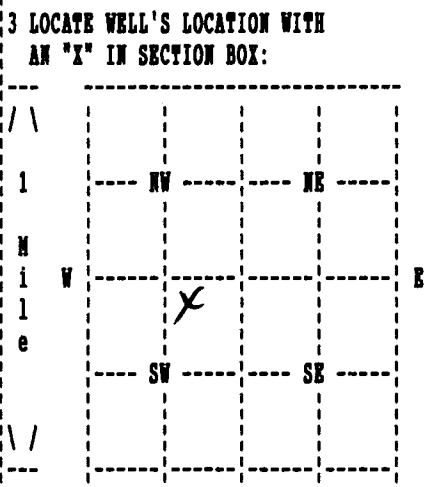

4 DEPTH OF COMPLETED WELL 138 ELEVATION: 0
 Depth(s) Groundwater Encountered 1. 0 ft. 2. 0 ft. 3. 0 ft.
 WELL'S STATIC WATER LEVEL 79 ft. below land surface measured on mo/day/yr 10/17/03
 Pump testdata: Well water was 0 ft. after 0 hours pumping 0 gpm
 Estimated Yield 0 gpm: Well water was 0 ft. after 0 hours pumping 0 gpm
 Bore Hole Diameter 8.75 in. to 138 ft., and in. to 0 ft.
 WELL WATER TO BE USED AS: LIVESTOCK
 Was a chemical/bacteriological sample submitted to department? No ;
 If yes, mo/day/yr sample was submitted Water well disinfected? Yes

5 TYPE OF BLANK CASING USED: PVC CASING JOINTS: GLUED
 Blank casing diameter 5 in. to 128 ft., Dia in. to 0 ft., Dia in. to 0 ft.
 Casing height above land surface 24 in., weight 0 lbs/ft. Wall thickness or gauge No. 26
 TYPE OF SCREEN OR PERFORATION MATERIAL: PVC
 SCREEN OR PERFORATION OPENINGS ARE: SAW CUT

SCREEN PERFORATED INTERVALS: From 128 ft. to 138 ft., From 0 ft. to 0 ft.
 From 0 ft. to 0 ft., From 0 ft. to 0 ft.
 GRAVEL PACK INTERVALS: From 24 ft. to 138 ft., From 0 ft. to 0 ft.
 From 0 ft. to 0 ft., From 0 ft. to 0 ft.

6 GROUT MATERIAL BENTONITE
 Grout Intervals: From 2 ft. to 24 ft., From 0 ft. to 0 ft., From 0 ft. to 0 ft.
 What is the nearest source of possible contamination: SEPTIC TANK
 Direction from well? SOUTHEAST How many feet? 2000

FROM	TO	LITHOLOGIC LOG	FROM	TO	PLUGGING INTERVALS
0	7	SILT AND SAND			
7	20	TAN CLAY			
20	38	BROWN CLAY			
38	52	SAND			
52	60	TAN CLAY			
60	88	SAND AND GRAVEL			
88	92	YELLOWISH CLAY			
92	138	SAND AND GRAVEL			

7 CONTRACTOR'S OR LANDOWNER'S CERTIFICATION: This water well was Constructed under my jurisdiction and was completed on (mo/day/year) 10/17/03 and this record is true to the best of my knowledge and belief. Kansas Water Well Contractor's License No. 653A This Water Well Record was completed on (mo/day/yr) 12/29/05 under the business name of DAN HAYSE WATER WELL SVC. by (signature) Dan Hayse