
			WWC-5		Division of W				SVE-3		
			ge in Well Use		Resources App		T 1: 11 1	Well ID	NT 1		
1 LOCATION OF WATER WELL: County: Gray			Fraction SW 1/4 SW 1/4 SW 1/4	Section Number 24			Township Number Range Number T 28 S R 29 □ E ■ W				
		V and Names   OVO	First: Gregory C.			Address where well is located (if unknown, distance and					
2 WELL OWNER: Last Name: Love Business:  First: Gregory C. Street or Rural Address where well is located (if unknown, distart direction from nearest town or intersection): If at owner's address, check											
Address	_ TOOO	I3 Road		,							
Address:  City: Montezuma State: KS ZIP: 67867											
2 LOCATE WELL											
	"X" IN	4 DEPTH OF CO		5 Latitude: 37.59871 (decimal degrees)							
	ON BOX:		Encountered: 1)			Longitude: -100.44252 (decimal degrees)					
N 2) ft. 3 WELL'S STATIC WA'			3) ft., or 4) [				Datum: WGS 84	□ NAD	83 🗆 NAD 27		
				, measured on (mo-day-yr)			Source for Latitude/Longitude:  GPS (unit make/model:)				
1 1 1 -				measured on (mo-day-yr)			(WAAS enabled? ☐ Yes ☐ No)				
Pump test data: Well w				ater was ft.			☐ Land Survey ☐ Topographic Map				
W E after hours				pumping gpm			■ Online Mapper: Google Earth				
1 1 037 1 05 1 1			water was f	ming ann							
Estimated Vield			gnm	opm 6 Elevation:			. 2779ft.	Ground	Level TOC		
S Bore Hole Diameter:			8.75 in to 144	5 in. to 144 ft. and Source: Land			Land Survey GI	nd Survey GPS Topographic Map			
<b> 1</b>	mile		in. to	ft. Other							
7 WELL WATER TO BE USED AS:											
1. Domestic			ater Supply: well ID				ld Water Supply: leas				
_	☐ Household 6. ☐ Dewatering: how many wells?										
! =	☐ Lawn & Garden         7. ☐ Aquifer Recharge: well ID           ☐ Livestock         8. ☐ Monitoring: well ID					12. Geothermal: how many bores?					
2. Irrigation 9. Environmental Remediation: well ID SVE					12. 30	a) Closed Loop   Horizontal   Vertical					
3. ☐ Feedlot ☐ Air Sparge ■ Soil Vapor Ext											
4. Indust	trial	☐ Recovery	☐ Injection		13. 🗆	Other (	specify):	• • • • • • • • • • • • • • • • • • • •			
Was a chemical/bacteriological sample submitted to KDHE?   Yes No If yes, date sample was submitted:											
Water well disinfected? ☐ Yes ■ No											
8 TYPE OF CASING USED: ☐ Steel ■ PVC ☐ Other											
Casing diameter 4 in to 100 ft., Diameter 4 in to 140 ft., Diameter ft.											
Casing height above land surface											
TYPE OF SCREEN OR PERFORATION MATERIAL:  ☐ Steel ☐ Stainless Steel ☐ Fiberglass ■ PVC ☐ Other (Specify)											
☐ Brass ☐ Galvanized Steel ☐ Concrete tile ☐ None used (open hole)											
SCREEN OR PERFORATION OPENINGS ARE:											
☐ Continuous Slot ■ Mill Slot ☐ Gauze Wrapped ☐ Torch Cut ☐ Drilled Holes ☐ Other (Specify)											
□ Louvered Shutter □ Key Punched □ Wire Wrapped □ Saw Cut □ None (Open Hole)											
SCREEN-PERFORATED INTERVALS: From											
9 GROUT MATERIAL: ☐ Neat cement ☐ Cement grout ☐ Bentonite ☐ Other											
Crout Intervals: From											
Septic Tank											
☐ Sewer Lines ☐ Cess Pool ☐ Sewage Lagoon ☐ Fuel Storage ☐ Abandoned Water Well											
☐ Watertight Sewer Lines ☐ Seepage Pit ☐ Feedyard ☐ Fertilizer Storage ☐ Oil Well/Gas Well											
☐ Other (Specify) .Contaminated .Site											
10 FROM	TO	LITHOLOG	GIC LOG	FROM			HO. LOG (cont.) or Pl	UGGINO	INTERVALS		
0	0.5	Gravel	310 200	82	87		, v. sandy, Brown				
0.5	13	Clay, silty, Brown		87	98		d, vf-c w/f gravel				
13	19	Clay, sandy (vf-f), V. L	t. Brown	98	104		, sandy, V. Lt. Bro	wn to Ta	an		
19	32	Silt, sandy (vf), V. Lt. i		104	118		, vf-c, Lt. Brown t				
32	50	Clay, v. silty, sandy st		118	123		, v. sandy, Lt. Bro				
50	54	Clay, sandy, Brown to	Lt. Brown	123	133	Sand	d, vf-c w/f gravel, i	Brown			
54	56	Sand, vf-c, Brown		Notes:	133 to 138	Clay,	silty, sandy, Brown				
56 72 Clay, sandy to v. sandy, V. Lt. Brn to Brn 138 to 144 Sand, f-c w/f-m gravel, sl. clayey strngrs, Brown											
72 82 Clay, v. sandy, Red Brown											
11 CONTRACTOR'S OR LANDOWNER'S CERTIFICATION: This water well was constructed, reconstructed, or plugged under my jurisdiction and was completed on (mo-day-year) .7/1/2017 and this record is true to the best of my knowledge and belief.											
Kansas Water Well Contractor's License No. 527 This Water Well Record was completed on (mo-day-year), 7/31/201.7											
under the business name of GeoCore Inc. Signature Signature											
Mail 1 white copy along with a fee of \$5.00 for each constructed well to: Kansas Department of Health and Environment, Bureau of Water, GWTS Section, 1000 SW Jackson St., Suite 420, Topeka, Kansas 66612-1367. Mail one to Water Well Owner and retain one for your records. Telephone 785-296-5524.											
				ater Well O SA 82a-		one for			524. 7/ <b>10/2015</b>		
visit us at http	.//www.kanek	s.gov/waterwell/index.html		SOM OZA-	1414			LCVISCU .	110/2013		

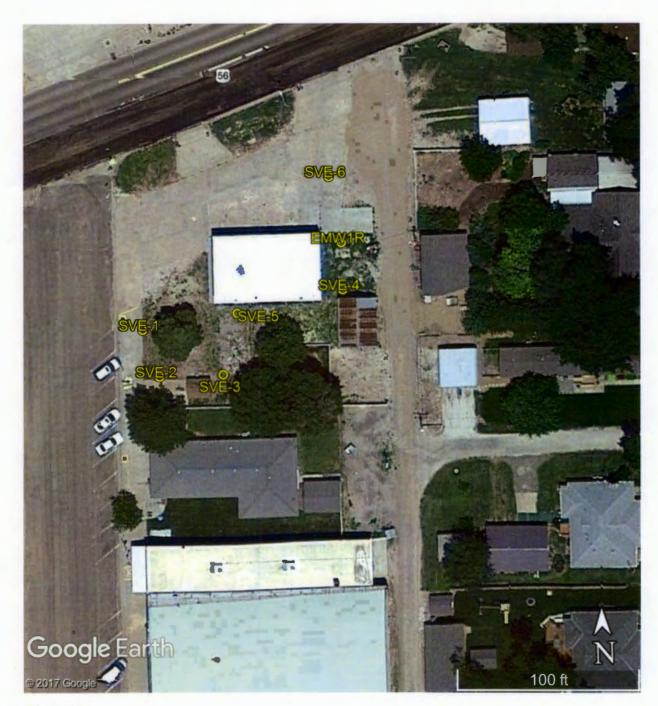

SVE-5: 37.59880, -100.44249

SVE-6: 37.59900, -100.44231

Evan's Tire Site 101 E. Texcoco St., Montezuma

## **GPS Coordinates**:

EMW1R: 37.59890, -100.44229 SVE-1: 37.59878, -100.44267 SVE-2: 37.59871, -100.44264 SVE-3: 37.59871, -100.44252 SVE-4: 37.59883, -100.44229