
		_	orm www				sion of Water		w	/all ID	PA-MW-02	
			Change in W				urces App. No.			ell ID	N. 1.	
1 LOCAT	rion of v	VATER WELL:	Frac			Sect	ion Number	Township Nu			ge Number	
	y: Ford		NE	4 SE 1/4 SE								
2 WELL	OWNER:	Last Name:	First	:		reet or Rural Address where well is located (if unknown, distance and						
Business: Pride Ag direction from nearest town or intersection): If at owner's address, check here:											heck here:	
Address: US Hwy 400												
Address: City: Ford State: KS ZIP:												
City:	Ford				<u> </u>		γ					
3 LOCAT		4 DEPTH OF	59	59 ft 5 Latitude: 37.63222 (decimal degrees)								
WITH "		Denth(c) Ground	55	5 Latitude: 37.53222 (decimal degree Longitude: -99.75000 (decimal degree decimal degree longitude: -99.75000 (decimal degree longitude: -99.7500) (decimal degree longitude: -99.75000 (decimal deg					(decimal degrees)			
3 LOCATE WELL WITH "X" IN SECTION BOX: N Depth(s) Groundwater Encountered: 1)						Dry Well Horizontal Datum: ■ WGS 84 □ NAD 83 □					(decimal degrees)	
WELL'S STATIC WATER LEVEL:										INAD	33 LI NAD 21	
below land surface, measured on (mo-day-											,	
, , , , ,			above land surface, measured on (mo-day-yr)									
NW	NW NE							Land Survey Topographic Map				
w							om Endine Manner: Google				į	
"	E	er was ft.			Online Mapper: Google							
SW	SE		after hours pumping gpm			NΛ						
×	1 1					6 Elevation: NA Ground Level					Level 🔲 TOC	
	S	Bore Hole Diame	imated Yield:gpm re Hole Diameter:gni in. toft			and Source: Land Survey						
1	nile		in. to ft.			Other						
7 WELL WATER TO BE USED AS: 1. Domestic: 5. □ Public Water Supply: well ID												
_												
House				w many wells?								
1	& Garden	/. ∐ Aqı	iiter Kecnarg	e: well ID II IDPA-	MW-02"	•••••						
Livesto								mal: how many b				
	I. ☐ Irrigation 9. Environmental Remediation: well ID. I. ☐ Feedlot ☐ Air Sparge ☐ Soil Vapor Ex							ed Loop Horiz				
3. Feedlo			Extraction	n		n Loop Surface						
4. Industrial Recovery Injection 13. Other (specify):												
Was a chemical/bacteriological sample submitted to KDHE? Yes No If yes, date sample was submitted:												
Water well disinfected? ☐ Yes ■ No												
8 TYPE OF CASING USED: ☐ Steel ■ PVC ☐ Other CASING JOINTS: ☐ Glued ☐ Clamped ☐ Welded ■ Threaded												
Casing diameter 2 in to 19 ft. Diameter in to 19 ft. Diameter in to 19 ft. Diameter in to 19 ft.												
Casing diameter												
TYPE OF SCREEN OR PERFORATION MATERIAL:												
Steel ☐ Stainless Steel ☐ Fiberglass ☐ PVC ☐ Other (Specify)												
☐ Brass ☐ Galvanized Steel ☐ Concrete tile ☐ None used (open hole)												
SCREEN OR PERFORATION OPENINGS ARE:												
☐ Continuous Slot												
Louvered Shutter												
SCREEN-I	PERFURA	ED INTERVALS	From	tt. to	a It., F	rom	ft. to .	ft., From	•••••	it. to	π.	
G	RAVEL PA	CK INTERVALS	: From	ft. to	ft., F	rom	ft. to .	ft., From		ft. to	ft.	
□ Louvered Shutter □ Key Punched □ Wire Wrapped □ Saw Cut □ None (Open Hole) SCREEN-PERFORATED INTERVALS: From 49 ft. to 59 ft., From ft. to ft., From ft. to ft. GRAVEL PACK INTERVALS: From 47 ft. to 59 ft., From ft. to ft., From ft. to ft. 9 GROUT MATERIAL: □ Neat cement □ Cement grout □ Bentonite □ Other Cemet pad Grout Intervals: From ft. to ft., From ft. to ft.												
Grout Intervals: From												
Nearest sou	rce of possil	le contamination:										
☐ Septic		☐ Later	al Lines	☐ Pit Privy			Livestock Pens	☐ Inse	ecticide	Storage		
☐ Sewer	Lines	☐ Cess	Pool	☐ Sewage I	agoon		Fuel Storage	☐ Aba	andoned	Water \	Well	
☐ Watertight Sewer Lines ☐ Seepage Pit ☐ Feedyard ☐ Fertilizer Storage ☐ Oil Well/Gas Well												
Direction from well?												
Direction fro	om well?			Distance from	well?				. ft.			
10 FROM	TO	LITH	OLOGIC L		FRC			ITHO. LOG (cont		UGGIN	G INTERVALS	
0	1	gravel										
1	12	Clay, brown, dar	np, soft									
12	24	Clay, brown, dar										
24	35	Clay, dark brown, hard, dry										
35	50	Sand, brown, fine, moist										
50	54											
I .		Clayey Sand, brown, moist										
54	50	Sand, brown, fin	Note	Notes:								
11 CONTRACTOR'S OR LANDOWNER'S CERTIFICATION. This water well was a constructed or nhugged												
under my jurisdiction and was completed on (mo-day-year) 3-29-2022 and this record is true to the best of my knowledge and belief.												
Kansas Water Well Contractor's License No. 604 This Water Well Record was completed on (mo-day-year) . 17.18.122												
11 CONTRACTOR'S OR LANDOWNER'S CERTIFICATION: This water well was constructed, reconstructed, or plugged under my jurisdiction and was completed on (mo-day-year) 3-29-2022 and this record is true to the best of my knowledge and belief. Kansas Water Well Contractor's License No. This Water Well Record was completed on (mo-day-year) 11.15.1.2												
Mail 1 white copy along with a fee of \$5.00 for each constructed well to: Kansas Department of Health and Environment, Bureau of Water, GWTS Section,												
		St., Suite 420, Topeka,										
		ks.gov/waterwell/index.			KSA 82			•			7/10/2015	

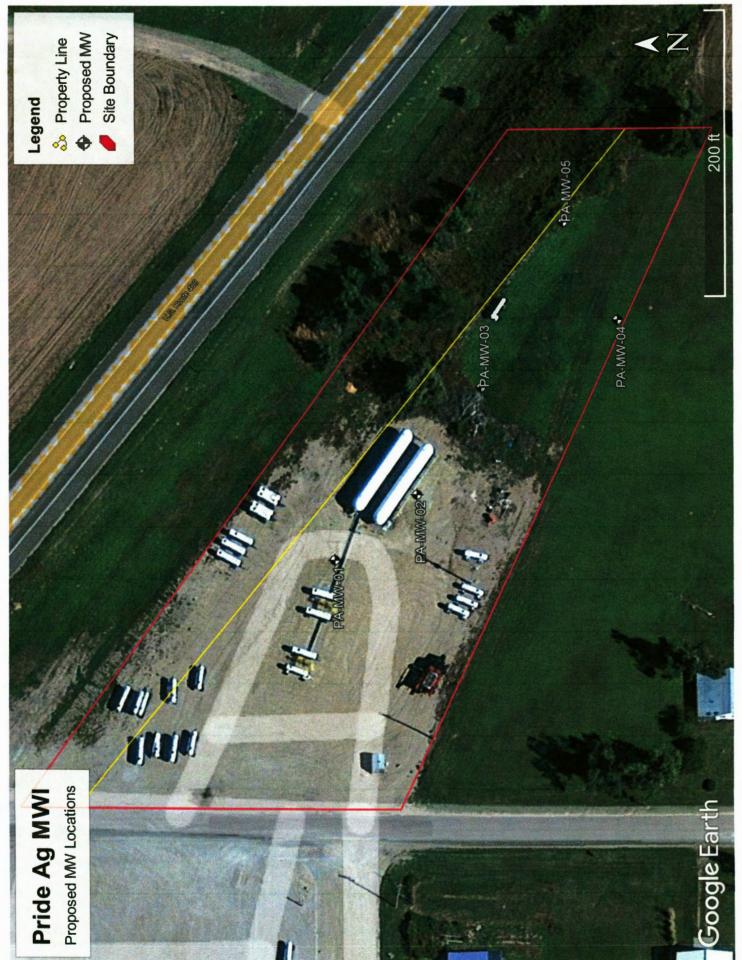

FORT, Kr.