
		RECORD		WWC-5		Division of W	1			EMW1R		
		Correction		ge in Well Use		esources App			ell ID			
		WATER WEL	L:	Fraction		Section Num		Number		ge Number		
	ty: Gray			SW 1/4 SW 1/4 SW 1/4		24		28 S		P □ E ■ W		
2 WELL OWNER: Last Name: Love First: Gregory C. Business:						Street or Rural Address where well is located (if unknown, distance and direction from nearest town or intersection): If at owner's address, check here:						
	Address: 24506 13 Road						, –					
Address					101 E Te	xcoco Stree	et, Montezuma					
City:	Montez	uma	State: KS	ZIP: 67867								
	3 LOCATE WELL 4 DEPTH OF COMPLETED WELL:						itude:3	7.59890		(decimal degrees)		
WITH "X" IN Donth(s) Groundwater Encountered: 1)						Lor	gitude:	100.44229		(decimal degrees)		
SECTION BOX: Depth(s) Groundwater Encountered. 1)							izontal Datum:					
1	WELL'S STATIC WATER LEVEL:						rce for Latitude/Lo					
				, measured on (mo-day		GPS (unit make/m						
Dumn test date: Well				ce, measured on (mo-day-yr)			(WAAS enab			0)		
				s pumping			Online Mapper: .					
Well v				vater was	_	Offinic Mapper.	1.7.7 9 .7					
			s pumping	6 El	6 Elevation: .2779ft. ■ Ground Level □ TOC							
Estimated Yield:			gpm	o Elev	Source: Land Survey GPS Topographic Map							
S Bore Hole Diameter: 8				Q.(Q in. to								
7 WELL WATER TO BE USED AS: 1. Domestic: 5. Public Water Supply: well ID												
1	☐ Household 6. ☐ Dewatering: how many wells?											
_	☐ Lawn & Garden 7. ☐ Aquifer Recharge: well ID											
☐ Lives	☐ Lawn & Garden ☐ Livestock ☐ Livestock 7. ☐ Aquifer Recharge: well ID											
	2. Irrigation 9. Environmental Remediation: well ID											
3. Feedl			Air Sparge		extraction	b) Open Loop Surface Discharge Inj. of Water						
4. Industrial Recovery Injection 13. Other (specify):												
Was a chemical/bacteriological sample submitted to KDHE? Yes No If yes, date sample was submitted:												
Water well disinfected? Yes No CASING IODITS: CASING IODITS:												
8 TYPE OF CASING USED: ☐ Steel ☐ PVC ☐ Other												
Casing height above land surface in. Weight lbs/ft. Wall thickness or gauge No. Sch. 80.												
TYPE OF SCREEN OR PERFORATION MATERIAL:												
☐ Steel ☐ Stainless Steel ☐ Fiberglass ■ PVC ☐ Other (Specify)												
☐ Brass ☐ Galvanized Steel ☐ Concrete tile ☐ None used (open hole)												
SCREEN OR PERFORATION OPENINGS ARE:												
☐ Continuous Slot ☐ Mill Slot ☐ Gauze Wrapped ☐ Torch Cut ☐ Drilled Holes ☐ Other (Specify)												
□ Louvered Shutter □ Key Punched □ Wire Wrapped □ Saw Cut □ None (Open Hole) SCREEN-PERFORATED INTERVALS: From												
GRAVEL PACK INTERVALS: From												
OCCOUNT MATERIAL: Next coment Coment grout Pentonite Other												
9 GROUT MATERIAL: ☐ Neat cement ☐ Cement grout ■ Bentonite ☐ Other												
Nearest source of possible contamination:												
☐ Septic Tank ☐ Lateral Lines ☐ Pit Privy ☐ Livestock Pens ☐ Insecticide Storage												
☐ Sewer			ess Pool	☐ Sewage Lag		Fuel Storag		Abandoned \		/ell		
☐ Watertight Sewer Lines ☐ Seepage Pit ☐ Feedyard ☐ Fertilizer Storage ☐ Oil Well/Gas Well												
☐ Other (Specify) .Contaminated Site												
10 FROM	TO		THOLOG		FROM	ТО	LITHO. LOG (co		GGING	INTERVALS		
0	0.5	Concrete	INOLOG	ile Bod	80	88	Clay, w/caliche					
0.5	1	Sand (fill)			88	98	Sand, vf-c w/f-		0.0	***		
1	8	Clay and San	d (possib	ole fill)	98	125	Clay, sandy, v		Brown	to Brown		
8	31			own to Lt. Brown	125	132	Sand, vf-c					
31	44			Yellow Brown	132	136	Sand, vf-c, cla	yey, Brow	n	7.7 79.3111		
44	52	Clay, sandy, t	r. caliche	, Lt. Brown	136	153	Sand, vf-c w/f-					
52	57		and, vf-m, clayey, Brown									
57												
73 80 Clay, v. sandy, Red Brown												
11 CONT	11 CONTRACTOR'S OR LANDOWNER'S CERTIFICATION: This water well was constructed, or reconstructed, or plugged											
under my jurisdiction and was completed on (mo-day-year) .7/12/2017 and this record is true to the best of my knowledge and belief. Kansas Water Well Contractor's License No. 527 This Water Well Record was completed on (mo-day-year) .8/1/2017												
under the h	usiness nam	nd actor's Licen	ise noyı Linc.	41 Inis wai	or well Ke	ignature	La ce de la constante	may-year) .	v			
Mail	1 white copy al	ong with a fee of \$5	.00 for each	constructed well to: Kans	as Departmen	nt of Health and	Environment, Burea	u of Water, G	WTS Sec	ction,		
1000 SW Jackson St., Suite 420, Topeka, Kansas 66612-1367. Mail one to Water Well Owner and retain one for your records. Telephone 785-296-5524.												
Visit us at http	Visit us at http://www.kdheks.gov/waterwell/index.html KSA 82a-1212 Revised 7/10/2015											

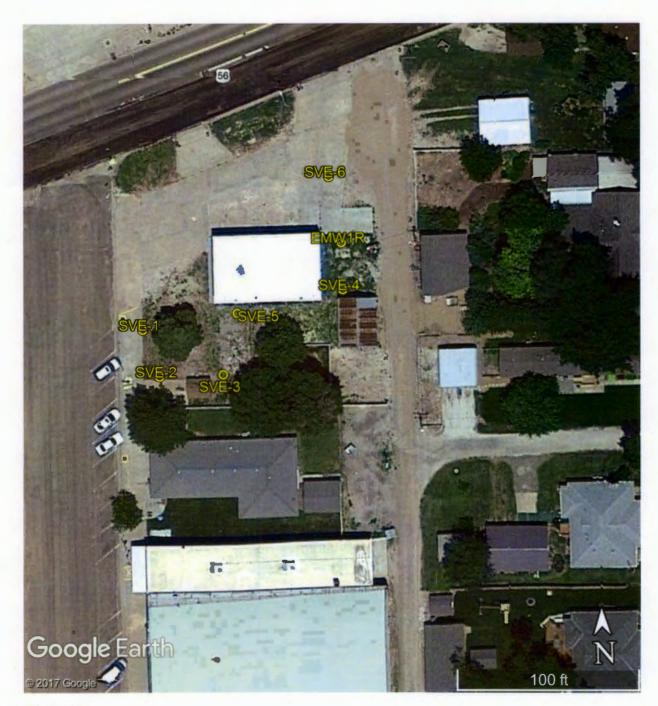

SVE-5: 37.59880, -100.44249

SVE-6: 37.59900, -100.44231

Evan's Tire Site 101 E. Texcoco St., Montezuma

GPS Coordinates:

EMW1R: 37.59890, -100.44229 SVE-1: 37.59878, -100.44267 SVE-2: 37.59871, -100.44264 SVE-3: 37.59871, -100.44252 SVE-4: 37.59883, -100.44229