
	ATER WELL		orm WWC-5		Division of Wa	ľ	SVE-1	
	Original Record		Change in Well Use		esources App.		Well ID	
1	County: Gray	WATER WELL:	Fraction SW 1/4 SW 1/4 SW 1/2	_	Section Numb 24	per Township Numb	per Range Number R 29 □ E ■ W	
2	WELL OWNER	: Last Name: Love	First: Gregory C.	Street or Rural Address where well is located (if unknown, distance and				
~	Business:	Last Hame. Love	1 nst. 0.0q01 y 0.	direction from nearest town or intersection): If at owner's address, check here:				
	Address: 24506 13 Road 101 E Tex					t, Montezuma		
City: Montezuma State: KS ZIP: 67867								
3	LOCATE WELL			140	0	37 5087	70	
	WITH "X" IN		COMPLETED WELL: water Encountered: 1)					
	SECTION BOX:		ft. 3) ft., or 4)				4 \square NAD 83 \square NAD 27	
1.	N	WELL'S STATION	C WATER LEVEL:		Source	Source for Latitude/Longitude:		
	1 1		urface, measured on (mo-day			GPS (unit make/model:)		
	NW NE		urface, measured on (mo-day Well water was			(WAAS enabled? ☐ Yes ☐ No) ☐ Land Survey ☐ Topographic Map		
l w		1 - ^					Earth	
	SW SE	1	Well water was	ter was ft.				
	SW SE		hours pumping	gpm	6 Eleva	ation: 2779 ft	. Ground Level 🔲 TOC	
"	S	Estimated Yield: Bore Hole Diame	ter: . 8.75 in. to 144	ft. and			Land Survey GPS Topographic Map	
-	1 mile	Bore Hote Diame	in. to	ft.		☐ Other		
7 WELL WATER TO BE USED AS:								
	Domestic:		ic Water Supply: well ID				ease	
	Household		ratering: how many wells?			Hole: well ID		
	☐ Lawn & Garden ☐ Livestock		ifer Recharge: well ID itoring: well ID					
, -	☐ Irrigation	9. Environ	mental Remediation: well I	D SVE-1 a) Closed Loop Horizontal Vertical				
3. [☐ Feedlot	☐ Air S	Sparge Soil Vapor		ion b) Open Loop Surface Discharge Inj. of Water			
4. [Industrial	Reco	overy		13. 🗆 O	ther (specify):		
Was a chemical/bacteriological sample submitted to KDHE? ☐ Yes ■ No If yes, date sample was submitted:								
Water well disinfected? ☐ Yes ■ No								
8 TYPE OF CASING USED: ☐ Steel ☐ PVC ☐ Other								
Casing height above land surface in. Weight lbs./ft. Wall thickness or gauge No. Sch. 80								
TYPE OF SCREEN OR PERFORATION MATERIAL:								
☐ Steel ☐ Stainless Steel ☐ Fiberglass ■ PVC ☐ Other (Specify)								
☐ Brass ☐ Galvanized Steel ☐ Concrete tile ☐ None used (open hole)								
SCREEN OR PERFORATION OPENINGS ARE: ☐ Continuous Slot								
□ Louvered Shutter □ Key Punched □ Wire Wrapped □ Saw Cut □ None (Open Hole)								
SCREEN-PERFORATED INTERVALS: From								
GRAVEL PACK INTERVALS: From								
9 GROUT MATERIAL: Neat cement Cement grout Bentonite Other								
Grout Intervals: From 3 ft. to 95 ft., From ft. to ft., From ft. to ft., From ft. to ft.								
	Septic Tank	Die contamination: Lateral	Lines	г	Livestock Pe	ns 🗆 Insectic	ide Storage	
Sewer Lines Cess Pool Sewage Lagoon Fuel Storage Abandoned Water Well								
☐ Watertight Sewer Lines ☐ Seepage Pit ☐ Feedyard ☐ Fertilizer Storage ☐ Oil Well/Gas Well								
Other (Specify) .Contaminated Site								
	FROM TO		PLOGIC LOG	FROM			PLUGGING INTERVALS	
0	4	Clay, silty, Brown	LUGIC LUG	86		Intbdd Clay & Sand,		
4	10		wn to Yellow Brown	90		Sand, vf-c w/f gravel		
10	16	Clay, silty, abnt ca		96		Clay, sandy, V Lt Bro		
16	23		nd stringers, Brown	103		Sand, vf-c, w/clay str		
23	47		caliche, Brn to Yel Brn	117	144	Clay and Sand (vf-m), Lt. Brown	
47	63		dy, Brown to Lt Brown					
63 72 Clay, occ caliche, slty-sndy, Brn to Lt Brn Notes:								
72								
80 86 Clay, occ. caliche, sandy, V Lt Brown 11 CONTRACTOR'S OR LANDOWNER'S CERTIFICATION: This water well was constructed, reconstructed, or plugged								
under my jurisdiction and was completed on (mo-day-year) .7/11/2017 and this record is true to the best of my knowledge and belief.								
Kansas Water Well Contractor's License No. 527 This Water Well Record was completed on (morday-year) 8/1/2017								
under the business name of GeoCore Inc. Signature Mail 1 white copy along with a fee of \$5.00 for each constructed well to Kansas Department of Health and Environment, Bureau of Water, GWTS Section,								
Mail I write copy along with a fee of \$5.00 for each constructed well to: Kansas Department of Health and Environment, Bureau of Water, GW18 Section, 1000 SW Jackson St., Suite 420, Topeka, Kansas 66612-1367. Mail one to Water Well Owner and retain one for your records. Telephone 785-296-5524.								
Visit us at http://www.kdheks.gov/waterwell/index.html KSA 82a-1212 Revised 7/10/2015								

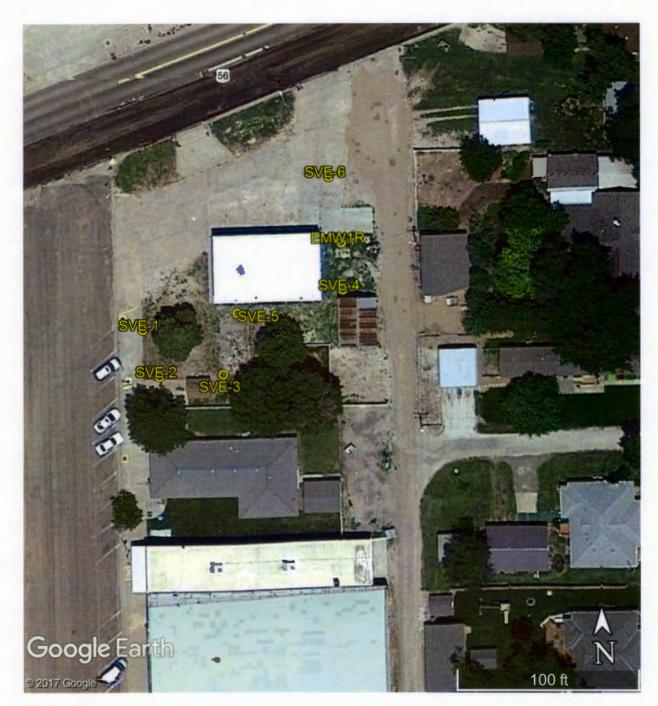

SVE-5: 37.59880, -100.44249

SVE-6: 37.59900, -100.44231

Evan's Tire Site 101 E. Texcoco St., Montezuma

GPS Coordinates:

EMW1R: 37.59890, -100.44229 SVE-1: 37.59878, -100.44267 SVE-2: 37.59871, -100.44264 SVE-3: 37.59871, -100.44252 SVE-4: 37.59883, -100.44229