
	R WELL		WWC-5		Division of Wa				SVE-5	
			ge in Well Use		esources App.			Well ID	a. Manda	
1 LOCATION OF WATER WELL: County: Gray			Fraction SW 1/4 SW 1/4 SW 1/4		Section Numl 24		nship Number F 28 S		ige Number 9 □ E ■ W	
		Last Name: Love								
2 WELLOWNER: Last Name Love First: Gregory C. Street or Rural Address where well is located (if unknown, distance and direction from nearest town or intersection): If at owner's address, check here:										
Address: 24506 13 Road 101 E Texcoco Str							ıma			
Address: City: Montezuma State: KS ZIP: 67867										
	TE WELL		140	0		27 50990	me			
WITH "X" IN SECTION POY. 4 DEPTH OF COMPLETED WELL: Depth(s) Groundwater Encountered: 1)										
SECTION BOX: 9 3 0 or 4) Dry We						Horizontal Datum: ■ WGS 84 □ NAD 83 □ NAD 27				
WELL'S STATIC WATER LEVEL: ft.						Source for Latitude/Longitude:				
)	
Down test date: Well or			measured on (mo-day-yr) ater was ft.			(WAAS enabled? ☐ Yes ☐ No) ☐ Land Survey ☐ Topographic Map				
						Online Mapper: Google Earth				
	1 ' 1	vater was ft	ater was ft.							
			pumpinggpm 6 Elevation			ation: 277	79ft. 🛭	Ground	Level ☐ TOC	
Estimated Yield: Bore Hole Diameter:			gpm 75 in. to144 ft. and Source: □ 1			ce: Land	Land Survey GPS Topographic Map			
1 mile						Other	Other			
7 WELL WATER TO BE USED AS:										
1. Domesti				pply: well ID			eld Water Supply: lease			
							☐ Uncased ☐ Geotechnical			
				well ID						
2. ☐ Irrigation 9. Environmental Remediation: well ID .S.					. a) C	a) Closed Loop				
3. ☐ Feedlot ☐ Air Sparge ☐ Soil Vapor				xtraction		b) Open Loop Surface Discharge Inj. of Water				
4. 🔲 Indus		Recovery					/):			
Was a chemical/bacteriological sample submitted to KDHE? ☐ Yes ■ No If yes, date sample was submitted:										
Water well disinfected? Yes No CASING IODITS: Global Gl										
8 TYPE OF CASING USED: ☐ Steel ☐ PVC ☐ Other										
Casing diameter in to weight in to weight wall thickness or gauge No. Sch. 80										
TYPE OF SCREEN OR PERFORATION MATERIAL:										
☐ Steel ☐ Stainless Steel ☐ Fiberglass ■ PVC ☐ Other (Specify)										
☐ Brass ☐ Galvanized Steel ☐ Concrete tile ☐ None used (open hole) SCREEN OR PERFORATION OPENINGS ARE:										
SCREEN OR PERFORATION OPENINGS ARE: ☐ Continuous Slot ■ Mill Slot ☐ Gauze Wrapped ☐ Torch Cut ☐ Drilled Holes ☐ Other (Specify)										
Louvered Shutter										
SCREEN-PERFORATED INTERVALS: From100										
GRAVEL PACK INTERVALS: From										
9 GROUT MATERIAL: ☐ Neat cement ☐ Cement grout ☐ Bentonite ☐ Other										
Grout Intervals: From										
Septic		Lateral Lines	s Pit Privy	[Livestock P	ens	☐ Insecticide	Storage		
☐ Sewer		Cess Pool		☐ Fuel Storage						
☐ Watertight Sewer Lines ☐ Seepage Pit ☐ Feedyard ☐ Fertilizer Storage ☐ Oil Well/Gas Well										
■ Other (Specify) .Contaminated Site										
10 FROM	TO	LITHOLOG		FROM	TO	LITHO. LC	OG (cont.) or PL	UGGINO	INTERVALS	
0		Clay, silty, Brown to Ye		96	102		andy w/sand			
11		Caliche, sandy, Tan to		102	109		w/f gravel w			
13		Clay, tr. caliche, sandy	, Yellow Brn to Brn				w/f gravel, w		ay Inss, Brn	
17		Clay, silty, Lt. Brown		120			n w/tr c, Lt. B			
58		Caliche, sandy, Tan to		134	137		andy, Lt. Brov			
61		Clay, sandy, Lt. Brown		137	144	Sand, f-c	w/f-m gravel,	si. claye	ey	
71		Clay, v. sandy, Red Br		Notes:						
75 86 Clay, v. sandy, V Lt Brn to Yellow Brn 86 96 Sand, vf-c/f-m gravel, Brn w/occ Black										
11 CONTRACTOR'S OR LANDOWNER'S CERTIFICATION: This water well was constructed, reconstructed, or plugged										
under my jurisdiction and was completed on (mo-day-year) .7/6/20.17 and this record is true to the best of my knowledge and belief. Kansas Water Well Contractor's License No527 This Water Well Record was completed on (mo-day-year) .7/31/2017										
Kansas Wa	ter Well Cor	tractor's License No57	41 This Wate	er Well Re	cord was con	mpleted on	(mo-day-year)	.7/31/2	J.7	
under the b	usiness name	of GeoCore Inc	constructed well to Kans	s Denartmen	ignature	Environment	Bureau of Water	GWTS Se	ction	
Mail I white copy along with a fee of \$5.00 for each constructed well to: Kansas Department of Health and Environment, Bureau of Water, GWTS Section, 1000 SW Jackson St., Suite 420, Topeka, Kansas 66612-1367. Mail one to Water Well Owner and retain one for your records. Telephone 785-296-5524.										
Visit us at http://www.kdheks.gov/waterwell/index.html KSA 82a-1212 Revised 7/10/2015										

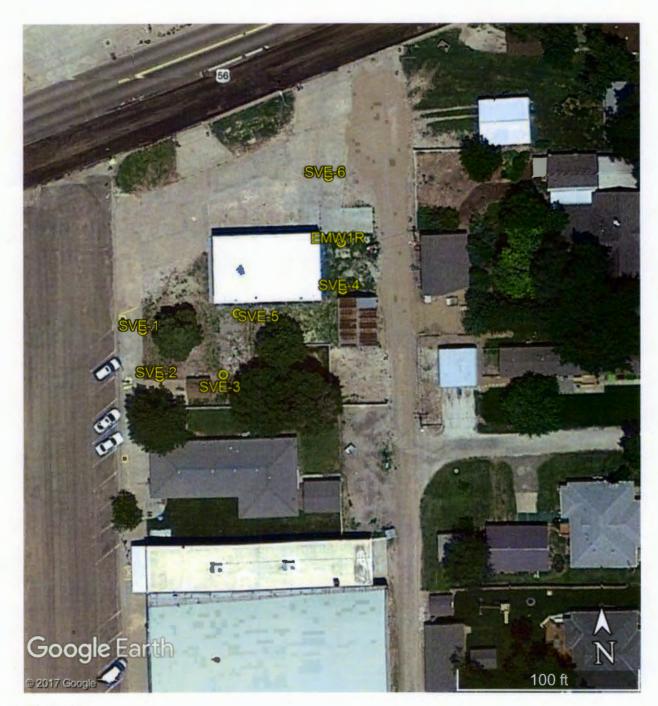

SVE-5: 37.59880, -100.44249

SVE-6: 37.59900, -100.44231

Evan's Tire Site 101 E. Texcoco St., Montezuma

GPS Coordinates:

EMW1R: 37.59890, -100.44229 SVE-1: 37.59878, -100.44267 SVE-2: 37.59871, -100.44264 SVE-3: 37.59871, -100.44252 SVE-4: 37.59883, -100.44229