
		RECORD		WWC-5		ivision of W	1			SVE-6		
		☐ Correction		ge in Well Use		sources App			Well ID			
		WATER WEL	L:	Fraction		ection Num	iber To	ownship Numb		ge Number		
	ty: Gray			SW 1/4 SW 1/4 SW 1/4	4 NE 1/4 24 T 28 S R 29 DE W Street or Rural Address where well is located (if unknown, distance and							
1	2 WELL OWNER: Last Name: Love First: Gregory C.											
	Business: Address: 24506 13 Road						direction from nearest town or intersection): If at owner's address, check here:					
	Address: 24500 15 Road						Montezur	ma				
City: Montezuma State: KS ZIP: 67867												
3 LOCA	3 LOCATE WELL 4 DEPTH OF COMPLETED WELL:						·	37 5990	0	(1 ' 11 -)		
WITH	WITH "A" IN Denth(s) Groundwater Encountered: 1)											
I	SECTION BOX: 9 3) 0 or 4)							tum: WGS 84				
WELL'S STATIC WATER LEVEL:								itude/Longitude		S L NAD 27		
below land surface, measured on (mo-day-					-yr)			make/model:				
NW-	NE			asured on (mo-day-yr)			(WAAS enabled? ☐ Yes ☐ No)					
Pump test data: Well wa						☐ Land Survey ☐ Topographic Map						
W	W after hours pumping Well water was											
sw	SW SE after hours pumping											
	Estimated Yield:			gnm			6 Elevation: 2779ft. ■ Ground Level □ TOC					
	S Bore Hole Diameter:			8.75 in to 144	Sour	Source: Land Survey GPS Topographic Map						
1	1 mile in. to ft.						☐ Other					
7 WELL WATER TO BE USED AS:												
1. Domestic				ter Supply: well ID				Vater Supply: le				
	☐ Household 6. ☐ Dewatering: how many wells?.											
	☐ Lawn & Garden 7. ☐ Aquifer Recharge: w											
Livest		8. .	Monitoring	g: well ID	SVF-6							
3. ☐ Feedle	2. ☐ Irrigation 9. Environmental Remediation: well II 3. ☐ Feedlot ☐ Air Sparge ■ Soil Vapor											
4. Indust		_	Recovery		SAUACTION							
4. ☐ Industrial ☐ Recovery ☐ Injection ☐ 13. ☐ Other (specify):												
Was a chemical bacteriological sample submitted to RDHE? Yes No 11 yes, date sample was submitted:												
8 TYPE OF CASING USED: ☐ Steel ■ PVC ☐ Other												
Casing diameter 4 in to 30 ft., Diameter 4 in to 140 ft., Diameter in to 150 ft.												
Casing height above land surface												
TYPE OF SCREEN OR PERFORATION MATERIAL:												
☐ Steel ☐ Stainless Steel ☐ Fiberglass ■ PVC ☐ Other (Specify)												
☐ Brass ☐ Galvanized Steel ☐ Concrete tile ☐ None used (open hole)												
SCREEN OR PERFORATION OPENINGS ARE:												
☐ Continuous Slot ■ Mill Slot ☐ Gauze Wrapped ☐ Torch Cut ☐ Drilled Holes ☐ Other (Specify)												
Louvered Shutter												
GRAVEL PACK INTERVALS: From 26 ft. to 144 ft., From ft. to ft., From ft. to ft.												
9 GROUT MATERIAL: Neat cement Cement grout Bentonite Other												
Grout Intervals: From												
Septic			ateral Lines	☐ Pit Privy	Г	Livestock P	ens	☐ Insectici	ide Storage			
Sewer			ess Pool	Sewage Lag	_	Fuel Storage		_	ned Water W	/ell		
	Watertight Sewer Lines ☐ Seepage Pit ☐ Feedyard ☐ Fertilizer Storage ☐ Oil Well/Gas Well											
Direction from well? Distance from well? ft.												
									ni i i a a ni a			
10 FROM	TO		THOLOG	IC LOG	FROM	TO		LOG (cont.) or l				
0	0.5	Concrete			61	73		sandy (vf-f),				
0.5	1.5	Sand (fill)	llaur Des		73	103		d Sand, f-c/f-i				
1.5	10	Clay, silty, Ye		vn	103	109		one, vf-c, V Lt				
10	14	Caliche, sand		andy Valley, P	109	144	Ciay and	d Sand, vf-c/f	-m gravel,	prown		
14	17			andy, Yellow Brn								
17	23	Sand, vf-f, Bro		follow Pro to Pro	Notes:	L						
23	52											
52 58 Sand, vf-f, v clayey, Lt. Brown to Brown 58 61 Caliche, sandy (vf-f), Tan to Lt. Gray												
11 CONTRACTOR'S OR LANDOWNER'S CERTIFICATION: This water well was constructed, reconstructed, or plugged												
under my ii	under my jurisdiction and was completed on (mo-day-year) .7/5/2017 and this record is true to the best of my knowledge and belief.											
Kansas Wa	ter Well Co	ntractor's Licen	se No57	7 This Wat	er Well Red	ord was co	mpleted 6	n (mo-day ye	ag) "7/31/20	21.7		
under the b	usiness nan	ne of .Ge.oCore	Inc		Si	gnature		114 166	<i>Z</i>	• • • • • • • • • • • • • • • • • • • •		
	Mail 1 white copy along with a fee of \$5.00 for each constructed well to: Kansas Department of Health and Environment, Bureau of Water, GWTS Section,											
1000 SW Jackson St., Suite 420, Topeka, Kansas 66612-1367. Mail one to Water Well Owner and retain one for your records. Telephone 785-296-5524. Visit us at http://www.kdheks.gov/waterwell/index.html KSA 82a-1212 Revised 7/10/2015												
Visit us at http	://www.kdhel	s.gov/waterwell/ind	ex.ntml		KSA 82a-12	12			Kevised /	/10/2015		

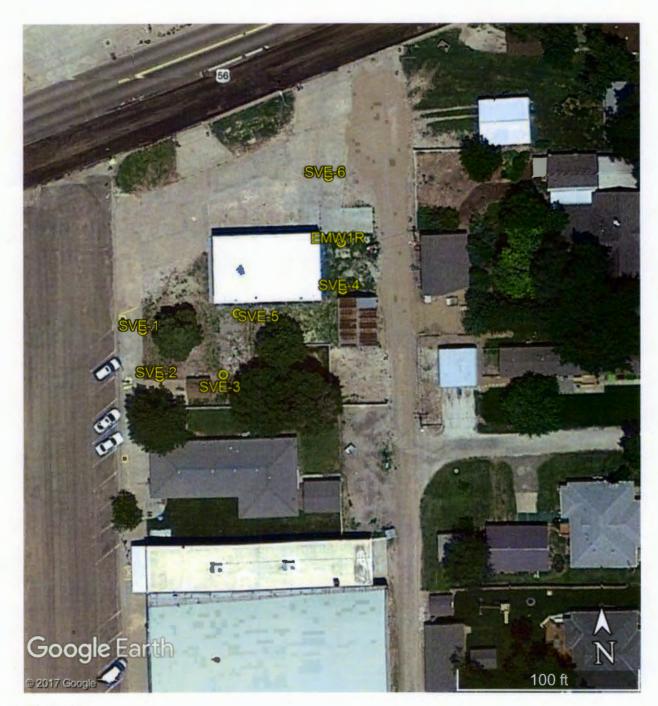

SVE-5: 37.59880, -100.44249

SVE-6: 37.59900, -100.44231

Evan's Tire Site 101 E. Texcoco St., Montezuma

GPS Coordinates:

EMW1R: 37.59890, -100.44229 SVE-1: 37.59878, -100.44267 SVE-2: 37.59871, -100.44264 SVE-3: 37.59871, -100.44252 SVE-4: 37.59883, -100.44229