

WATER WELL RECORD Form WWC-5

Original Record Correction Change in Well Use

Division of Water Resources App. No.

Well ID

1 LOCATION OF WATER WELL: County: Fraction Section Number Township Number Range Number

2 WELL OWNER: Last Name: Business: Address: City: State: ZIP: Street or Rural Address where well is located

3 LOCATE WELL WITH 'X' IN SECTION BOX: N E W S

4 DEPTH OF COMPLETED WELL: Depth(s) Groundwater Encountered: WELL'S STATIC WATER LEVEL:

5 Latitude: Longitude: Datum: Source for Latitude/Longitude: Elevation:

7 WELL WATER TO BE USED AS: 1. Domestic: 2. Irrigation: 3. Feedlot: 4. Industrial: 5. Public Water Supply: 6. Dewatering: 7. Aquifer Recharge: 8. Monitoring: 9. Environmental Remediation: 10. Oil Field Water Supply: 11. Test Hole: 12. Geothermal: 13. Other



Was a chemical/bacteriological sample submitted to KDHE? Water well disinfected?

8 TYPE OF CASING USED: CASING JOINTS: TYPE OF SCREEN OR PERFORATION MATERIAL: SCREEN OR PERFORATION OPENINGS ARE: SCREEN-PERFORATED INTERVALS: GRAVEL PACK INTERVALS:

9 GROUT MATERIAL: Grout Intervals: Nearest source of possible contamination: Direction from well? Distance from well?

Table with 6 columns: FROM, TO, LITHOLOGIC LOG, FROM, TO, LITHO. LOG (cont.) or PLUGGING INTERVALS

11 CONTRACTOR'S OR LANDOWNER'S CERTIFICATION: This water well was constructed, reconstructed, or plugged under my jurisdiction and was completed on (mo-day-year) and this record is true to the best of my knowledge and belief.

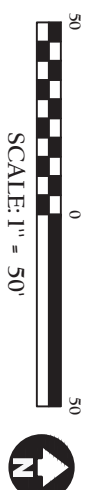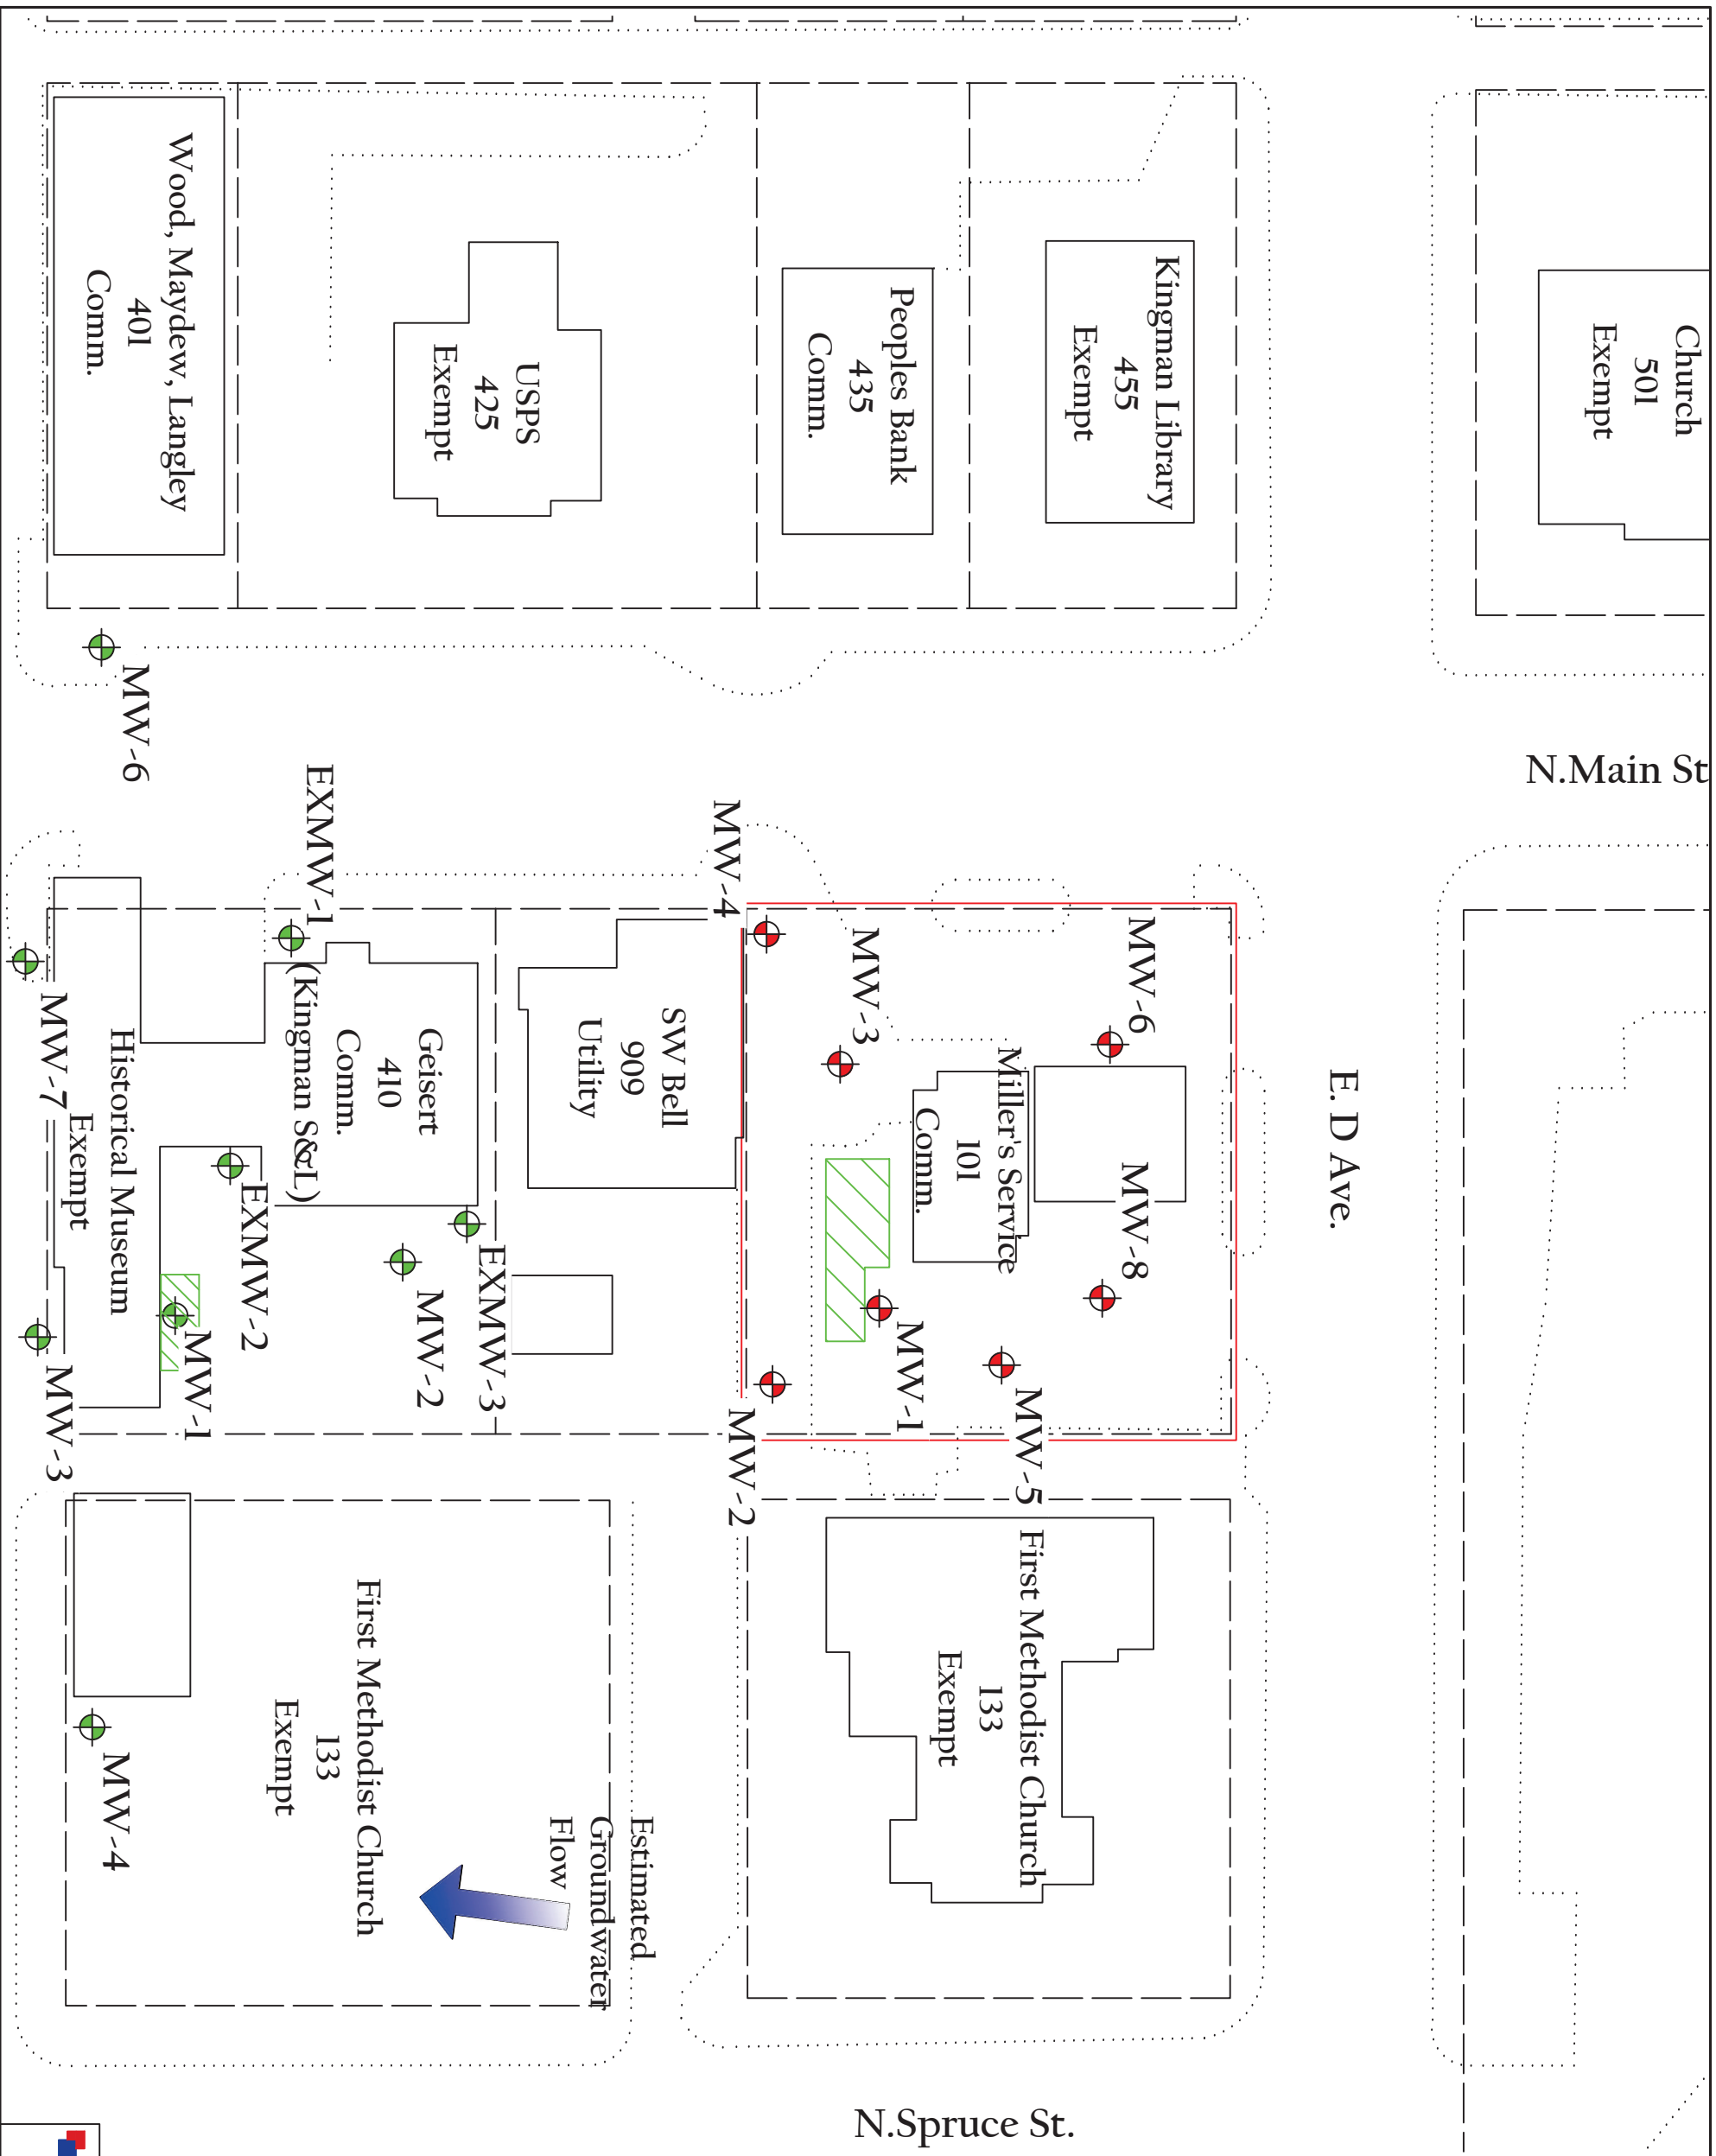

LEGEND

- = Approximate Site Boundary
 - = Kingman Co. Parcels
 - ◆ = Monitoring Wells
 - ◆ = Kingman S&L Monitoring Wells
 - ◆ = Plugged Well
 - = Soil Boring
 - = GeoTech Boring
 - = UST
 - = Overhead Electric (-20')
 - = Communication Line (-20')
 - = Gas Line (24" BGS)
 - = Water Line (30" BGS)
 - = Sewer Line (30-48" BGS)
- Pump Island & Product Line Locations are Unknown
- All locations and boundaries are approximate

JOB#: 1874244	DRAWN BY: CN
DATE: 2019-09-12	PROJ. MANGR: DR

Miller's Service
 KDHE #: U2-048-14993
 101 E. D Ave.
 Kingman, Kansas

SITE BASE MAP