
WATER WELL R				ision of water	20170167	Well ID Keece - Kitte		
Original Record		e in Well Use Fraction		ources App. No.	Township Numb	WEILID		
1 LOCATION OF W. County: Pratt	AIER WELL:	14 SE 14 SE 1/4	I .	ction Number 6	Township Numb	er Range Number R 12 🗆 E 🖪 W		
			Street or Rural Address where well is located (if unknown, distance and					
2 WELL OWNER: La Business:	ist Name: Reece	First: Merlin						
Address: 40128 SE						s address, check here. [_]		
Address:	3N of Sawyer, KS							
City: Sawver	City: Sawyer State: KS ZIP: 67530							
3 LOCATE WELL	4 DEPTH OF COM	DIETED WELL.	167 fr	5 Latituda		(4		
WITH "X" IN				1	5 Latitude:			
SECTION BOX:	Depth(s) Groundwater Encountered: 1)90 ft. 2) ft. 3) ft., or 4) \(\bigcup \) Dry We			Horizontal Datum: WGS 84 NAD 83 NAD 27				
N	WELL'S STATIC WA	TER LEVEL:9	0 ft.		r Latitude/Longitude			
	below land surface	, measured on (mo-day	-yr)07/20/17			·)		
NW NE	above land surface, measured on (mo-day-yr)				(WAAS enabled?			
	Pump test data: Well water was ft.			☐ Land Survey ☐ Topographic Map				
WE	after hours pumping gpm			☐ Onlir	Online Mapper:			
SW SE	Well water was ft.							
X	after hours pumping gpm			6 Elevation:ft. ☐ Ground Level ☐ TOC				
S	Estimated Yield:							
mile		in. to						
7 WELL WATER TO				1				
1. Domestic:		ter Supply: well ID		10. 🔳 Oil Fi	eld Water Supply: Is	ease Reece - Riffey		
Household	6. ☐ Dewaterin			11. Test Hole: well ID				
☐ Lawn & Garden	7. 🗌 Aquifer Re	echarge: well ID			Uncased □			
☐ Livestock	8. Monitoring: well ID					<i>i?</i>		
2. Irrigation	9. Environmental Remediation: well ID							
3. Feedlot	☐ Air Sparge ☐ Soil Vapor Extraction ☐ Dopen Loop ☐ Surface Discharge ☐ Inj. of Water							
4. Industrial	Recovery							
Was a chemical/bacter	iological sample subm	itted to KDHE? 🔲	Yes 📕 No	If yes, date sa	mple was submitte	d:		
Water well disinfected?								
8 TYPE OF CASING	USED: ☐ Steel ■ PV	C 🗌 Other	CASI	NG JOINTS:	Glued Clamped	d □ Welded □ Threaded		
Casing diameter 5 in. to 127 ft., Diameter in. to ft., Diameter in. to ft.								
Casing height above land surface								
TYPE OF SCREEN OR								
☐ Steel ☐ Stainless Steel ☐ Fiberglass ☐ PVC ☐ Other (Specify)								
☐ Brass ☐ Galvanized Steel ☐ Concrete tile ☐ None used (open hole)								
SCREEN OR PERFORATION OPENINGS ARE: Continuous Slot Mill Slot Gauze Wrapped Torch Cut Drilled Holes Other (Specify)								
☐ Continuous Slot ☐ Louvered Shutter	☐ Mill Slot ☐ G:☐ Key Punched ☐ W	ira Wrannad	oren Cut 1	None (Open Hole) Other (Specity)			
SCREEN DEDECT ATE	INTEDVALS: Erop	127 ft 167	ft From	one (Open Hole	ft From	ft to ft		
SCREEN-PERFORATED INTERVALS: From127								
9 GROUT MATERIAL: Neat cement Cement grout Bentonite Other								
Nearest source of possible contamination:								
Septic Tank	☐ Lateral Line	es 🔲 Pit Privy		Livestock Pens	☐ Insection	cide Storage		
☐ Sewer Lines	Cess Pool	☐ Sewage La		Fuel Storage		oned Water Well		
☐ Watertight Sewer Lin	☐ Watertight Sewer Lines ☐ Seepage Pit ☐ Feedyard ☐ Fertilizer Storage ☐ Oil Well/Gas Well							
☐ Other (Specify)								
10 FROM TO	LITHOLOG	GIC LOG	FROM	TO LI	THO. LOG (cont.) or	PLUGGING INTERVALS		
	op soil							
	clay				F 5 1111 6			
	imestone				erling Drilling Con	ıpany		
	lay				D Box 1006			
	mestone			Pra	att, KS 67124			
	olay							
	and and gravel		Notes:					
160 167 clay								
UL CONTRACTORIS OR LANDOWNERS CERTIFICATION. This was all to the second of the second								
II CONTRACTOR'S OR LANDOWNER'S CERTIFICATION: This water well was constructed, reconstructed, or plugged under my jurisdiction and was completed on (mo-day-year) .0.7/20/17 and this record is true to the best of my knowledge and belief.								
Kansas Water Well Contractor's License No. 186 This Water Well Record was completed on (mo-day-year) 07/125/17								
under the business name	of Kelly's Water We	ell Service, Inc.	Si	gnature	thum &	Han I		
Mail 1 white copy along with a fee of \$5.00 for each constructed well to: Kansas Department of Health and Environment, Bureau of Water, GWTS Section,								
1000 SW Jackson St	., Suite 420, Topeka, Kansas	66612-1367. Mail one to			or your records. Teleph	ione 785-296-5524.		
Visit us at http://www.kdheks.gov/waterwell/index.html KSA				212		Revised 7/10/2015		



ASSIGNMENT OF WATER WELL TO LANDOWNER

I, Merlin Reece	of 40128 SE 70th Street						
		(Landowner's add	(Landowner's address)				
Sawyer KS 67134 (City) (State) the SE quarter of the SE quarter		m the landowner on which a wate eSW quarter in Section 6					
Range 12 EW, in Pratt		County, Kansas which	is approximately				
200 feet north/south, and 28	20	feet east/west of the apparent	SE section				
corner. The water well was drilled in	_July 2	2017 (month	n/year).				
I hereby request that Sterling Drilling/Shelby Resources leave the water well, (Operator name)							
which was drilled by Temporary W	Vater P	Permit # <u>20170167</u> , unp	lugged, and I will				
assume all responsibility for the plugg	ging of	said water well in accordance wi	th the requirements				
of the Kansas Department of Health a	nd Env	ironment regulation K.A.R. 28-30	0-7.				
LANDOWNER:		OPERATOR:					
Marchene 9/41	17	Da Mil	02)30/17				
(Signature) (Date))	(Signature)	(Date)				
Merlin Reece (Print)	_	By: Gary M Talbott/ (Agent)	Sterling Drilling				
IF ADDITIONAL LANDOWNER							
			DECENTER				
(Signature) (Date	<u>.</u>		RECEIVED				
			SEP 11 2017				
(Print)			BUREAU OF WATER				
WWC-7 R/Geology/WWC forms – standard/ db 10/25/2012							

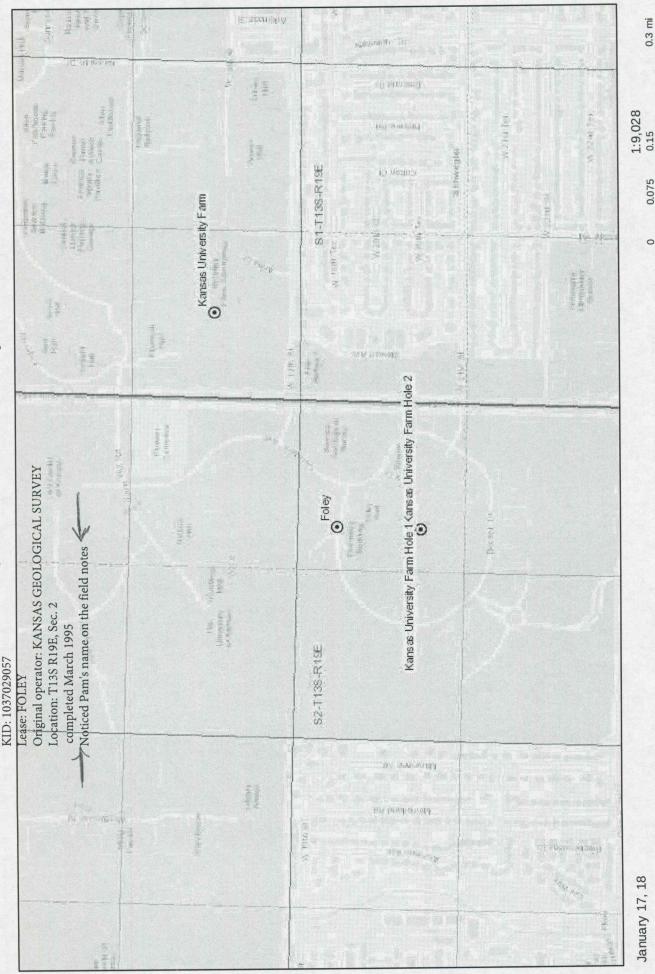

January 17, 18

Sources: Esri, HERE, DeLorme, Intermap, increment P Corp., GEBCO, USGS, FAO, NPS, NRCAN, GeoBase, IGN, Kadaster M., Ordnance Survey,

0.3 mi

0.075

0.4 km