


WATER WELL RECORD Form WWC-5 KSA 82a-1212

1 LOCATION OF WATER WELL: COUNTY: KIOWA Fraction NE 1/4 NW 1/4 SW 1/4 Section Number 1 Township Number T 30 S Range Number R 18 W

Distance and direction from nearest town or city street address of well if located within city? 2 MILES EAST, 10 MILES SOUTH OF GREENSBURG

2 WATER WELL OWNER: NICHOLS, GALEN RR#, St. Address, Box #: 1211 SOUTH MAIN City, State, ZIP code: GREENSBURG, KS 67054- Board of Agriculture, Division of Water Resources Application Number:

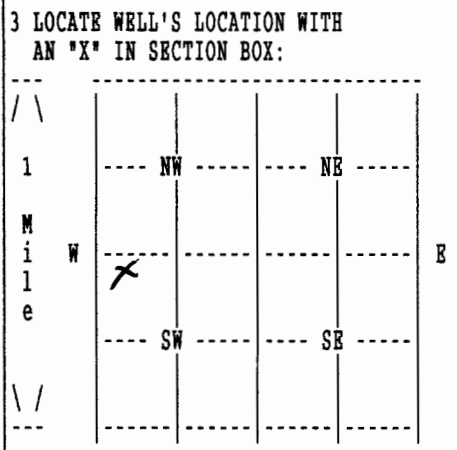

4 DEPTH OF COMPLETED WELL 68 ELEVATION: 0 Depth(s) Groundwater Encountered 1. 0 ft. 2. 0 ft. 3. 0 ft. WELL'S STATIC WATER LEVEL 16 ft. below land surface measured on mo/day/yr 08/20/05 Pump test data: Well water was 0 ft. after 0 hours pumping 0 gpm Estimated Yield 0 gpm: Well water was 0 ft. after 0 hours pumping 0 gpm Bore Hole Diameter 8.75 in. to 68 ft., and in. to 0 ft. WELL WATER TO BE USED AS: LIVESTOCK Was a chemical/bacteriological sample submitted to department? No; If yes, mo/day/yr sample was submitted Water well disinfected? Yes

5 TYPE OF BLANK CASING USED: PVC CASING JOINTS: GLUED Blank casing diameter 5 in. to 48 ft., Dia in. to 0 ft., Dia in. to 0 ft. Casing height above land surface 12 in., weight 0 lbs/ft. Wall thickness or gauge No. 26 TYPE OF SCREEN OR PERFORATION MATERIAL: PVC SCREEN OR PERFORATION OPENINGS ARE: SAW CUT

SCREEN PERFORATED INTERVALS: From 48 ft. to 68 ft., From 0 ft. to 0 ft. From 0 ft. to 0 ft., From 0 ft. to 0 ft. GRAVEL PACK INTERVALS: From 24 ft. to 68 ft., From 0 ft. to 0 ft. From 0 ft. to 0 ft., From 0 ft. to 0 ft.

6 GROUT MATERIAL BENTONITE Grout Intervals: From 4 ft. to 24 ft., From 0 ft. to 0 ft., From 0 ft. to 0 ft. What is the nearest source of possible contamination: SEPTIC TANK Direction from well? SOUTHEAST How many feet? 200

FROM	TO	LITHOLOGIC LOG	FROM	TO	PLUGGING INTERVALS
0	34	TAN CLAY			
34	68	BROWN SANDSTONE			
68	69	GRAY CLAY			

7 CONTRACTOR'S OR LANDOWNER'S CERTIFICATION: This water well was Constructed under my jurisdiction and was completed on (mo/day/year) 08/20/05 and this record is true to the best of my knowledge and belief. Kansas Water Well Contractor's License No. 653 This Water Well Record was completed on (mo/day/yr) 09/15/05 under the business name of DAN HAYSE WATER WELL SERV by (signature) Dan Hays