

WATER WELL RECORD

Form WWC-5

Division of Water Resources App. No.

20140031

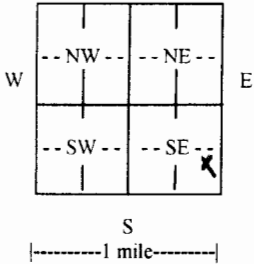
1 LOCATION OF WATER WELL: County: Clark	Fraction ¼ NE ¼ SE ¼ SE ¼	Section Number 23	Township No. T 30 S	Range Number R 22 <input type="checkbox"/> E <input checked="" type="checkbox"/> W
--	-------------------------------------	-----------------------------	-------------------------------	--

Street/Rural Address of Well Location; if unknown, distance & direction from nearest town or intersection: If at owner's address, check here .
7 1/2 South, 4 East of Kingsdown

Global Positioning System (GPS) information:
 Latitude: (in decimal degrees)
 Longitude: (in decimal degrees)
 Elevation:
 Datum: WGS 84, NAD 83, NAD 27
 Collection Method:
 GPS unit (Make/Model:)
 Digital Map/Photo, Topographic Map, Land Survey
 Est. Accuracy: <3 m, 3-5 m, 5-15 m, >15 m

2 WATER WELL OWNER: **Knighton Oil**
 RR#, Street Address, Box #: **1700 N. Waterfront Park Bldg 100**
 City, State, ZIP Code : **Wichita, KS 67206**

3 LOCATE WELL WITH AN "X" IN SECTION BOX:
N



4 DEPTH OF COMPLETED WELL **80** ft.
 Depth(s) Groundwater Encountered (1)..... ft. (2)..... ft. (3)..... ft.
 WELL'S STATIC WATER LEVEL **44** ft. below land surface measured on mo/day/yr. **1-21-14**.....
 Pump test data: Well water was ft. after hours pumping gpm
 EST. YIELD **N/A** gpm. Well water was ft. after hours pumping gpm
 Bore Hole Diameter **10** in. to **80** ft., and in. to ft.
 WELL WATER TO BE USED AS: Public water supply Geothermal Injection well
 Domestic Feedlot Oil field water supply Dewatering Other (Specify below)
 Irrigation Industrial Domestic-lawn & garden Monitoring well
 Was a chemical/bacteriological sample submitted to Department? Yes No
 If yes, mo/day/yr sample was submitted.....
 Water well disinfected? Yes No

5 TYPE OF CASING USED: Steel PVC Other
 CASING JOINTS: Glued Clamped Welded Threaded
 Casing diameter **5** in. to **80** ft., Diameter in. to ft., Diameter in. to ft.
 Casing height above land surface **18** in., Weight **SDR-26** lbs./ft., Wall thickness or gauge No.
 TYPE OF SCREEN OR PERFORATION MATERIAL:
 Steel Stainless Steel PVC Other (Specify)
 Brass Galvanized Steel None used (open hole)
 SCREEN OR PERFORATION OPENINGS ARE:
 Continuous slot Mill slot Gauze wrapped Torch cut Drilled holes None (open hole)
 Louvered shutter Key punched Wire wrapped Saw cut Other (specify)
 SCREEN-PERFORATED INTERVALS: From **80** ft. to **50** ft., From ft. to ft.
 GRAVEL PACK INTERVALS: From **80** ft. to **20** ft., From ft. to ft.
 From ft. to ft., From ft. to ft.

6 GROUT MATERIAL: Neat cement Cement grout Bentonite Other
 Grout Intervals: From ft. to ft., From **20** ft. to **0** ft., From ft. to ft.
 What is the nearest source of possible contamination:
 Septic tank Lateral lines Pit privy Livestock pens Insecticide storage Other (specify below)
 Sewer lines Cesspool Sewage lagoon Fuel storage Abandoned water well
 Watertight sewer lines Seepage pit Feedyard Fertilizer storage Oil well/gas well **None**
 Direction from well Distance from well

FROM	TO	LITHOLOGIC LOG	FROM	TO	LITHO. LOG (cont.) or PLUGGING INTERVALS
0	4	Top soil			
4	26	Small sand & gravel			
26	49	Cemented sand			
49	70	Sand & gravel/ streaks of clay			
70	80	Dark gray shale			

7 CONTRACTOR'S OR LANDOWNER'S CERTIFICATION: This water well was constructed, reconstructed, or plugged under my jurisdiction and was completed on (mo/day/year) **1-21-14** and this record is true to the best of my knowledge and belief. Kansas Water Well Contractor's License No. **134** This Water Well Record was completed on (mo/day/year) **2-10-14** under the business name of **Rosencrantz Bemis Ent Inc** by (signature) *[Signature]*

INSTRUCTIONS: Use typewriter or ball point pen. **PLEASE PRESS FIRMLY** and **PRINT** clearly. Please fill in blanks and check the correct answers. Send three copies (white, blue, pink) to Kansas Department of Health and Environment, Bureau of Water, Geology Section, 1000 SW Jackson St., Suite 420, Topeka, Kansas 66612-1367. Telephone 785-296-5524. Send one copy to WATER WELL OWNER and retain one for your records. Include fee of \$5.00 for each constructed well. Visit us at <http://www.kdheks.gov/waterwell/index.html>.



Bureau of Water - Geology & Well Technology Unit
1000 S. W. Jackson, Ste. 420
Topeka, KS 66612-1367
Phone 785-296-3565

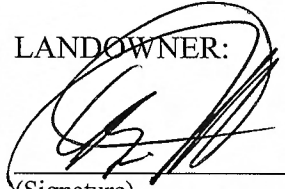
ASSIGNMENT OF WATER WELL TO LANDOWNER*
FORM WWC-7

I, Christopher B. Jeffries of 18223 Hinkel Rd
(Landowner) (Landowner address)

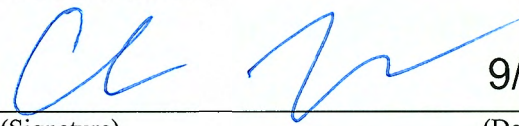
Cat Springs, TX 78933 am the landowner on which a water well is located in the
(City) (State)
1/4, NE 1/4, SE 1/4, SE 1/4, Section 23, Township 30 S, Range 22 E/W, in
Clark County, Kansas, and approximately 1000 feet N/S, and 300 feet E/W
of the apparent SE section corner. The water well was drilled in January, 2014 (month/year).

I hereby request that Knighton Oil Company, Inc. leave the water well,
(Well operator/owner name)

which was drilled under Temporary/Term Water Permit # 20140031, unplugged, and I will assume
all responsibility for properly maintaining said water well in accordance with the requirements of KDHE
regulations in K.A.R. 28-30-6 to 28-30-10, including requesting and maintaining said well in inactive
status and proper plugging when it is abandoned, in accordance with regulations in K.A.R. 28-30-7.

LANDOWNER:

(Signature) 9/1/21
(Date)

Christopher Brian Jeffries
(Print)

WELL OWNER:

(Signature) 9/1/2021
(Date)

By: Chris Toy, Knighton Oil Co. Inc.
(Agent)

IF ADDITIONAL LANDOWNER

(Signature) (Date)

(Print)

*Where the owner of a water well is not the landowner, KDHE regulations in Article 30 [K.A.R. 28-30-7(e)] allow responsibility for the well to be conveyed to the landowner in lieu of abandoning and plugging the well, but the well must conform to the requirements for active or inactive status. The transfer must be made through a legal document, approved by KDHE, advising the landowner of their responsibilities and obligations to properly maintain the well, including the proper plugging of the well when it is abandoned.

Landowners may obtain KDHE's written approval to maintain the well in an inactive status, in accordance with K.A.R. 28-30-7(f), rather than plugging it if the landowner can present evidence as to the well's condition and the landowner's intentions to use the well in the future.

A request for inactive water well status must be submitted to KDHE by completing Form WWC-6 in accordance with Procedure WWP-4. KDHE Water Well Program statutes, regulations, forms, and procedures are available at:
<http://www.kdheks.gov/waterwell/index.html>.

RECEIVED
OCT 7 2021
BUREAU OF WATER