
LOCATION OF WATER VELL: Fraction Section Number Towaship Number R.1 E.W R.1 R.1 E.W R.1	WATER WELL R				ision of Water		Well ID AMW-13	
Country-Summer NEX.								
Basiness FORMER AnDOS FOOD Shop Address: directed from encess to see or intersections. If all owner's address, check here: 119 W. 15th St., Wellington, KS Address: Status VEL Mellington Status KS ZP: 67152 3 NOT TAY NEL NELL ADDRESS ADDRESS ADDRESS VELL Status KS ZP: 67152 Incredit Address ADDRESS Complete Level KS To and the second complete Level KS Incredit Address SECTION BOX: Depth(s) Groundwater Encounter(f. 1) ft, 20 To and the second complete Level KS To and the second complete Level KS WH Well water wate: ft, 20 To and the second complete Level KS To and the second complete Level KS To and the second complete Level KS Second Complete Level KS Second Complete Level KS To and the second complete Level KS To and the second complete Level KS Second Complete Level KS Second Complete Level KS To and the second complete Level KS To and the second complete Level KS Second Complete Level KS Second Complete Level KS Second Complete Level KS To and the second complete Level KS Second Complete Level KS Second Complete Level KS Second Complete Level KS Sec								
Address: PD Box 96 Address: 119 W 15th St, Wellington, KS Cost: Wellington Success Vellington Success Vellington Success Vellington Success Vellington, KS N Depth(s) Groundwate Encontenset: 1) 1, no. N Depth(s) Groundwate Encontenset: 0) 1, no. N Depth(s) Groundwate Encontenset: 0, no. 1, no. N Address: Encontense 1, no. Human Encontense Statis: Ell address Vield:, no. 1, no. 1, no. N Statis: Ell address Vield:, no. 1, no. 1, no. 1, no. Densetic: S. Devettering Normany Vield:, no. 1, no. 1, no. 1, no. Devettering Normany Vield:, no. Statis: Ell address Statis: Ell addrestatis: Vell Montonennu vell D <								
Address 119 W. 19th St., Wellington, KS Co: Wellington Sate: KS 2P:67152 1 OCATE WELL WITH CATE WELL No 4 DEPTH OF COMPLETED WELL: -16, -1, -1, -1, -1, -1, -1, -1, -1, -1, -1	Address: PO Box 96							
3 LOCATE WELL WITH +*TN 4 DEPTH OF COMPLETED WELL: 16ft Depth(s) Groundwater Encounteed: 10ft, or 4/	Address: 119 W. 15th St., Wellington, KS							
WITH CY: NS b DEPTH OF COMPLETED WELL W.L. W.L. Model Complete Since 50/L and Complete Since),	State: KS ZIP: 67152	<u> </u>	·			
SECTION BOX: N Depth(s) Groundwater Encountered: 1) then the section of the sec								
N 2) Th. 3) Th. or 4) Dry Well -XW NE - W Well LS STATIC WATER LEVEL: The measured on (modery-p) The measured on (modery-p) W - NE - W Delaw land sariace, measured on (modery-p) The measured on (modery-p) The measured on (modery-p) W - NE - W Delaw land sariace, measured on (modery-p) The measured on (modery-p) The measured on (modery-p) W - W - W et als after, measured on (modery-p) The measured on (modery-p) The measured on (modery-p) The Measure measured on (modery-p) S The measured on (modery-p) The measured on (modery-p) The measured on (modery-p) The measured on (modery-p) S The measured on (modery-p) The measured on (modery-p) The measured on (modery-p) The measured on (modery-p) Notestic: S Polavier Recovery The measured on (modery-p) The measured on (modery-p) The measured on (modery-p) Lawn & Garden C Develop (Measure Measure) The measured on (modery-p) The measured on (modery-p) The measured on (modery-p) Lawn & Garden C Develop (Measure) The measured on (modery-p) The measured on (modery-p) The measured on (modery-p) Lawn & Garden C					Longitu	Longitude:		
Image: NW - NE -		N [2) ft. 3) ft., or 4) \Box Dry Well						
		WELL'S STATIC WATER LEVEL:						
w -stress Pump test data: Well water was ft. after -borsy sumpling _gpm stress -stress _gpm stress _gpm _gpm _gpm _gpm								
- SW SE Well water was ft. after		Pump test data: Well water was ft.			📕 Lan			
- String after	W E	after				Online Mapper:		
Estimated Yield:	SW SE	after					·····	
S Bore Hole Diameter: 9,25, in, to 16, m, to Statter: Law X Cher Topographic May 7 WELL WATER TO BE USED AS: 10 0 if Field Water Supply: leas 10 0 if Field Water Supply: leas 11 1 Lawn & Garden 7 August Field Recharge: well D 10 0 if Field Water Supply: leas 11 2 Irrigation 9 Environmental Remediation: well D 2 Geodehermat: how many bres? 2 2 Irrigation 9 Environmental Remediation: well D 3 0 ther (apecify): 3		Estimated Y	Estimated Yield:					
7 WELL WATER TO BE USED AS: Interview of the definition of	-	Bore Hole Diameter:						
1. Domestic: S								
□ Household 6. Dewatering: how many well? 11. Test Floic well D. □ Lawn & Garden 1. Agtifer Recharge: well D. □ Cased □ Loncased □ Geotechnical □ Livestock 8. Monitoring: well D. 13. □ Cased □ Loncased □ Geotechnical 3. □ Fordion 9. Davioremental Remediation: well D. 10. 10. 10. 3. □ Cost Davis Davis Soli Vapor Extraction 13. □ Other (specify):						Gald Water Sumpley	e05e	
□ Lavar, & Garden ?. □ Aquifer Recharge: well ID. □ Cased □								
2. □ Irrigation 9. Evvironmental Remediation: well ID		Lawn & Garden 7. Aquifer Recharge: well ID				Cased Uncased Geotechnical		
3								
4. □ Industrial □ Recovery □ Injection 13. □ Other (specify): Was a chemical/bacteriological sample submitted to KDHE? □ Yes No If yes, date sample was submitted: Water well disinfacted? □ Yes No If yes, date sample was submitted:								
Was a chemical/bacteriological sample submitted to KDHE? Yes No If yes, date sample was submitted: Water well disinfected? Yes No StyPE OF CASING USED: Steel PVC B tyPE OF CASING USED: Steel PVC Other CASING JOINTS: Glued Clamped Welded Threaded Casing diameter in. to the				I Extraction				
Water well disinfected? □ Yes ■ No 8 TYPE OF CASING USED: □ Steel ■ PVC □ Other … to								
8 TYPE OF CASING USED: □ steel ■ PVC □ Other □ CASING JOINTS: □ Giued □ Clamped □ Welded ■ Threaded Casing diameter								
Casing diameter	8 TYPE OF CASING USED: ☐ Steel ■ PVC ☐ Other CASING JOINTS: ☐ Glued ☐ Clamped ☐ Welded ■ Threaded							
TYPE OF SCREEN OR PERFORATION MATERIAL: □ Stainless Steel □ Fiberglass □ Brass □ Galvanized Steel □ Concrete tile □ None used (open hole) SCREEN OR PERFORATION OPENINGS ARE: □ Continuous Slot □ Mill Slot □ Cauze Wrapped □ Torch Cut □ Drilled Holes □ Other (Specify) □ Louvered Shutter □ Key Punched □ Wire Wrapped □ Saw Cut □ None (Open Hole) SCREEN-PERFORATED INTERVALS: From .f. to .f. f. f. From	Casing diameter 2 in to 16 ft Diameter in to ft Diameter in to ft							
□ Steel □ Fiberglass ■ PVC □ Other (Specify) □ □ Brass □ Galvanized Steel □ None used (open hole) □ □ Continuous Slot ■ Mill Slot □ Gauze Wrapped □ Torch Cut □ Drilled Holes □ Other (Specify)	Casing height above land surface							
□ Brass □ Galvanized Steel □ Concrete tile □ None used (open hole) SCREEN OR PERFORATION OPENINGS ARE: □ Torch Cut □ Drilled Holes □ Other (Specify) □ Louvered Shutter □ Key Punched □ Wire Wrapped □ Saw Cut □ None (Open Hole) SCREEN-PERFORATED INTERVALS: From .f. to .f. f. From .f. to .f. to GRAVEL PACK INTERVALS: From .f. to .f. f. From .f. to .f. to <td< td=""><td colspan="8"></td></td<>								
SCREEN OR PERFORATION OPENINGS ARE: Continuous Slot Mill Slot Gauze Wrapped Torch Cut Drilled Holes Other (Specify) Louverd Shutter Key Punched Wire Wrapped Saw Cut None (Open Hole) SCREEN-PERFORATED INTERVALS: From ft, to ft, From ft, to ft, ft, From GRAVEL PACK INTERVALS: From ft, to ft, ft, From ft, to ft, ft, From Grout Intervals: From ft, to ft, ft, From ft, ft, From ft, ft, From Grout Intervals: From ft, to ft,								
□ Louvered Shutter □ Key Punched □ Wire Wrapped □ Saw Cut □ None (Open Hole) SCREEN-PERFORATED INTERVALS: From								
SCREEN-PERFORATED INTERVALS: From								
GRAVEL PACK INTERVALS: From	Louvered Shutter Likey Punched Liwire Wrapped Li Saw Cut Li None (Open Hole)							
9 GROUT MATERIAL: □ Neat cement □ Cement grout ■ Bentonite □ Other Grout Intervals: From .f., From .f., From .f., From .f., From Nearest source of possible contamination: □ .f., From .f., From .f., From .f., From Septic Tank □ Lateral Lines □ Pit Privy □ Livestock Pens □ Insecticide Storage □ Sewer Lines □ Cess Pool □ Sewage Lagoon □ Fuel Storage □ Abandoned Water Well □ Other (Specify) Trust. Fund Site U2-Q6-D06968 □ Fredivard □ Fertilizer Storage □ Oil Well/Gas Well □ FROM TO LITHOLOGIC LOG FROM TO LITHO. LOG (cont.) or PLUGGING INTERVAL 0.5 Grass/soil □ □ .f. 0.5 I Silt, clayey, dk brown □ .f. 10 12.5 Sand, course grain, silty, grey □ .f. 12.5 16 Weathered Shale, grey to It grey brittle □ .f. 10 12.5 Sand, course grain, silty. grey □ .f. 11 CONTRACTOR'S OR LANDOWNER'S CERTIFICATION: This water well was ∎ constru	GRAVEL PACK INTERVALS: From 4 + to 16 + From + to - + From + + From + to - + From + to - + From + + Fr							
Grout Intervals: From 1 ft. to 4 ft. From Freitilizer Storage ft. From Freitilizer Storage ft. From Freitilizer Storage ft. From ft. From ft. From Freitilizer Storage ft. From	9 GROUT MATERIAL: □ Neat cement □ Cement grout ■ Bentonite □ Other							
Nearest source of possible contamination:	Grout Intervals: From							
Sewer Lines □ Cess Pool □ Sewage Lagoon □ Fuel Storage □ Abandoned Water Well □ Other (Specify) Trust.Fund site □ Seoge Pit □ Feedyard □ Fertilizer Storage □ Oil Well/Gas Well □ Other (Specify) Trust.Fund site □ Seoge Obe96 □ Fertilizer Storage □ Oil Well/Gas Well □ other (Specify) Trust.Fund site □ Seoge Obe96 □ From well? 0. 0.1 Well/Gas Well □ other (Specify) Trust.Fund site □ Seoge Obe96 □ From well? 0. 0.1 Well/Gas Well □ other (Specify) Trust.Fund site □ Seoge Obe96 □ From well? 0. 0.1 Well/Gas Well □ other (Specify) Trust.Fund site □ Seoge Obe96 □ 12.5 16 Weathered Shale. grey to It grey brittle □ Seoge Obe96 □ Seoge0 Obe96 □ Seoge Obe96 □ S	Nearest source of possible contamination:							
□ Watertight Sewer Lines □ Seepage Pit □ Feedyard □ Fertilizer Storage □ Oil Well/Gas Well ■ Other (Specify) Trust Fund site U2-096-00696								
Other (Specify) Trust Fund site U2-096-00696 Direction from well? On-site Distance from well? 0 IITHOLOGIC LOG FROM TO LITHOLOG (cont.) or PLUGGING INTERVAL O O O.5 Grass/soil O S I O Silt, clayey, dk brown I O I2.5 Sand, course grain, silty, grey I2.5 I6 Weathered Shale, grey to lt grey brittle TD I6 I I CONTRACTOR'S OR LANDOWNER'S CERTIFICATION: This water well was Constructed, □ reconstructed, or □ plugged under my jurisdiction and was completed on (mo-day-year) 7/15/19 Mail I white copy along with a fee of \$5.00 for each constructed well to: Kansas Department of Health and Entiported Bureau of Water, GWTS Section, 100 SW Jackson St., Suite 420, Topeka, Kansas 66612-1367. Mail one to Water Well Owner and retain one for your records. Telephone 785-296-5524.								
Direction from well? On-site Distance from well? Q ft. 10 FROM TO LITHOLOGIC LOG FROM TO LITHO. LOG (cont.) or PLUGGING INTERVAL 0 0.5 Grass/soil Image: Construct of	Other (Specify) Jrust Eund site U2-096-00696							
0 0.5 Grass/soil Interview of the set of the	Direction from well? .On							
0.5 10 Silt, clayey, dk brown 10 12.5 Sand, course grain, silty, grey 12.5 16 Weathered Shale, grey to lt grey brittle TD 16 Notes: Amoco Food Shop, U2-096-00696 Il CONTRACTOR'S OR LANDOWNER'S CERTIFICATION: This water well was ■ constructed, □ reconstructed, or □ plugged under my jurisdiction and was completed on (mo-day-year).7/15/19 and this record is true to the best of my knowledge and belief. Kansas Water Well Contractor's License No. 585			LITHOLOGIC LOG	FROM	TO L	ITHO. LOG (cont.) o	or PLUGGING INTERVAL	
10 12.5 Sand. course grain. silty. grey 12.5 16 Weathered Shale. grey to it grey brittle TD 16 Notes: Amoco Food Shop, U2-096-00696 II CONTRACTOR'S OR LANDOWNER'S CERTIFICATION: This water well was constructed, irreconstructed, or irreconstructed, irreconstructed, or irreconstructed, or irreconstructed, irreconstructed, or irreconstructed, irreconstructed, or irreconstructed, irreconstructed, or irreconstructed, or irreconstructed, or irreconstructed, irreconstructed, or irreconstructed, or irreconstructed, or irreconstructed, irreconstructed, or irreconstructed, irreconstructed, or irreconstructed, irreconstructed, or irreconstructed, irreconstructed, irreconstructed, or irreconstructed, irreconstructed, or irreconstructed, irreconstructed, or irreconstructed, or irreconstructed, irreconstructed, or irreconstructed, or irreconstructed, or irreconstructed, irreconstructed, or irreconstructed, irreconstructed, or			die brown			<u> </u>		
12.5 16 Weathered Shale, grey to it grey brittle TD 16 Notes: Amoco Food Shop, U2-096-00696 Interview Interview Interview Interview </td <td></td> <td></td> <td></td> <td></td> <td><u> </u></td> <td></td> <td></td>					<u> </u>			
TD 16 Image: Notes: Amoco Food Shop, U2-096-00696 Image: Not					<u> </u>			
Image: Notes: Amoco Food Shop, U2-096-00696 In CONTRACTOR'S OR LANDOWNER'S CERTIFICATION: This water well was in constructed, in reconstructed, or in plugged under my jurisdiction and was completed on (mo-day-year). Inder my jurisdiction and was completed on (mo-day-year). 7/1.5/.19				·	<u>├</u>			
11 CONTRACTOR'S OR LANDOWNER'S CERTIFICATION: This water well was constructed, reconstructed, or plugged under my jurisdiction and was completed on (mo-day-year). 7/15/19 and this record is true to the best of my knowledge and belief. Kansas Water Well Contractor's License No. 585					<u>├</u> ────────			
under my jurisdiction and was completed on (mo-day-year) .7/15/19 and this record is true to the best of my knowledge and belief. Kansas Water Well Contractor's License No. 585			Notes: Amoco Food Shop, U2-096-00696					
under my jurisdiction and was completed on (mo-day-year) .7/15/19 and this record is true to the best of my knowledge and belief. Kansas Water Well Contractor's License No. 585								
under my jurisdiction and was completed on (mo-day-year) .7/15/19 and this record is true to the best of my knowledge and belief. Kansas Water Well Contractor's License No. 585								
Kansas Water Well Contractor's License No. 585	11 CONTRACTOR'S	o UK LAND	UWNER'S CERTIFICATIO	JN: This wate	this record is	constructed, \Box rec	onstructed, or ∐ plugged	
under the business name of Associated Environmental. Inc	Kansas Water Well Con	ntractor's Lic	ense No. 585 This V	Vater Well Re	cord was comp	leted on mo-day-	year) 7/31/19	
1000 SW Jackson St., Suite 420, Topeka, Kansas 66612-1367. Mail one to Water Well Owner and retain one for your records. Telephone 785-296-5524.	under the business nam	e of Associ	ated Environmental. Inc.	Si	ignature	La Staling		
				KSA 82a-12		for your records. Telep	Revised 7/10/2015	

514-32-1W NE NG NW NW Summer

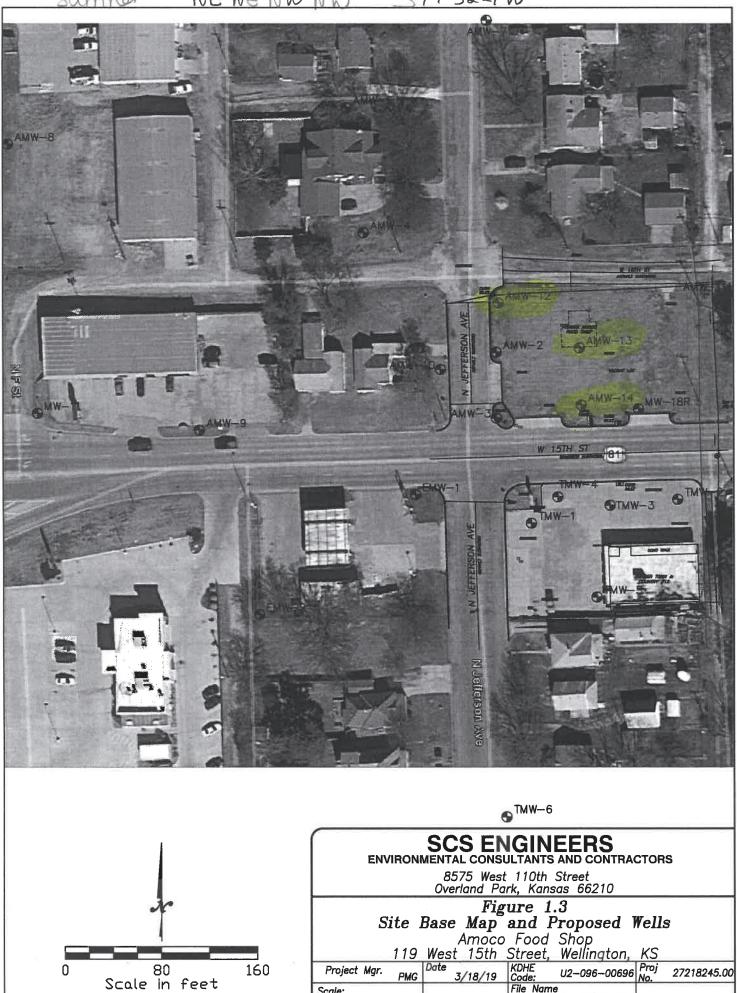

Scale:

File Name Amoco SSA Rpt.dwg