
		RECORD Correction		WWC-5 ge in Well Use		rision of Wate	<u> </u>	Well ID AS10	
				Fraction		ources App. Notion Number			
1 LOCATION OF WATER WELL: Fraction County: Sumner NE 1/4 NE 1/4 NE					1 1 1 2				
	OWNER:	ast Name:		First:	Street or Rural Address where well is located (if unknown, distance and				
		County Road	& Bridge	/ Shop	direction from nearest town or intersection): If at owner's address, check here:				
Address: 206 E. Botkin Street Address:									
City:	Wellingto	n	State: KS	ZIP: 67152					
3 LOCAT		1			20 0		- 27 2526	0	
WITH "				PLETED WELL:				0 (decimal degree	
	ON BOX:			Encountered: 1) 3) ft., or 4)					
				TER LEVEL:			e for Latitude/Longitude		21
				, measured on (mo-day			PS (unit make/model:	Spectra Precision Ep	(O.)
				, measured on (mo-day		.	(WAAS enabled? □	Yes No)	,
Pump test data: Well v							☐ Land Survey ☐ Topographic Map		
				s pumpingvater was					• • • • •
				numning ann			4400.74		_
Estimated Yield:			ield:	gpm			6 Elevation: 1183.71		
S Bore Hole Diameter:			- In to make the tild			Source: Land Survey GPS Topographic Map			
1 mile in. to ft.									•••
7 WELL WATER TO BE USED AS:									
1. Domestic: 5. Public Water Supply: well ID									
☐ Household 6. ☐ Dewatering: how many wells? ☐ Lawn & Garden 7. ☐ Aquifer Recharge: well ID						11. Test Hole: well ID ☐ Cased ☐ Uncased ☐ Geotechnical			
☐ Livestock Aquiter Recharge: Well ID						12. Geothermal: how many bores?			
2. Irrigation 9. Environmental Remediation: well II					D A\$10	a) Closed Loop Horizontal Vertical			
3. ☐ Feedlot ☐ Soil Vapor					Extraction	b) Open Loop Surface Discharge Inj. of Water			
4. 🔲 Indust	rial		Recovery	☐ Injection		13. 🔲 Otl	her (specify):		
Was a chemical/bacteriological sample submitted to KDHE? Yes No If yes, date sample was submitted:									
Water well disinfected? ☐ Yes ■ No									
8 TYPE OF CASING USED: ☐ Steel ☐ PVC ☐ Other									
Casing diameter 2 in. to 17.5 ft., Diameter in. to ft., Diameter in. to ft. Casing height above land surface8.16 in. Weight lbs./ft. Wall thickness or gauge No. Sch. 40									
TYPE OF SCREEN OR PERFORATION MATERIAL:									
☐ Steel ☐ Stainless Steel ☐ Fiberglass ■ PVC ☐ Other (Specify)									
☐ Brass ☐ Galvanized Steel ☐ Concrete tile ☐ None used (open hole)									
SCREEN OR PERFORATION OPENINGS ARE:									
☐ Continuous Slot ■ Mill Slot ☐ Gauze Wrapped ☐ Torch Cut ☐ Drilled Holes ☐ Other (Specify)									
☐ Louvered Shutter ☐ Key Punched ☐ Wire Wrapped ☐ Saw Cut ☐ None (Open Hole) SCREEN-PERFORATED INTERVALS: From									
GRAVEL PACK INTERVALS: From									
9 GROUT MATERIAL: ☐ Neat cement ☐ Cement grout ☐ Bentonite ☐ Other									
Nearest source of possible contamination:									
☐ Septic Tank ☐ Lateral Lines ☐ Pit Privy ☐ Livestock Pens ☐ Insecticide Storage									
☐ Sewer Lines ☐ Cess Pool ☐ Sewage Lagoon ☐ Fuel Storage ☐ Abandoned Water Well									
□ Watertight Sewer Lines □ Seepage Pit □ Feedyard □ Fertilizer Storage □ Oil Well/Gas Well ■ Other (Specify) .Remedial.site									
Direction from well?									
10 FROM	TO		ITHOLO		FROM			PLUGGING INTERVAL	LS
0	4	Clay, silty, B							
4	18	Sand (fill), f-			_				
18	20	Sand/Silt, vf-	c w/f grav	vel, clayey					
	 				Notes:			- · · · · · · · · · · · · · · · · · · ·	
Titles.									
11 CONTRACTOR'S OR LANDOWNER'S CERTIFICATION: This water well was constructed, reconstructed, or plugged									
under my jurisdiction and was completed on (mo-day-year) .10/19/2020 and this record is true to the best of my knowledge and belief.									
Kansas Water Well Contractor's License No. 527. This Water Well Record was completed on (mg-day year) .10/29/2020 under the business name of GeoCore LLC. Signature									
Mail 1 white copy along with a fee of \$5.00 for each constructed well to: Kansas Department of Health and Environment, Bureau of Water, GWTS Section,									
1000 SW Jackson St., Suite 420, Topeka, Kansas 66612-1367. Mail one to Water Well Owner and retain one for your records. Telephone 785-296-5524.									
Visit us at http://www.kdheks.gov/waterwell/index.html KSA 82a-1212 Revised 7/10/201									

Visit us at http://www.kdheks.gov/waterwell/index.html

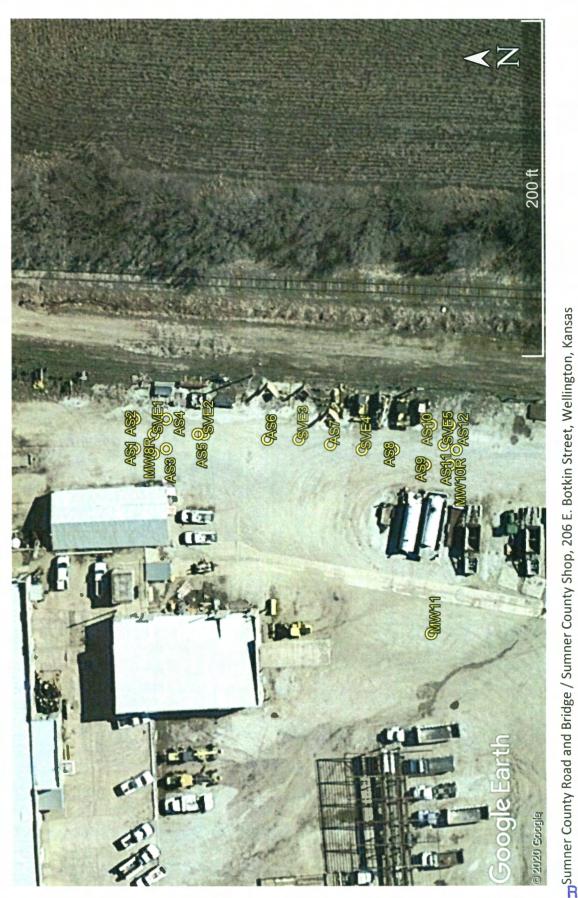

TKDHE Project Code: U2-096-00881 / A2-096-40065 О Surveyed)

37.25291, -97.39495 AS7: AS8: AS9: 37.25297, -97.39492 37.25297, -97.39486 37.25292, -97.39492 37.25292, -97.39486

37.25276, -97.39490 37.25256, -97.39492 37.25266, -97.39491

SVE3: 37.25271, -97.39490 SVE2: 37.25286, -97.39489 37.25251, -97.39495 AS11: 37.25247, -97.39495 AS10: 37.25250, -97.39487

37.25261, -97.39492 37.25248, -97.39491 SVE4: SVE5:

37.25294, -97.39489

37.25250, -97.39487

AS10:

37.25287, -97.39489

AS4: AS3:

AS5:

37.25247, -97.39487

AS12: SVE1:

APR 2 7 2021

AAS1: QAS2: