
WATER WELL R Original Record		Form WWC-5 Change in Well Use			on of Water ces App. No		Well ID	AS11	
1 LOCATION OF W	OCATION OF WATER WELL: Fraction				n Number	Township Number Range Number			
County: Sumner NE 1/4 NE 1/4 NE 1/4 2 WELL OWNER: Last Name: First:									
2 WELL OWNER: L Business: Sumner C Address: 206 E. Bo Address: City: Wellington		Street or Rural Address where well is located (if unknown, distance and direction from nearest town or intersection): If at owner's address, check here:							
3 LOCATE WELL		tate: KS ZIP: 67152	- 20			27.2524	7		
WITH "X" IN		OF COMPLETED WELL undwater Encountered: 1)							
SECTION BOX:	Depth(s) Groundwater Encountered: 1)				Horizontal Datum: WGS 84 NAD 83 NAD 27				
	1	TIC WATER LEVEL:							
NWNE		nd surface, measured on (mo-d nd surface, measured on (mo-d						ecisiou ⊏bo∵)	
NW NE	Pump test dat			☐ Land Survey ☐ Topographic			0)		
W X E	after	after hours pumping gpm Well water was ft.				☐ Online Mapper:			
SW SE	after	after hours pumping gpm				4404.40			
	Estimated Yie	Estimated Yield:gpm				6 Elevation: 1184.12			
S mile	Bore Hole Dia	Bore Hole Diameter:			Source: Land Survey GPS Topographic Map Other				
7 WELL WATER TO BE USED AS:									
1. Domestic:	5. Public Water Supply: well ID					Field Water Supply: le			
☐ Household ☐ Lawn & Garden									
Livestock		7. Aquifer Recharge: well ID				rmal: how many bores			
2. Irrigation	9. Env	9. Environmental Remediation: well ID .			a) Closed Loop				
3. ☐ Feedlot 4. ☐ Industrial		or Extraction	l	b) Open Loop					
4. ☐ Industrial ☐ Recovery ☐ Injection 13. ☐ Other (specify):									
Water well disinfected? Yes No									
8 TYPE OF CASING USED: ☐ Steel ■ PVC ☐ Other									
Casing diameter 2 in. to 17.5 ft., Diameter in. to ft., Diameter in. to ft. Casing height above land surface 10.92 in. Weight lbs./ft. Wall thickness or gauge No. Sch. 40									
TYPE OF SCREEN OR PERFORATION MATERIAL:									
☐ Steel ☐ Stainless Steel ☐ Fiberglass ☐ PVC ☐ Other (Specify)									
☐ Brass ☐ Galvanized Steel ☐ Concrete tile ☐ None used (open hole) SCREEN OR PERFORATION OPENINGS ARE:									
☐ Continuous Slot ■ Mill Slot ☐ Gauze Wrapped ☐ Torch Cut ☐ Drilled Holes ☐ Other (Specify)									
☐ Louvered Shutter ☐ Key Punched ☐ Wire Wrapped ☐ Saw Cut ☐ None (Open Hole)									
SCREEN-PERFORATED INTERVALS: From17.5. ft. to20									
9 GROUT MATERIAL: ☐ Neat cement ☐ Cement grout ■ Bentonite ☐ Other									
Grout Intervals: From									
Nearest source of possible contamination:									
☐ Septic Tank ☐ Lateral Lines ☐ Pit Privy ☐ Livestock Pens ☐ Insecticide Storage ☐ Sewer Lines ☐ Cess Pool ☐ Sewage Lagoon ☐ Fuel Storage ☐ Abandoned Water Well									
☐ Watertight Sewer Lines ☐ Seepage Pit ☐ Feedyard ☐ Fertilizer Storage ☐ Oil Well/Gas Well									
☐ Other (Specify) Remedial site									
10 FROM TO	LI	THOLOGIC LOG	FRO			ITHO. LOG (cont.) or		3 INTERVALS	
	Clay, silty, Bro								
		gravel, Brown silty, sl. clayey, Gray Bro	wn						
20	Sand, VI-C, V.	sity, st. clayey, Cray Dio	74411						
						-			
			NY = 4						
Notes:									
11 CONTRACTOR'S OR LANDOWNER'S CERTIFICATION: This water well was constructed, reconstructed, or plugged									
under my jurisdiction and was completed on (mo-day-year) .10/19/2020 and this record is true to the best of my knowledge and belief. Kansas Water Well Contractor's License No. 527 This Water Well Record was completed on mo-day-year) .10/29/2020									
under the business name of GeoCore, LLC. Signature Signature									
Mail 1 white copy along with a fee of \$5.00 for each constructed well to: Kansas Department of Health and Environment, Bureau of Water, GWTS Section, 1000 SW Jackson St., Suite 420, Topeka, Kansas 66612-1367. Mail one to Water Well Owner and retain one for your records. Telephone 785-296-5524.									
Visit us at http://www.kdheks.gov/waterwell/index.html KSA 82a-1212 Revised 7/10/2015								7/10/2015	

Visit us at http://www.kdheks.gov/waterwell/index.html

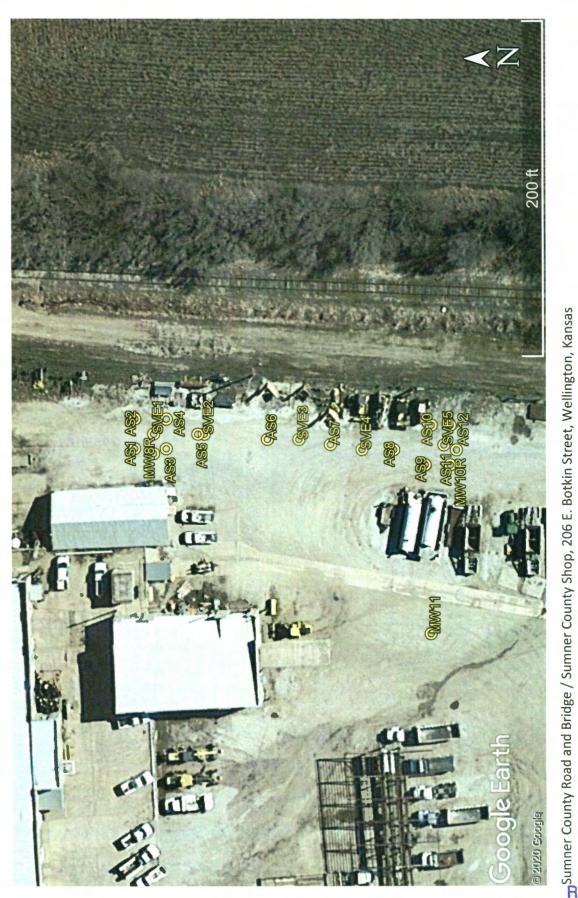

TKDHE Project Code: U2-096-00881 / A2-096-40065 О Surveyed)

37.25291, -97.39495 AS7: AS8: AS9: 37.25297, -97.39492 37.25297, -97.39486 37.25292, -97.39492 37.25292, -97.39486

37.25276, -97.39490 37.25256, -97.39492 37.25266, -97.39491

SVE3: 37.25271, -97.39490 SVE2: 37.25286, -97.39489 37.25251, -97.39495 AS11: 37.25247, -97.39495 AS10: 37.25250, -97.39487

37.25261, -97.39492 37.25248, -97.39491 SVE4: SVE5:

37.25294, -97.39489

37.25250, -97.39487

AS10:

37.25287, -97.39489

AS4: AS3:

AS5:

37.25247, -97.39487

AS12: SVE1:

APR 2 7 2021

AAS1: QAS2: