
| WATER WELL P | | Form WW | | Divi | ision of Water | • | | AS1 | |
|---|-------------------|--|-----------------|--|---------------------------------|---|--------------|-------------------|--|
| Original Record | | ☐ Change in W | | | urces App. No | | Well ID | | |
| 1 LOCATION OF W | 'ATER WEL | | | | tion Number | | | ge Number | |
| County: Sumner | | | 4 NE 1/4 NE 1/4 | | 23 | T 32 S | | E ■ W | |
| 2 WELL OWNER: Last Name: First: Street or Rural Address where well is located (if unknown, distance and | | | | | | | | | |
| Business: Sumner County Road & Bridge / Shop Address: 206 E. Botkin Street direction from nearest town or intersection): If at owner's address, check here: | | | | | | | | | |
| Address: | | | | | | | | | |
| City: Wellingto | n | State: KS ZIP: | 67152 | | | | | | |
| 3 LOCATE WELL | 4 DEPTH | OF COMPLE | TED WELL: | 20 ਜ | 5 Lotitu | de: 37.2529 | 7 | (decimal degrees) | |
| WITH "X" IN | | oundwater Encour | | | | ude: -97.394 | | | |
| SECTION BOX: | | ft. 3) | | | Horizon | ntal Datum: WGS 8 | 4 ■ NAD | 83 NAD 27 | |
| <u> </u> | WELL'S ST | WELL'S STATIC WATER LEVEL: ft. Source for Latitude/Longitude | | | | | | | |
| | | and surface, measi | □GP | GPS (unit make/model:Spectra Precision Epo.) | | | | | |
| NW NE | | and surface, measu | | | L. | (WAAS enabled? ☐ Yes ■ No) | | | |
| W L | | ata: Well water w | | | ☐ Land Survey ☐ Topographic Map | | | | |
| | arter | after hours pumping gpm | | | | | | | |
| SW SE | after | after hours numning ann | | | | | | | |
| | Estimated Y | ield:gpr | n | | | 6 Elevation: 1185.49 ft. ☐ Ground Level ☐ TOC | | | |
| S | Bore Hole I | Diameter:8 | . in. to∠У | . ft. and | Source | Source: Land Survey GPS Topographic Map Other | | | |
| 1 mile in. to ft. | | | | | | | | | |
| 7 WELL WATER TO 1. Domestic: | | | value quali IIN | | 10 🗆 🗠 | Field Water Committee 1. | 9954 | | |
| ☐ Household | | 5. ☐ Public Water Supply: well ID | | | | 10. Oil Field Water Supply: lease | | | |
| ☐ Lawn & Garden | | 7. Aquifer Recharge: well ID | | | | ☐ Cased ☐ Uncased ☐ Geotechnical | | | |
| Livestock | | Monitoring: wel | | | | ermal: how many bore | | | |
| 2. Irrigation | | vironmental Rem | | a) Closed Loop | | | | | |
| 3. Feedlot | | Air Sparge | | extraction | | en Loop 🔲 Surface Di | | | |
| 4. Industrial Recovery Injection 13. Other (specify): | | | | | | | | | |
| Was a chemical/bacteriological sample submitted to KDHE? ☐ Yes ■ No If yes, date sample was submitted: | | | | | | | | | |
| Water well disinfected? ☐ Yes ■ No | | | | | | | | | |
| 8 TYPE OF CASING USED: ☐ Steel ☐ PVC ☐ Other | | | | | | | | | |
| Casing diameter 2 in to 17.5 ft., Diameter in to ft., Diameter in to ft., Diameter in to Sch. 40. | | | | | | | | | |
| TYPE OF SCREEN OR PERFORATION MATERIAL: | | | | | | | | | |
| ☐ Steel ☐ Stainless Steel ☐ Fiberglass ■ PVC ☐ Other (Specify) | | | | | | | | | |
| ☐ Brass ☐ Galvanized Steel ☐ Concrete tile ☐ None used (open hole) | | | | | | | | | |
| SCREEN OR PERFORATION OPENINGS ARE: | | | | | | | | | |
| ☐ Continuous Slot ☐ Mill Slot ☐ Gauze Wrapped ☐ Torch Cut ☐ Drilled Holes ☐ Other (Specify) | | | | | | | | | |
| □ Louvered Shutter □ Key Punched □ Wire Wrapped □ Saw Cut □ None (Open Hole) SCREEN-PERFORATED INTERVALS: From | | | | | | | | | |
| GRAVEL PACK INTERVALS: From 10. ft. to 20. ft., From ft. to ft., From ft. to ft. | | | | | | | | | |
| 9 GROUT MATERIAL: Neat cement Cement grout Bentonite Other | | | | | | | | | |
| Grout Intervals: From | | | | | | | | | |
| Nearest source of possible contamination: | | | | | | | | | |
| ☐ Septic Tank ☐ Lateral Lines ☐ Pit Privy ☐ Livestock Pens ☐ Insecticide Storage | | | | | | | | | |
| ☐ Sewer Lines ☐ Cess Pool ☐ Sewage Lagoon ☐ Fuel Storage ☐ Abandoned Water Well | | | | | | | | | |
| ☐ Watertight Sewer Lines ☐ Seepage Pit ☐ Feedyard ☐ Fertilizer Storage ☐ Oil Well/Gas Well ☐ Other (Specify) .Remedial.site | | | | | | | | | |
| Direction from well? | | | | | | | | | |
| 10 FROM TO | | ITHOLOGIC LO | | FROM | | LITHO. LOG (cont.) or | | GINTERVALS | |
| | Clay, silty, B | | | | | | | | |
| | | gravel, Brown | | | ···· | | | | |
| | | ly (vf-f), Gray | | | | | | | |
| | | | | | | | _ | | |
| | | | | | | | | | |
| | | | | | | | | | |
| | | | | Notes: | | | | | |
| | | | | | | | | | |
| 11 CONTRACTORS OF LANDOWNERS CERTIFICATION TIL. | | | | | | | | | |
| 11 CONTRACTOR'S OR LANDOWNER'S CERTIFICATION: This water well was constructed, reconstructed, or plugged under my jurisdiction and was completed on (mo-day-year) .10/21/2020 and this record is true to the best of my knowledge and belief. | | | | | | | | | |
| Kansas Water Well Co | ntractor's Lice | ense No52/ | This Wa | ter Well Rec | ord was com | nleted on (pag-day-y | ear) .111/29 | /2020 | |
| under the business nam | e of GeoCo | re. LLC | | Sig | nature | ICU VOXI | | | |
| Mail 1 white copy along with a fee of \$5.00 for each constructed well to: Kansas Department of Health and Environment, Bureau of Water, GWTS Section, | | | | | | | | | |
| 1000 SW Jackson St., Suite 420, Topeka, Kansas 66612-1367. Mail one to Water Well Owner and retain one for your records. Telephone 785-296-5524. Visit us at http://www.kdheks.gov/waterwell/index.html KSA 82a-1212 Revised 7/10/2015 | | | | | | | | | |
| Visit us at http://www.kdhek | s.gov/waterwell/i | ndex.html | | KSA 82a-12 | 14 | | REVISEO | //10/2013 | |

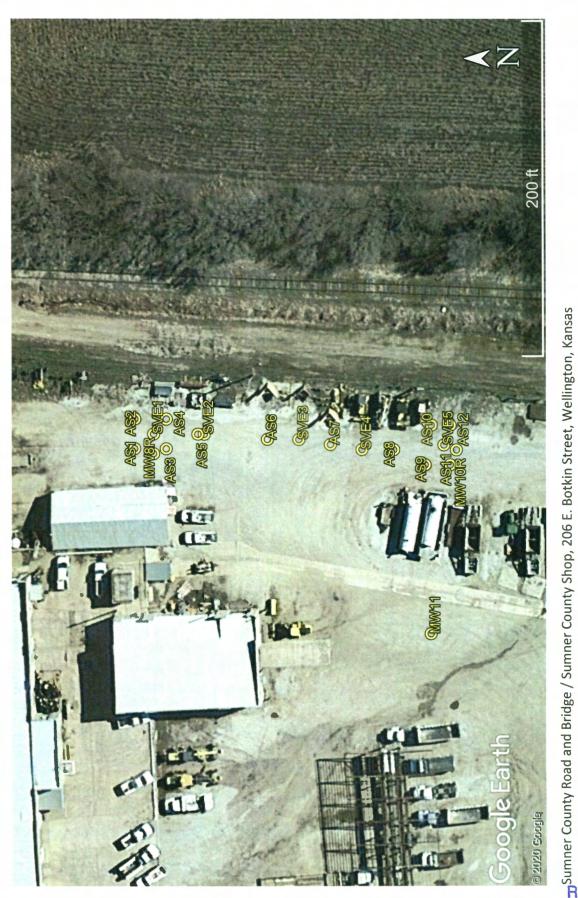

TKDHE Project Code: U2-096-00881 / A2-096-40065 О Surveyed)

37.25291, -97.39495 AS7: AS8: AS9: 37.25297, -97.39492 37.25297, -97.39486 37.25292, -97.39492 37.25292, -97.39486

37.25276, -97.39490 37.25256, -97.39492 37.25266, -97.39491

SVE3: 37.25271, -97.39490 SVE2: 37.25286, -97.39489 37.25251, -97.39495 AS11: 37.25247, -97.39495 AS10: 37.25250, -97.39487

37.25261, -97.39492 37.25248, -97.39491 SVE4: SVE5:

37.25294, -97.39489

37.25250, -97.39487

AS10:

37.25287, -97.39489

AS4: AS3:

AS5:

37.25247, -97.39487

AS12: SVE1:

APR 2 7 2021

AAS1: QAS2: