
		RECORD Correction		WWC-5			vision of Wat ources App. 1			Well ID	MW11	
		ATER WEL		Fraction			ction Number		hip Numb		ge Number	
County: Sumner				NE 1/4 NE 1/4	NE 1/4						E ■ W	
2 WELL OWNER: Last Name: Business: Sumner County Road & Bridge / Shop Address: Address: Address: Address: Address: Address: Sumner County Road & Bridge / Shop Address: Address: Sumner County Road & Bridge / Shop Address: Address: Sumner County Road & Bridge / Shop Address: Address: Sumner County Road & Bridge / Shop Address: Address: Sumner County Road & Bridge / Shop												
City: 3 LOCAT	Wellingto	<u> </u>	State: KS	ZIP: 67152								
WITH "				IPLETED W			5 Latit	ude:	37.2525	50	(decimal degrees)	
l	N BOX:			Encountered: 1)								
1	1	2)	II.	3) ft., TER LEVEL:	or 4) L 5.1	J Dry Well					83 □ NAD 27	
		D below I	and surface.	, measured on (r	no-dav-	vr) 12/14/20	. Source	e for Latitude	/Longitude	: Spectra P	recision Epo	
NW	NE	above l	above land surface, measured on (mo-day-yr)					WAAS e	nabled?	Yes N	lo)	
Pump test data: We								☐ Land Survey ☐ Topographic Map				
				pumping gpm				☐ Online Mapper:				
Well w				ater was ft. pumping gpm								
	Estimated Yield:				gpm 6 Elevat				tion: 1184.54 ft. Ground Level TOC			
	S Bore Hole Diameter:				8 in. to 20 ft. and				Source: Land Survey GPS Topographic Map			
····	nile			in. to								
7 WELL WATER TO BE USED AS:												
1. Domestic				iter Supply: wel								
☐ Household 6. ☐ Dewaterin ☐ Lawn & Garden 7. ☐ Aquifer R								11. Test Hole: well ID				
	☐ Lawn & Garden 7. ☐ Aquifer Rec 8. ■ Monitoring:				MW.	V11	12. Geot					
: —	2. Irrigation 9. Environmental Remediation: well ID.							12. Geothermal: how many bores? a) Closed Loop ☐ Horizontal ☐ Vertical				
3. Feedlot Air Sparge Soil												
4. 🔲 Indust	rial] Recovery	☐ Injec	tion		13. 🔲 O	ther (specify)				
Was a chemical/bacteriological sample submitted to KDHE? ☐ Yes ■ No If yes, date sample was submitted:												
Water well disinfected? ☐ Yes ■ No												
8 TYPE OF CASING USED: ☐ Steel ■ PVC ☐ Other												
Casing diameter2 in. to5 ft., Diameter in. to ft., Diameter in. to ft. Casing height above land surface												
TYPE OF SCREEN OR PERFORATION MATERIAL:												
Steel ☐ Stainless Steel ☐ Fiberglass ■ PVC ☐ Other (Specify)												
☐ Brass ☐ Galvanized Steel ☐ Concrete tile ☐ None used (open hole)												
SCREEN OR PERFORATION OPENINGS ARE:												
☐ Continuous Slot ☐ Mill Slot ☐ Gauze Wrapped ☐ Torch Cut ☐ Drilled Holes ☐ Other (Specify)												
□ Louvered Shutter □ Key Punched □ Wire Wrapped □ Saw Cut □ None (Open Hole)												
SCREEN-PERFORATED INTERVALS: From .5												
9 GROUT MATERIAL: Neat cement Cement grout Bentonite Other Concrete												
Grout Interv	als: From	0 ft. to	1	ft., From1		ft. to4	ft., From	i 1	t. to	ft.		
Grout Intervals: From												
☐ Septic			Lateral Line				Livestock P			cide Storage		
☐ Sewer			Cess Pool	∐ Sev	vage La		Fuel Storage		_	oned Water		
Other	(Specify) R	ines 🔲 :	scepage Pit	☐ Fee	иуага	<u>L</u>	Fertilizer St	orage	□ On we	eli/Gas Well		
Direction from well?												
10 FROM	TO	1	LITHOLOG	GIC LOG		FROM	TO				G INTERVALS	
0	9	Clay, silty, D		Gray		<u> </u>						
9	14	Clay, v. silty		<u> </u>								
14	16			ock frags.), DI								
16	18.5			(rock frags), E			ļ			<u>.</u>		
18.5	20	Clay, silty, g	ravelly (ro	ock frags.), Ye	el Tan	 						
	 					Notes:	L					
140tcs.												
11 CONTRACTOR'S OR LANDOWNER'S CERTIFICATION: This water well was constructed, reconstructed, or plugged under my jurisdiction and was completed on (mo-day-year) .10/22/2020 and this record is true to the best of my knowledge and belief.												
under my i	urisdiction :	and was comp	leted on (n	no-day-year) ´	10/22/2	2020 and	this record	is true to the	best of m	ıv knowled	ge and belief.	
Kansas Wa	ater Well Co	ntractor's Lic	ense No. 🌣	921 T	his Wa	iter Well Re	cord was co	mpleted on (mo- <i>d</i> ay-y	ear) .JULA	112024	
under the b	Jusiness nan	long with a fee of	15.00 for ear	ch constructed wel	to Kar	S Isas Denartmer	Ignature k	Environment	Bureau of W	Vater, GWTS	Section.	
Mail 1 white copy along with a fee of \$5.00 for each constructed well to: Kansas Department of Health and Environment, Bureau of Water, GWTS Section, 1000 SW Jackson St., Suite 420, Topeka, Kansas 66612-1367. Mail one to Water Well Owner and retain one for your records. Telephone 785-296-5524.												
Visit us at http://www.kdheks.gov/waterwell/index.html KSA 82a-1212 Revised 7/10/2015												

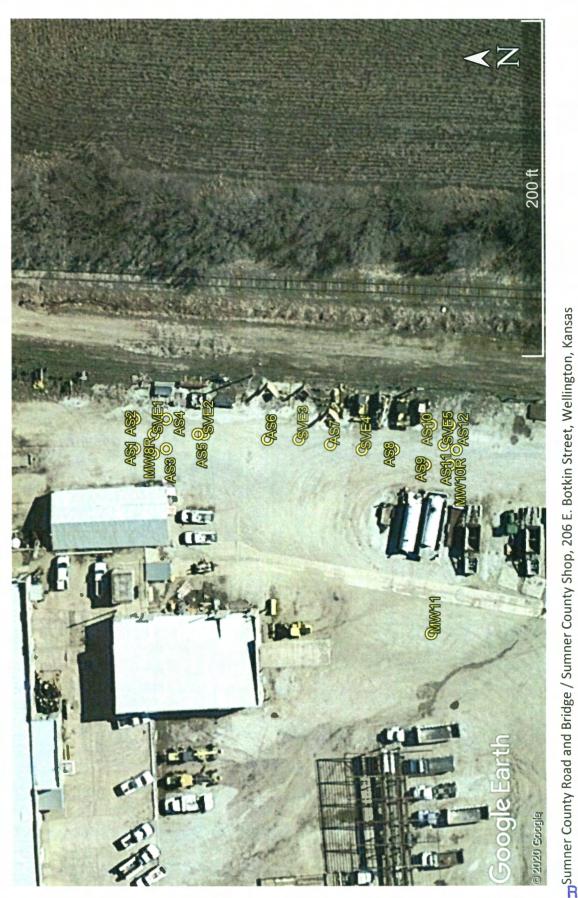

TKDHE Project Code: U2-096-00881 / A2-096-40065 О Surveyed)

37.25291, -97.39495 AS7: AS8: AS9: 37.25297, -97.39492 37.25297, -97.39486 37.25292, -97.39492 37.25292, -97.39486

37.25276, -97.39490 37.25256, -97.39492 37.25266, -97.39491

SVE3: 37.25271, -97.39490 SVE2: 37.25286, -97.39489 37.25251, -97.39495 AS11: 37.25247, -97.39495 AS10: 37.25250, -97.39487

37.25261, -97.39492 37.25248, -97.39491 SVE4: SVE5:

37.25294, -97.39489

37.25250, -97.39487

AS10:

37.25287, -97.39489

AS4: AS3:

AS5:

37.25247, -97.39487

AS12: SVE1:

APR 2 7 2021

AAS1: QAS2: