
	R WELL F			WWC-5		Division of Water				AS2		
				e in Well Use			ces App. No.		Well ID			
1 LOCATION OF WATER WELL:			L:	Fraction		Section	on Number	Township Numb		ge Number		
Count	y: Comancl	ne		SE 1/4 NW 1/4 SE						D □ E ■ W		
2 WELL OWNER: Last Name: Loucks First: Orlin/Dora Street or Rural Address where well is located (if unknown, dista												
Business	:				direction from nearest town or intersection): If at owner's address, check here:							
	Address: 2932 Quivira Ave.						200 N. Broadway, Protection					
Address:			140		200 N. B	roady	way, Protec	CION				
City:	Great Be	nd	State: KS	ZIP: 67530								
3 LOCAT		4 DEPTH	OF COM	PLETED WELL:	37.2021164 (decimal degrees)							
WITH "		Denth(s) Gre	oundwater F	Encountered: 1)	23 ft		Longitude: -99.4837584 (decimal degrees)					
	ON BOX:) ft., or 4)		.		al Datum: WGS 84				
1	N			TER LEVEL:		١ ١		or Latitude/Longitude		65 L NAD 21		
				measured on (mo-day				(unit make/model:)		
NUV	NE			measured on (mo-day				(WAAS enabled?				
X	NE		Pump test data: Well water was				Land Survey Topographic Map					
w -	E		after hours pumping			om Online Mapper:						
" '	'		Well water was f									
SW	SE	after hours pumping			gpm	19/9/58						
		Estimated Y	Estimated Yield:gpm				6 Elevation: 1848.58 ft. Ground Level T					
	S	Bore Hole D	Bore Hole Diameter:8 in. to34			ft. and Source: Land Survey						
1	mile		in. to									
7 WELL WATER TO BE USED AS:												
1. Domestic				ter Supply: well ID			10. 🔲 Oil Fi	ield Water Supply: le	ase			
☐ House	ho1d	g: how many wells?			11. Test Hole: well ID							
☐ Lawn					echarge: well ID			☐ Cased ☐ Uncased ☐ Geotechnical				
☐ Livest	ock	g: well ID										
2. 🔲 Irrigat	. Irrigation 9. Environmental Remediation: well II						a) Close	d Loop 🔲 Horizont	al 🗌 Verti	cal		
3. Teedlo	3. ☐ Feedlot ☐ Air Sparge ☐ Soil Vapor:											
4. Indust	rial		Recovery	☐ Injection			13. 🔲 Other	(specify):				
Was a chemical/bacteriological sample submitted to KDHE? Yes No If yes, date sample was submitted:												
Water well disinfected? Yes No												
8 TYPE OF CASING USED: ☐ Steel ■ PVC ☐ Other												
Casing diameter												
Casing height above land surface -0.64 in Weight lbs./ft. Wall thickness or gauge No. Sch. 40.												
TYPE OF SCREEN OR PERFORATION MATERIAL:												
Steel Stainless Steel Fiberglass ■ PVC Other (Specify)												
SCREEN OR PERFORATION OPENINGS ARE:												
Continuous Slot Mill Slot Gauze Wrapped Torch Cut Drilled Holes Other (Specify)												
□ Louvered Shutter □ Key Punched □ Wire Wrapped □ Saw Cut □ None (Open Hole)												
SCREEN-PERFORATED INTERVALS: From .32												
GRAVEL PACK INTERVALS: From6.5 ft. to34 ft., From ft. to ft., From ft. to ft.												
9 GROUT MATERIAL: Neat cement Cement grout Bentonite Other												
Grout Intervals: From												
Nearest source of possible contamination:												
Septic		_	ateral Lines				vestock Pens	_	cide Storage	177 11		
Sewer		_	Cess Pool	☐ Sewage L			el Storage		oned Water	Well		
□ Watertight Sewer Lines □ Seepage Pit □ Feedyard □ Fertilizer Storage □ Oil Well/Gas Well ■ Other (Specify) Contaminated site □ Oil Well/Gas Well												
Direction from well? Distance from well? ft.												
10 FROM	TO TO		ITHOLOG		FROM			THO. LOG (cont.) or		GINTEDWALE		
				IIC LUG	rkum	-	10 L1	THO. LOG (cont.) of	LUGGIN	2 HATEKAWES		
0		Clay, silty, Br			-	-						
5		Sand, vf-c (fi										
23		Sand, vf-c, cl										
26		Clay, sl. silty,										
31		<u>Sand, vf-m, s</u>										
32	34	Clay, sl. silty	Dark Bro	ı1WC								
					Notes:							
11 CONTRACTOR'S OR LANDOWNER'S CERTIFICATION: This water well was constructed, reconstructed, or plugged												
under my jurisdiction and was completed on (mo-day-year) .8/7/2018 and this record is true to the best of my knowledge and belief.												
Kansas Wa	iter Well Co	ntractor's Lice	nse No. 5	27 This W	ater Well I	Record	d was compl	eted on (mo-day-ve	ear) .1.1/1/2	201.8		
under the b	usiness nam	e of GeoCor	e Inc			.Signa	ature	su Mill				
Mail	I white copy al	ong with a fee of S	\$5.00 for each	h constructed well to: Ka	ensas Departm	ent of	Health and Env	vironment, Bureau of W	ater, GWTS S	Section,		
1000 SW Jackson St., Suite 420, Topeka, Kansas 66612-1367. Mail one to Water Well Owner and retain one for your records. Telephone 785-296-5524.												
Visit us at http://www.kdheks.gov/waterwell/index.html KSA 82a-1212 Revised 7/10/2015										7/10/2015		

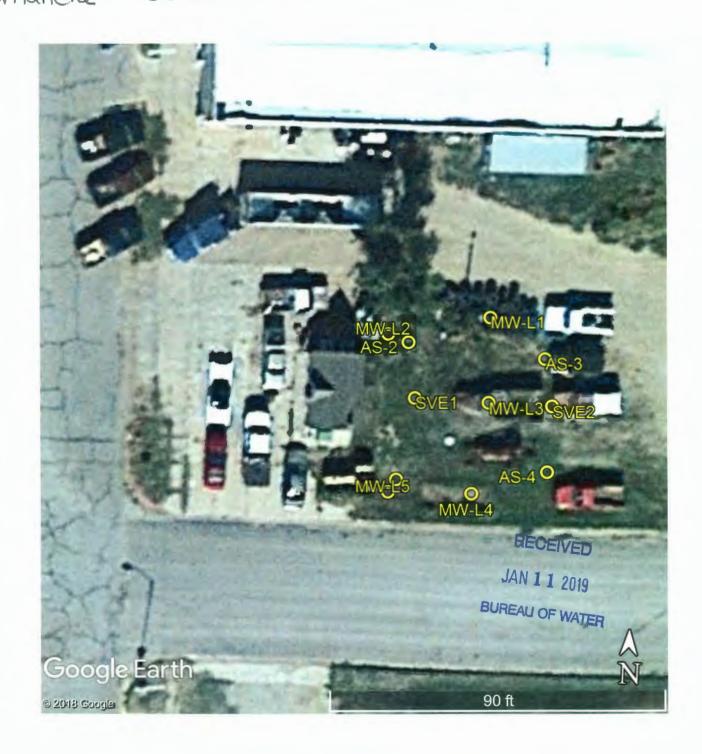

Louck's Service, 200 N. Broadway, Protection (N. Broadway & Pine St.) KDHE Project Code U1 017 00440

GPS Coordinates:

AS1: 37.2020166, -99.4837645 MW-L1: 37.2021285, -99.4836921 AS2: 37.2021164, -99.4837584 MW-L2: 37.2021134, -99.4837839 AS3: 37.2021085, -99-4836335 MW-L3: 37.2020668, -99.4836903 AS4: 37.2020182, -99.4836338 MW-L4: 37.2020001, -99.4837018 SVE1: MW-L5: 37.2019988, -99.4837780 37.2020680, -99.4837573 SVE2: 37.2020663, -99.4836321