
	WELL F		WWC-5		ision of Water		MW-L4		
			ge in Well Use		urces App. No.	- 11 hr 1	Well ID		
1 LOCATION OF WATER WELL:			Fraction						
County: Comanche SE¼NW¼ SE¼NW¼ 3 T 33 S R 20 □ E									
2 WELL OWNER: Last Name: Loucks First: Orlin/Dora Street or Rural Address where well is located (if unknown, distance and									
Business				direction from nearest town or intersection): If at owner's address, check here:					
Address: 2932 Quivira Ave. 200 N. Broadway, Protection									
City: Great Bend State: KS ZIP: 67530									
3 LOCAT				00		27 20400	004		
4 DEPTH OF COMPLETED WELL: 47 π. 5 1						37.20100	01 (decimal degrees)		
	Depth(s) Groundwater Encountered: 1)					Longitude: -99.4837018 (decimal degrees)			
	V	2) ft.	3) ft., or 4) [Dry Well	Horizontal Datum: ☐ WGS 84 ■ NAD 83 ☐ NAD 27				
		WELL'S STATIC WA	WELL'S STATIC WATER LEVEL:20.19 ft. below land surface, measured on (mo-day-yr). 9/18/2018			Source for Latitude/Longitude:			
'	'	above land surface, measured on (mo-day-yr)			GPS (unit make/model:)				
			vater was f		(WAAS enabled? Yes No)				
1 1 1					■ Land Survey ☐ Topographic Map ☐ Online Mapper:				
W	Е	1	hours pumping gpm Well water was ft.			☐ Offinite Mapper.			
SW	SE	1	after hours pumping gpm			4040.04			
		Estimated Vield:		6 Elevation: 1849.24ft. ☐ Ground Level ■ TOC					
	S	Bore Hole Diameter:	8 in. to29	ft. and	Source: Land Survey GPS Topographic Map				
1 1	mile		in. to						
7 WELL WATER TO BE USED AS:									
1. Domestic			ater Supply: well ID			* * *	ease		
☐ Lawn & Garden 7. ☐ Aquifer Re			echarge: well ID	ge: well ID Cased Uncased Geotechnical			Geotechnical		
Livest			g: well IDMV		12. Geothermal: how many bores?				
	. 🗌 Irrigation 9. Environmental Remediation: well ID					a) Closed Loop Horizontal Vertical			
3. Feedlo		☐ Air Sparge		Extraction	b) Open Loop Surface Discharge Inj. of Water 13. Other (specify):				
4. 🗌 Indust		Recovery							
Was a chemical/bacteriological sample submitted to KDHE? ☐ Yes ■ No If yes, date sample was submitted:									
Water well disinfected? ☐ Yes ■ No									
8 TYPE OF CASING USED: ☐ Steel ■ PVC ☐ Other									
Casing diameter 2 in. to 14 ft., Diameter in. to ft., Diameter in. to ft. Casing height above land surface0.22 in. Weight lbs./ft. Wall thickness or gauge No. Sch. 40									
TYPE OF SCREEN OR PERFORATION MATERIAL:									
☐ Steel ☐ Stainless Steel ☐ Fiberglass ■ PVC ☐ Other (Specify)									
☐ Brass ☐ Galvanized Steel ☐ Concrete tile ☐ None used (open hole)									
SCREEN OR PERFORATION OPENINGS ARE:									
☐ Continuous Slot									
☐ Louvered Shutter ☐ Key Punched ☐ Wire Wrapped ☐ Saw Cut ☐ None (Open Hole) SCREEN-PERFORATED INTERVALS: From14									
GRAVEL PACK INTERVALS: From									
UKAVEL PACK INTERVALS: From									
9 GROUT MATERIAL: Neat cement Cement grout Bentonite Other Concrete									
Grout Intervals: From									
Nearest source of possible contamination: ☐ Septic Tank ☐ Lateral Lines ☐ Pit Privy ☐ Livestock Pens ☐ Insecticide Storage									
☐ Septic Tank ☐ Lateral Lines ☐ Pit Privy ☐ Livestock Pens ☐ Insecticide Storage ☐ Sewer Lines ☐ Cess Pool ☐ Sewage Lagoon ☐ Fuel Storage ☐ Abandoned Water Well									
□ Watertight Sewer Lines □ Seepage Pit □ Feedyard □ Fertilizer Storage □ Oil Well/Gas Well									
Other (Specify) .Contaminated site									
Direction from well? ft.									
10 FROM	ТО	LITHOLO		FROM			PLUGGING INTERVALS		
0	12	Silt, sl. clayey stringer	rs, Lt. Brown						
12		Clay, v. silty, Lt. Gray							
18		Clay, Dark Gray Brow							
25		Clay, sl. silty, Dark Br				1,2			
				1					
				Notes:					
11 CONTRACTOR'S OR LANDOWNER'S CERTIFICATION: This water well was constructed, reconstructed, or plugged									
under my jurisdiction and was completed on (mo-day-year) .8/8/2018 and this record is true to the best of my knowledge and belief.									
Kansas Water Well Contractor's License No. 52/ This Water Well Record was completed on (mo-day-year) 17.07/2018									
under the b	usiness nam	e of Geo/Core Inc		Sis	nature	The Wall			
Mail, I, white copy along with a fee of \$5.00 for each constructed, well to: Kanas Department of Health and Environment, Burealu of Water, GWTS Section,									
1000 SW Jackson St., Suite 420, Topeka, Kansas 66612-1367. Mail one to Water Well Owner and retain one for your records. Telephone 785-296-5524.									
Visit us at htt	p://www.kdhek	s.gov/waterwell/index.html		KSA 82a-12	12		Revised 7/10/2015		

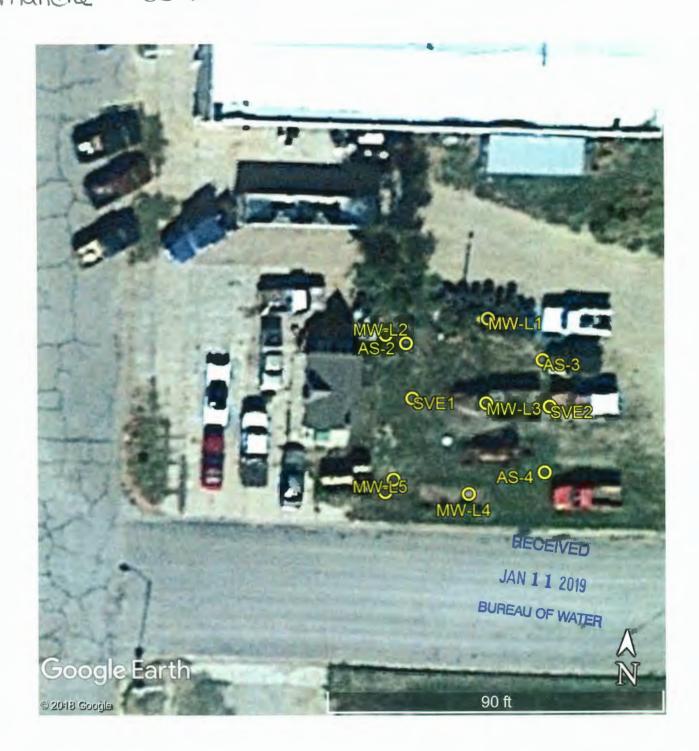

Louck's Service, 200 N. Broadway, Protection (N. Broadway & Pine St.) KDHE Project Code U1 017 00440

GPS Coordinates:

37.2020166, -99.4837645 MW-L1: 37.2021285, -99.4836921 AS1: AS2: 37.2021164, -99.4837584 MW-L2: 37.2021134, -99.4837839 MW-L3: 37.2020668, -99.4836903 AS3: 37.2021085, -99-4836335 MW-L4: 37.2020001, -99.4837018 37.2020182, -99.4836338 AS4: SVE1: 37.2020680, -99.4837573 MW-L5: 37.2019988, -99.4837780 SVE2: 37.2020663, -99.4836321