
		RECORD		WWC-5	Div	vision of Wate	r		AS2	
		Correction		ge in Well Use		ources App. N		Well ID		
1 LOCATION OF WATER WELL:			Fraction	Section Number Township N				ige Number		
County: Comanche				SE 1/4 NW 1/4 SE 1/4				0 □E ■ W		
2 WELL OWNER: Last Name: Mathews First: Sue Street or Rural Address where well is located (if unknown, distance)										
Business: The Filling Station Cafe direction from nearest town or intersection): If at owner's address, check here:										
Address: 109 N. Broadway Avenue										
City: Protection State: KS ZIP: 67127										
3 LOCAT					24 .		27 2016	06		
WITH "				IPLETED WELL:						
SECTIO				Encountered: 1)			Longitude: -99.484403 (decimal degrees) Horizontal Datum: WGS 84 □ NAD 83 □ NAD 27			
1	N .			TER LEVEL:			Source for Latitude/Longitude:			
				, measured on (mo-day-			GPS (unit make/model:)			
NW				, measured on (mo-day-	·yr)		(WAAS enabled?			
I I I I I I I I I I I I I I I I I I I				vater was f		☐ La	☐ Land Survey ☐ Topographic Map			
				s pumping						
sw	SE	000		vater was						
1 1 1	Estimated Vield			s pumping	gpm	6 Eleva	6 Elevation: 1858ft. 🔳 Ground Level 🔲 TOC			
	S Bore Hole Diameter:			8 in to 34	ft and		Source: Land Survey GPS Topographic Map			
1 r	nile			in. to	in. to			arth		
7 WELL WATER TO BE USED AS:										
1. Domestic:	:			ter Supply: well ID		10. 🔲 Oi	Field Water Supply: 1	ease		
House		6. [☐ Dewaterin	g: how many wells?	? 11. Test Hole: well ID .					
☐ Lawn d				echarge: well ID			☐ Cased ☐ Uncased ☐ Geotechnical			
								ermal: how many bores?		
	2. ☐ Irrigation 9. Environmental Remediation: 3. ☐ Feedlot ☐ Air Sparge ☐ Soil									
4. Industr			Recovery		extraction		pen Loop Surface Di			
Was a chemical/bacteriological sample submitted to KDHE? ☐ Yes ■ No If yes, date sample was submitted:										
Water well disinfected? No 8 TVPF OF CASING USED: Steel Proc Codes CASING IODITS: Cloud Codes										
8 TYPE OF CASING USED: ☐ Steel ☐ PVC ☐ Other										
Casing diameter										
TYPE OF SCREEN OR PERFORATION MATERIAL:										
☐ Steel ☐ Stainless Steel ☐ Fiberglass ■ PVC ☐ Other (Specify)										
☐ Brass ☐ Galvanized Steel ☐ Concrete tile ☐ None used (open hole)										
SCREEN OR PERFORATION OPENINGS ARE:										
☐ Continuous Slot ☐ Mill Slot ☐ Gauze Wrapped ☐ Torch Cut ☐ Drilled Holes ☐ Other (Specify)										
☐ Louvered Shutter ☐ Key Punched ☐ Wire Wrapped ☐ Saw Cut ☐ None (Open Hole)										
SCREEN-PERFORATED INTERVALS: From31.5. ft. to34. ft., From ft. to ft., From ft. to ft.										
GRAVEL PACK INTERVALS: From 6.5 ft. to 34 ft., From ft. to ft., From ft. to ft.										
9 GROUT MATERIAL: ☐ Neat cement ☐ Cement grout ☐ Bentonite ☐ Other Grout Intervals: From 3 ft. to 6.5 ft., From ft. to ft.										
Orout intervals: From										
Nearest source of possible contamination: Septic Tank										
Sewer		_	Cess Pool	☐ Sewage La		Fuel Storage		oned Water		
□ Watertight Sewer Lines □ Seepage Pit □ Feedyard □ Fertilizer Storage □ Oil Well/Gas Well										
☐ Other (Specify)										
Direction fro										
10 FROM	TO		<u> LITHOLOG</u>		FROM	TO	LITHO. LOG (cont.) or	PLUGGIN	G INTERVALS	
	4	Clay, silty, s	andy, Broy	wn	1					
4		Fill sand								
25	34	Clay, Dark E	Brown				water and a standard			
		· · · · · · · · · · · · · · · · · · ·								
-									····	
				1898 10 11	 					
	Notes: KDHE Project #U1-017-00296									
11 CONTRACTOR'S OR LANDOWNER'S CERTIFICATION: This water well was constructed, reconstructed, or plugged										
11 CONT	RACTOR'	S OR LAND	OWNER'S	S CERTIFICATION	N: This wate	r well was	∬ constructed, ☐ reco	onstructed,	or ∐ plugged	
under my jurisdiction and was completed on (mo-day-year) .12/17/2021 and this record is true to the best of my knowledge and belief. Kansas Water Well Contractor's License No. 527 This Water Well Record was completed on (mg-day/year) .12/21/2021										
under the h	usiness nan	ne of GeoCo	re. LLC	Inis wa	Si	gnature /	Jall Willy			
Mail	1 white copy a	long with a fee of	f \$5.00 for eac	ch constructed well to: Kar	sas Departmen	of Health and	Environment, Bureau of W	ater, GWTS	Section,	
1000 SW Jackson St., Suite 420, Topeka, Kansas 66612-1367. Mail one to Water Well Owner and retain one for your records. Telephone 785-296-5524.										
		cs gov/waterwell/			KSA 82a-12		· · · · · · · · · · · · · · · · · · ·		7/10/2015	

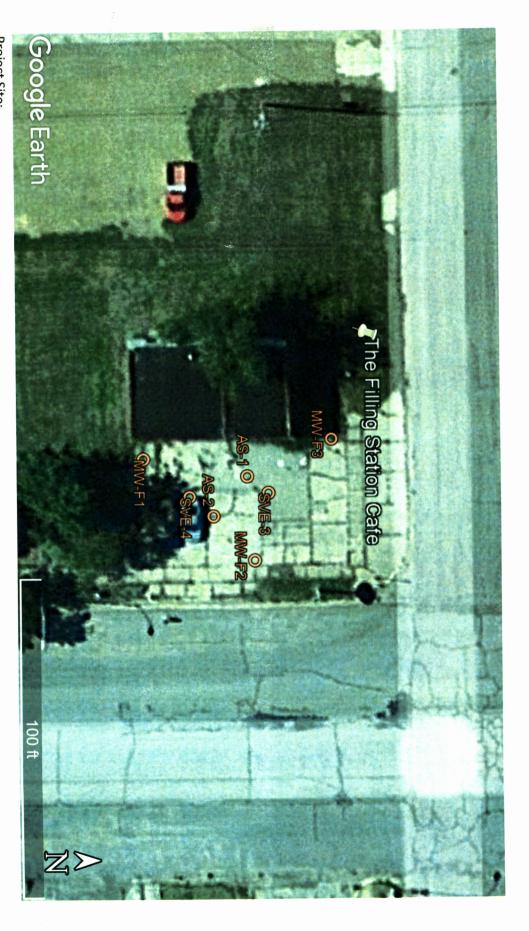

Project Site:

The Filling Station Café, 109 N. Broadway, Protection KDHE Project Code: U1-017-00296

GPS Coordinates:

AS-1: AS-2: MW-F2: MW-F1: 37.201725, -99.484446 37.201696, -99.484403 37.201637, -99.484465 37.201731, -99.484355 MW-F3: SVE-3: SVE-4:

MW-F3: 37.201797, -99.484486 SVE-3: 37.201743, -99.484428 SVE-4: 37.201676, -99.484424