
	WELL			WWC-5		vision of Water			MW-F1		
				ge in Well Use		ources App. No		Well ID	- N		
1 LOCATION OF WATER WELL: County: Comanche			Fraction	1 -	ction Number 3	Township Numb		ge Number D□E■W			
2 WELL OWNER: Last Name: Matthews Business: The Filling Station Cafe Address: 109 N. Broadway Avenue Address: Business: 109 N. Broadway Avenue											
City:	Protection	n s	tate: KS	ZIP: 67127							
1	3 LOCATE WELL 4 DEPTH OF COMPLETED WELL:						30ft. 5 Latitude: 37.201637 (decimal degrees)				
WITH "	X" IN ON BOX:			Encountered: 1)					(decimal degrees)		
	N BOX.			3) ft., or 4)			ntal Datum: WGS 8				
			WELL'S STATIC WATER LEVEL: ft. □ below land surface, measured on (mo-day-yr)				for Latitude/Longitude				
NUV	NE		above land surface, measured on (mo-day-yr)				'S (unit make/model:				
\\X	NE		Pump test data: Well water was ft.				WAAS enabled? ☐ ITopogr ☐ Topogr		.6)		
w	Е	after	after hours pumping gpm			On	line Mapper: Google	Earth			
sw	SE		Well water was ft. after hours pumping gpm								
	i	Estimated Vie	Estimated Yield:gnm			6 Elevation: 1859ft. ■ Ground Level □ TOC					
	S	Bore Hole Di	Bore Hole Diameter: 8 in. to 30			and Source: Land Survey GPS Topographic Map			pographic Map		
1 r				in. to			Other Google Ea	arth			
7 WELL WATER TO BE USED AS:											
1. Domestic				ter Supply: well ID			10. Oil Field Water Supply: lease				
· —	☐ Household 6. ☐ Dewatering: how many wells? ☐ Lawn & Garden 7. ☐ Aguifer Recharge: well ID					11. Test Hole: well ID					
	☐ Lawn & Garden ☐ Livestock 7. ☐ Aquifer Recharge: well ID					12. Geothe	12. Geothermal: how many bores?				
	☐ Irrigation 9. Environmental Remediation: well ID					a) Closed Loop					
_	3. Feedlot Air Sparge Soil Vapor E					b) Open Loop Surface Discharge Inj. of Water					
4. Industr			Recovery				er (specify):				
Was a chemical/bacteriological sample submitted to KDHE? ☐ Yes ■ No If yes, date sample was submitted:											
Water well disinfected? No											
8 TYPE OF CASING USED: ☐ Steel ☐ PVC ☐ Other											
Casing height above land surface											
TYPE OF SCREEN OR PERFORATION MATERIAL:											
☐ Steel ☐ Stainless Steel ☐ Fiberglass ■ PVC ☐ Other (Specify)											
☐ Brass ☐ Galvanized Steel ☐ Concrete tile ☐ None used (open hole)											
SCREEN OR PERFORATION OPENINGS ARE: ☐ Continuous Slot											
☐ Continuous Slot ☐ Mill Slot ☐ Gauze Wrapped ☐ Torch Cut ☐ Drilled Holes ☐ Other (Specify)											
SCREEN-PERFORATED INTERVALS: From15 ft. to30 ft., From ft., From ft., From ft. to ft.											
GRAVEL PACK INTERVALS: From 13 ft. to 30 ft., From ft. to ft., From ft. to ft., From ft. to ft.											
9 GROUT MATERIAL: Next cement Cement grout Rentonite Other											
Grout Intervals: From											
Nearest sou	rce of possib	le contamination	n:								
☐ Septic Tank ☐ Lateral Lines ☐ Pit Privy ☐ Livestock Pens ☐ Insecticide Storage ☐ Sewer Lines ☐ Cess Pool ☐ Sewage Lagoon ☐ Fuel Storage ☐ Abandoned Water Well											
☐ Watertight Sewer Lines ☐ Seepage Pit ☐ Feedyard ☐ Fertilizer Storage ☐ Oil Well/Gas Well											
☐ Other (Specify) Direction from well?											
10 FROM	TO T			Distance from to GIC LOG	FROM				CINTERVALO		
		Concrete	THOLUC	JIC LUG	LKOM	10 1	LITHO. LOG (cont.) or	TLUGGING	JINIEKVALS		
0.5		Clay, silty, v. s	andv. B	rown							
5		Clay, silty, Dar					·				
10		lay, v. silty, Brown									
		lay, silty, sandy (vf), Black									
20	30 Clay, silty, Dark Brown										
Notes: KDHE Project #U1-017-00296											
11 CONTRACTOR'S OR LANDOWNER'S CERTIFICATION: This water well was constructed, reconstructed, or plugged											
under my jurisdiction and was completed on (mo-day-year) .12/1.7/2021 and this record is true to the best of my knowledge and belief.											
Kansas Wa	iter Well Co	ntractor's Licen	ise No. 5	27 This W	ater Well Re	cord was com	pleted on (monday-y	ear) .12/2.1.	/2021		
under the b	usiness nam	ie of GeoCore	LLC		Si	gnature	fall Hald				
Mail 1 white copy along with a fee of \$5.00 for each constructed well to: Kansas Department of Health and Environment, Bureau of Water, GWTS Section, 1000 SW Jackson St., Suite 420, Topeka, Kansas 66612-1367. Mail one to Water Well Owner and retain one for your records. Telephone 785-296-5524.											
Visit us at http://www.kdheks.gov/waterwell/index.html KSA 82a-1212 Revised 7/10/2015											

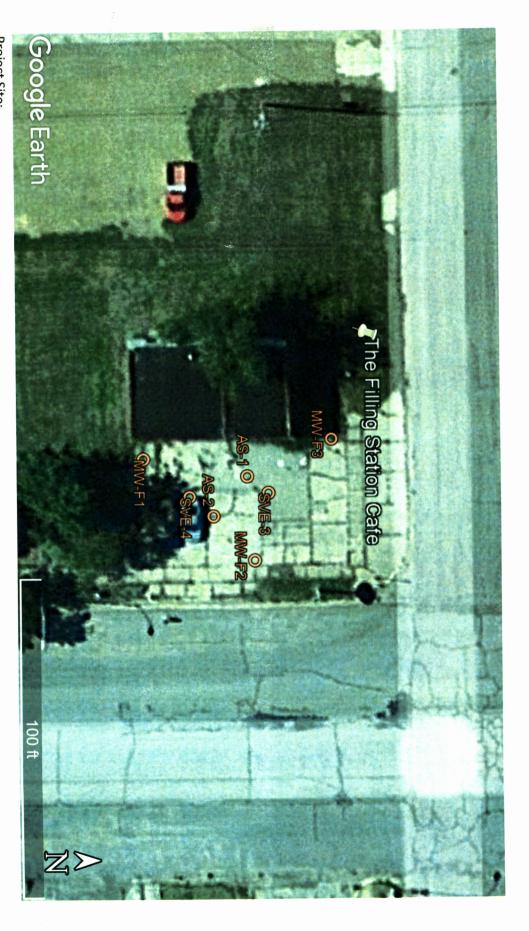

Project Site:

The Filling Station Café, 109 N. Broadway, Protection KDHE Project Code: U1-017-00296

GPS Coordinates:

AS-1: AS-2: MW-F2: MW-F1: 37.201725, -99.484446 37.201696, -99.484403 37.201637, -99.484465 37.201731, -99.484355 MW-F3: SVE-3: SVE-4:

MW-F3: 37.201797, -99.484486 SVE-3: 37.201743, -99.484428 SVE-4: 37.201676, -99.484424