
		RECORD			Div	vision of Wate	er	MW-	·F2	
Original Record Correction Chan			e in Well Use		ources App. N		Well ID			
1 LOCATION OF WATER WELL: County: Comanche			Fraction		ction Numbe					
			SE 1/4 NW 1/4 SE 1/							
2 WELL OWNER: Last Name: Mathews Business: The Filling Station Cafe Address: 109 N. Broadway Avenue Address: Address:										
	<b>Protection</b>	1	State: KS	ZIP: 67127						
	3 LOCATE WELL 4 DEPTH OF COMPLETED WE									
SECTION	'			Encountered: 1)		Long	Longitude: -99.484355 (decimal degrees)			
N 2) ft. 3 WELL'S STATIC WA'					ft.	Source	Horizontal Datum: ■ WGS 84 □ NAD 83 □ NAD 27 Source for Latitude/Longitude:			
'				measured on (mo-day			PS (unit make/model:		)	
				above land surface, measured on (mo-day-) Pump test data: Well water was			(WAAS enabled? Tyes No)			
1 1 1 1				hours pumping gpm			☐ Land Survey ☐ Topographic Map  Online Mapper: Google Earth			
1 1 1 1	Well w				ft.				• • • • • • • • • • • • • • • • • • • •	
sw	SE	after		pumping	ng gpm					
	Estimated Vield			gnm 6 Elevati			tion:!02/ft	ion: 1857ft. Ground Level TOC		
1				8 in. to 30		Source	Source: Land Survey GPS Topographic Map			
	1 mile  in. to									
7 WELL WATER TO BE USED AS:										
1. Domestic:	.1.1			ter Supply: well ID			il Field Water Supply: 1			
<u> </u>	☐ Household 6. ☐ Dewatering: how many ☐ Lawn & Garden 7. ☐ Aguifer Recharge: wel						Hole: well ID			
_	□ Lawn & Garden       7. □ Aquifer Recharge: well         □ Livestock       8. ■ Monitoring: well ID					W-F2 13 Creek and by Language Language 13 Creek and by Language Language 13 Creek and by Language 14 Creek and by Language 15 Creek and by Languag				
_	2. ☐ Irrigation  8. ☐ Mointoring: Well ID					12. Geothermal: how m <b>a</b> ny bores?				
3. Feedlot	1 <u> </u>					b) Open Loop  Surface Discharge Inj. of Water				
4. ☐ Industrial ☐ Recovery						13. Other (specify):				
Was a chemical/bacteriological sample submitted to KDHE? ☐ Yes ■ No If yes, date sample was submitted:										
Water well disinfected?  Yes No										
8 TYPE OF CASING USED: ☐ Steel ■ PVC ☐ Other										
Casing diameter 2 in. to 15 ft. Diameter in. to ft. Diameter in to ft.										
Casing diameter										
TYPE OF SCREEN OR PERFORATION MATERIAL:										
☐ Steel ☐ Stainless Steel ☐ Fiberglass ■ PVC ☐ Other (Specify)										
☐ Brass ☐ Galvanized Steel ☐ Concrete tile ☐ None used (open hole)										
SCREEN OR PERFORATION OPENINGS ARE:										
☐ Continuous Slot ☐ Mill Slot ☐ Gauze Wrapped ☐ Torch Cut ☐ Drilled Holes ☐ Other (Specify)										
☐ Louvered Shutter ☐ Key Punched ☐ Wire Wrapped ☐ Saw Cut ☐ None (Open Hole)										
SCREEN-PERFORATED INTERVALS: From										
GRAVEL PACK INTERVALS: From										
9 GROUT MATERIAL: Neat cement Cement grout Bentonite Other										
Grout Intervals: From										
Septic Tank										
☐ Sewer L		_	Cess Pool	☐ Sewage La		Fuel Storage		oned Water Well		
	tht Sewer Li	nes 🔲 :	Seepage Pit	☐ Feedyard		Fertilizer Sto		ll/Gas Well		
☐ Other (Specify)										
Direction from										
10 FROM	TO		ITHOLOG		FROM	TO	LITHO. LOG (cont.) or	PLUGGING INTERV	/ALS	
		Clay, silty, sa								
		Clay, v. silty,								
23 3	30 (	Clay, silty, h	ard, Dark	Gray						
<b>—</b>					<b></b>					
<u> </u>					1					
Notes: KD							HE Project #U1-017-00296			
11 CONTRACTORIS OR LANDOWNER OF CERTIFICATION TO THE CONTRACTORIS OF THE CONTRACTORIS										
11 CONTRACTOR'S OR LANDOWNER'S CERTIFICATION: This water well was constructed, reconstructed, or plugged under my jurisdiction and was completed on (mo-day-year) 12/17/2021 and this record is true to the best of my knowledge and belief.										
Kansas Wot	risuiction a er Well Co-	na was comp	ense No 5	io-day-year) .14/.1/./ 27 This W	AVA J and	inis record i	is true to the best of m mpleted on (mo∕day-y	y knowledge and be ear) 12/21/2021	ner.	
under the hu	isiness nam	e of GeoCo	re. LLC	+ I IIIS W	Si	onature	see No.	vai) .(WA:WAYA)	····	
Mail 1	white copy ale	ong with a fee of	\$5.00 for eac	h constructed well to: Ka	nsas Departmen	of Health and	Environment, Bureau of W	ater, GWTS Section,		
1000 SW Jackson St., Suite 420, Topeka, Kansas 66612-1367. Mail one to Water Well Owner and retain one for your records. Telephone 785-296-5524.										
		s.gov/waterwell/			KSA 82a-12		·	Revised 7/10/201	5	

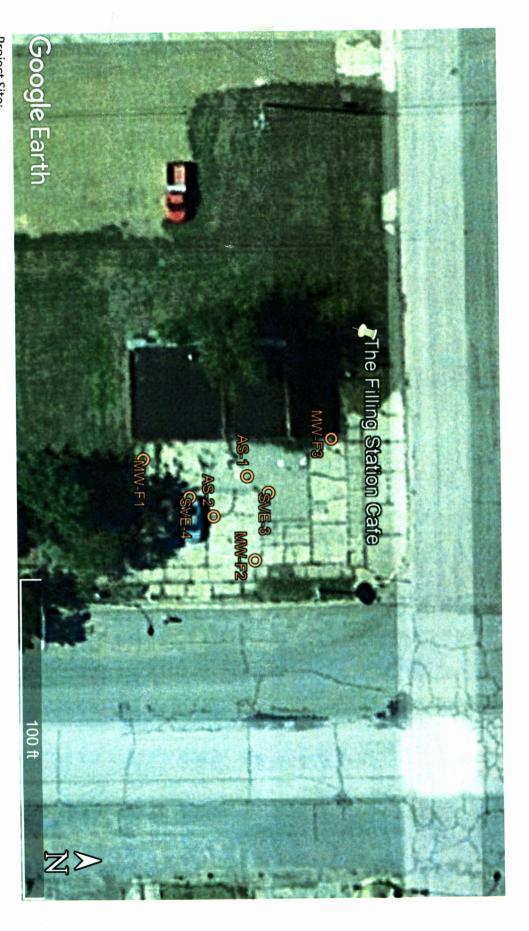

Project Site:

The Filling Station Café, 109 N. Broadway, Protection KDHE Project Code: U1-017-00296

## GPS Coordinates:

AS-1: AS-2: MW-F2: MW-F1: 37.201725, -99.484446 37.201696, -99.484403 37.201637, -99.484465 37.201731, -99.484355 MW-F3: SVE-3: SVE-4:

MW-F3: 37.201797, -99.484486 SVE-3: 37.201743, -99.484428 SVE-4: 37.201676, -99.484424