
WATE	R WELL:	RECORD	Form '	WWC-5		Division	of Water			MW-F3	
Origin	al Record	☐ Correction	☐ Chang	ge in Well Use	I	Resources	s App. No.		Well ID		
1 LOCATION OF WATER WELL:			Fraction	Section Number			Township Numb	er Ran	ge Number		
	County: Comanche			SE 1/4 NW 1/4 SE 1	E 1/4 NW 1/4 3			T 33 S		Ď □E ■ W	
2 WELL	OWNER:	Last Name: Ma	thews	First: Sue	Street or Rural Address where well is located (if unknown, distance and						
Business: The Filling Station Cafe						direction from nearest town or intersection): If at owner's address, check here:					
Address: 109 N. Broadway Avenue											
City:	Protectio	n	State: KS	ZIP: 67127							
3 LOCAT	E WELL										
WITH '				IPLETED WELL:		ft. 5	5 Latitude:37.201797(decimal degrees)				
SECTION	ON BOX:			Encountered: 1)				le:			
	N	WEI 1 2 C	TATIC WA	3) ft., or 4) Dry Well TER LEVEL: ft.				<u>l Datum:</u> WGS 84		33 □ NAD 27	
below land surface,				measured on (mo-day				r Latitude/Longitude			
w.	NWNE above land surface,						GPS (unit make/model:				
"X		ater was	ft.		☐ Land Survey ☐ Topographic Map						
w	E	s pumpinggpm			Online Mapper: Google Earth						
sw	SE	vater was									
		Estimated V	pumping gpm			6 Elevation: 1857ft. ■ Ground Level □ TOC					
	Estimated Yield: Bore Hole Diameter:			gpm 8in. to30 ft. and			Source: Land Survey GPS Topographic Map				
 1					in. to ft.			Other Google Earth			
7 WELL WATER TO BE USED AS:											
1. Domestic				ter Supply: well ID		10	0. □ Oil Fi	eld Water Supply: le	ase		
☐ House		6. □	g: how many wells?			10. Oil Field Water Supply: lease					
	& Garden	echarge: well IDg: well ID			☐ Cased ☐ Uncased ☐ Geotechnical						
1 =	Livestock 8. Monitoring				g: well ID MW-F3			nal: how many bores			
	2. La Irrigation 9. Environmental				l Remediation: well ID			Loop Horizont			
					Soil Vapor Extraction b) Open			Loop Surface Discharge Inj. of Water			
Was a chemical/bacteriological sample submitted to KDHE? ☐ Yes ■ No If yes, date sample was submitted:											
8 TVPE OF CASING LISED. CLEAN PROCESS.											
Casing diameter 2 in to 15 th Diameter											
8 TYPE OF CASING USED: Steel PVC Other CASING JOINTS: Glued Clamped Welded Threaded Casing diameter 2 in to 5 ft., Diameter in to ft., Diameter in to ft. Casing height above land surface 0 in. Weight lbs./ft. Wall thickness or gauge No. Sch. 40											
TYPE OF SCREEN OR PERFORATION MATERIAL:											
☐ Steel ☐ Stainless Steel ☐ Fiberglass ■ PVC ☐ Other (Specify)											
☐ Brass ☐ Galvanized Steel ☐ Concrete tile ☐ None used (open hole)											
SCREEN OR PERFORATION OPENINGS ARE:											
☐ Continuous Slot ☐ Mill Slot ☐ Gauze Wrapped ☐ Torch Cut ☐ Drilled Holes ☐ Other (Specify)											
Louvered Shutter Key Punched Wire Wrapped Saw Cut None (Open Hole)											
SCREEN-PERFORATED INTERVALS: From15											
GRAVEL PACK INTERVALS: From 13 ft. to 30 ft., From ft. to ft., From ft. to ft.											
9 GROUT MATERIAL: ☐ Neat cement ☐ Cement grout ■ Bentonite ☐ Other											
Nearest sou	rais. Floiii	ole contaminati	ion.	. π., From	II. to	n.,	, From	ft. to	ft.		
☐ Septic	Tank		Lateral Line:	s 🔲 Pit Privy		□ Livest	tock Pens	□ Incastic	ida Staraga		
□ Septic Tank □ Lateral Lines □ Pit Privy □ Livestock Pens □ Insecticide Storage □ Sewer Lines □ Cess Pool □ Sewage Lagoon □ Fuel Storage □ Abandoned Water Well									Vell		
	ight Sewer L		Seepage Pit	☐ Feedvard	_		izer Storage				
☐ Other (Specify)											
Direction fro	om well?			Distance from w							
10 FROM 0	TO		ITHOLOG		FROM	Te	O LIT	HO. LOG (cont.) or	PLUGGING	INTERVALS	
18		Clay, v. silty,									
24		Clay, v. silty,		Υ	- 						
24	30	Clay, hard, [Jark Gray			_					
						+					
		·			 			·			
					Madaa	KDITE 5	Ornin -t dil to	017 00000			
	Notes: KDHE Project #U1-017-00296										
11 CONTRACTOR'S OR LANDOWNER'S CERTIFICATION: This water well was constructed, reconstructed, or plugged											
under my jurisdiction and was completed on (mo-day-year) 12/17/2021 and this record is true to the best of my knowledge and belief.											
Kansas Wa	iter Well Co	ntractor's Lice	ense No. 🤉	۲(This Wa	ater Well F	Record w	vas comple	:t e d on (mo∙d en/? ve	ar) 12/21/	2021	
under the b	usiness nam	ie of GeQCQI	re, LLC			Signatui	re	ple lux			
Mail	I white copy al	long with a fee of	\$5.00 for <u>eacl</u>	constructed well to: Kai	nsas Departm	ent of Hea	alth and Envi	ronment, Bureau of Wa	ter, GWTS So	ection,	
		St., Suite 420, Top ts.gov/waterwell/i		66612-1367. Mail one to			retain one fo	r your records. Telepho		524. 7/10/2015	
v ioit us at fill	p.//www.kuijek	s.gov/waterwell/l	ngex.ntmi		KSA 82a-	1414			revised	//10/2013	

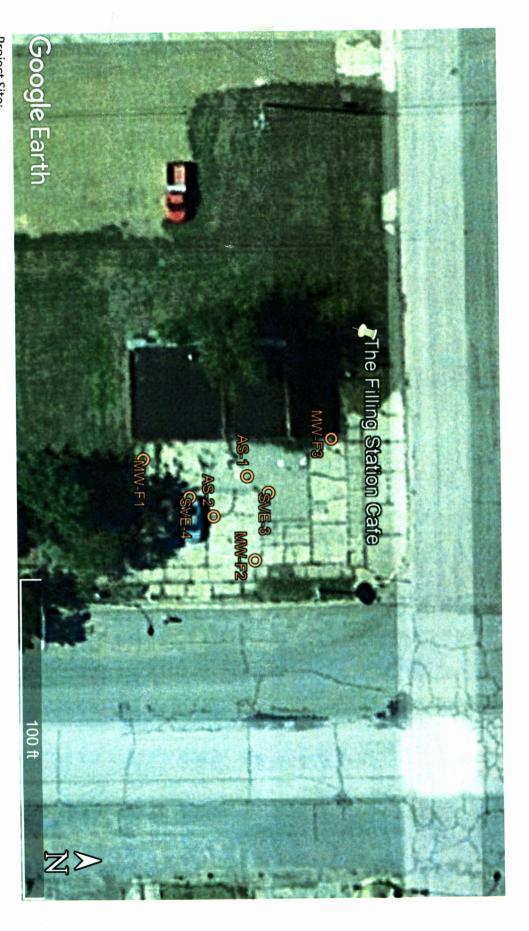

Project Site:

The Filling Station Café, 109 N. Broadway, Protection KDHE Project Code: U1-017-00296

GPS Coordinates:

AS-1: AS-2: MW-F2: MW-F1: 37.201725, -99.484446 37.201696, -99.484403 37.201637, -99.484465 37.201731, -99.484355 MW-F3: SVE-3: SVE-4:

MW-F3: 37.201797, -99.484486 SVE-3: 37.201743, -99.484428 SVE-4: 37.201676, -99.484424