
		RECORD	Form WV			Division of Wa	- 1			SVE-3
Original Record Correction Change in Well Use				Resources App. No.			Well ID			
1 LOCATION OF WATER WELL: Fraction SE 1/4 NW 1/4 SE 1/4					Section Number Township Number Range Number T 33 S R 20 □ E W					
2 WELL OWNER: Last Name: First: Street or Rural Address where well is located (if unknown, distance and										
Business	ng Station Ca	fe			rection from nearest town or intersection): If at owner's address, check here:					
Address: 109 N. Broadway Avenue										
Address:										
City: Protection State: KS ZIP: 67127										
WITH '		4 DEPTH	OF COMPL	ETED WELL: .	25	ft. 5 Latit	ude:	37.201743		decimal degrees)
i	ON BOX:			untered: 1)		Long	ritud	e: -99.48442	8 (decimal degrees)
N 2) ft. 3) ft.,					Dry Well			Datum: WGS 84		
			TATIC WATER		Source		Latitude/Longitude:			
	'	below l	and surface, mea	·yr)	🗆 (unit make/model:			
NW	NE		and surface, mea		(= = - = = = = =)			o)		
w - -	Pump test data: Well water was									
'	1 ' 1		was f		Online Mapper: Google Earth					
sw	SE	hours pun				4057	-			
		Estimated Y	Estimated Yield gnm			6 Elevation: 100/ ft.			Ground	Level 🗌 TOC
	S	Bore Hole I	Bore Hole Diameter:11 in. to25						pographic Map	
1						Other Soogle Fall	u			
7 WELL WATER TO BE USED AS:										
1. Domestic: 5. Public Water Supply: well ID Household 6. Dewatering: how many wells?										
_	☐ Household Color Dewatering: how many wells? Lawn & Garden Color Dewatering: how many wells? Aquifer Recharge: well ID									
_	Livestock Adulter Recharge: Well ID					∐. C 12 Geot		al: how many bores?.		
	2. ☐ Irrigation 9. Environmental Remediation: well ID						losed	Loop Horizontal	□ Vertic	 al
3. Feedlo	3. ☐ Feedlot ☐ Air Sparge ☐ Soil Vapor H									
4. 🔲 Indust	rial		Recovery	☐ Injection		13. Other (specify):				
Was a chemical/bacteriological sample submitted to KDHE? ☐ Yes ■ No If yes, date sample was submitted:										
Water well disinfected? ☐ Yes ■ No										
8 TYPE OF CASING USED: ☐ Steel ■ PVC ☐ Other										
Casing diameter										
Casing height above land surface										
TYPE OF SCREEN OR PERFORATION MATERIAL:										
☐ Steel ☐ Stainless Steel ☐ Fiberglass ■ PVC ☐ Other (Specify)										
☐ Brass ☐ Galvanized Steel ☐ Concrete tile ☐ None used (open hole) SCREEN OR PERFORATION OPENINGS ARE:										
☐ Continuous Slot ■ Mill Slot ☐ Gauze Wrapped ☐ Torch Cut ☐ Drilled Holes ☐ Other (Specify)										
SCREEN-PERFORATED INTERVALS: From10										
GRAVEL PACK INTERVALS: From 8 ft. to 25 ft., From ft. to ft., From ft. to ft.										
9 GROUT MATERIAL: Neat cement Cement grout Rentonite Other										
9 GROUT MATERIAL: ☐ Neat cement ☐ Cement grout ☐ Bentonite ☐ Other										
Nearest sou	rce of possi	ble contaminati	on:			•				
☐ Septic			Lateral Lines	☐ Pit Privy	_	Livestock Pe		☐ Insecticide		
☐ Sewer	Lines ight Sewer L		Cess Pool	Sewage Lag		Fuel Storage				/ell
			Seepage Pit	☐ Feedyard	Ĺ	Fertilizer Sto	rage	☐ Oil Well/0	jas Well	
Direction fro	om well?	• • • • • • • • • • • • • • • • • • • •		Distance from we	 112			ft.		
10 FROM	ТО	L	ITHOLOGIC I	OG.	FROM	ТО	LITE	HO. LOG (cont.) or PI	UGGING	INTERVALS
0	5	Clay, silty, sa				1		10. Ed & (cont.) of 11	20001110	INTERVILES
5	15	Fill sand			1	1				
15	25	Clay, silty, Da	ark Brown							~
						1				
										
					Notes:	KDHE Project	#U1-0	17-00296		
11 CONTRACTOR'S OR LANDOWNER'S CERTIFICATION: This water well was constructed, reconstructed, or plugged										
under my jurisdiction and was completed on (mo-day-year) .12/16/2021 and this record is true to the best of my knowledge and belief. Kansas Water Well Contractor's License No. 527 This Water Well Record was completed on (mo-day-year) .12/2.1/2021										
I under the h	uer well Co	nuractor's Lice	nse No. ?A! È IIC	Inis Wa	ter Well Re	ecord was con	nplej	ed on (mo-day year) .(<i>4)4:</i> (/.	1V4.I
Mail	1 white copy a	long with a fee of	\$5.00 for each con-	structed well to: Kan	sas Denartme	nt of Health and	Envir	onment, Bureau of Water	. GWTS Se	ection.
								your records. Telephone		
		ce gov/waterwell/i			KCV 650 1					7/10/2015

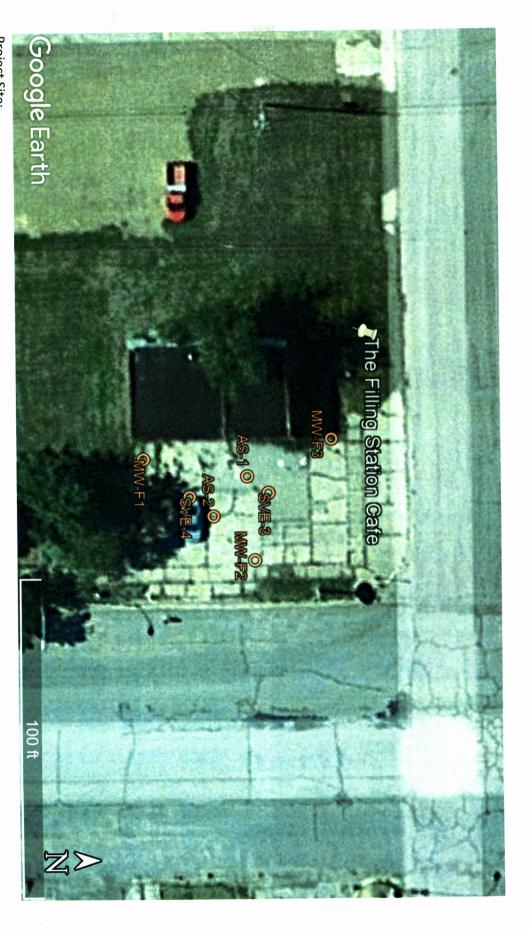

Project Site:

The Filling Station Café, 109 N. Broadway, Protection KDHE Project Code: U1-017-00296

GPS Coordinates:

AS-1: AS-2: MW-F2: MW-F1: 37.201725, -99.484446 37.201696, -99.484403 37.201637, -99.484465 37.201731, -99.484355 MW-F3: SVE-3: SVE-4:

MW-F3: 37.201797, -99.484486 SVE-3: 37.201743, -99.484428 SVE-4: 37.201676, -99.484424