
		RECORD		WWC-5	Div	ision of Water		SVE-4	
				e in Well Use		ources App. No		Well ID	
1 LOCATION OF WATER WELL:				Fraction	Section Number Township Number Range Number				
	y: Comano			SE 1/4 NW 1/4 SE 1/4					
2 WELL			ia.	First:	Street or Rural Address where well is located (if unknown, distance and				
Business: The Filling Station Cafe Address: 109 N. Broadway Avenue direction from nearest town or intersection): If at owner's address, check here									
Address:	103 14. D	loadway Ave	ilue						
City:	Protection	n	State: KS	ZIP: 67127					
3 LOCAT		4 DEPTH	OF COM	IPLETED WELL: .	24.75 A	5 Latitud	37.2016	76 (decimal degrees)	
WITH "				Encountered: 1)		Longity	-99.484	424 (decimal degrees)	
	ON BOX:			3) ft., or 4) [4 D NAD 83 D NAD 27	
 	· · · · · · · · · · · · · · · · · · ·	WELL'S ST	STATIC WATER LEVEL: ft.			Source f	Source for Latitude/Longitude:		
'			below land surface, measured on (mo-day-yr)				S (unit make/model:)	
ww	NE		above land surface, measured on (mo-day-yr)				(111-10 11-10)		
			ump test data: Well water was			☐ Land Survey ☐ Topographic Map ☐ Online Mapper: Google Earth			
	1 ' 1			vater was f					
after hours				pumping			1050		
	Estimated Yield:			gnm				Ground Level TOC	
S Bore Hole Diameter:				11 in. to 25	ft. and			GPS Topographic Map arth	
		O DE LICED		in. to	ft.		Onici Sasais He	V.V	
7 WELL WATER TO BE USED AS: 1. Domestic: 5. □ Public Water Supply: well ID									
☐ House								ease	
 									
Livest	ock			g: well ID					
2. Irrigation 9. Environmental Remediation					D SVE-4 a) Closed Loop				
3. Feedlo				Soil Vapor I					
4. Indust			Recovery						
Was a chemical/bacteriological sample submitted to KDHE? Yes No If yes, date sample was submitted:									
Water well disinfected? ☐ Yes ■ No									
8 TYPE OF CASING USED: ☐ Steel ☐ PVC ☐ Other									
Casing diameter									
Casing height above land surface									
☐ Steel ☐ Stainless Steel ☐ Fiberglass ■ PVC ☐ Other (Specify)									
☐ Brass ☐ Galvanized Steel ☐ Concrete tile ☐ None used (open hole)									
SCREEN OR PERFORATION OPENINGS ARE:									
☐ Continuous Slot ☐ Mill Slot ☐ Gauze Wrapped ☐ Torch Cut ☐ Drilled Holes ☐ Other (Specify)									
☐ Louvered Shutter ☐ Key Punched ☐ Wire Wrapped ☐ Saw Cut ☐ None (Open Hole)									
SCREEN-PERFORATED INTERVALS: From									
GRAVEL PACK INTERVALS: From									
9 GROUT MATERIAL: ☐ Neat cement ☐ Cement grout ☐ Bentonite ☐ Other									
Nearest son	rce of nossi	II. IO hle contaminati		. п., From	n. to	n., From	It. to	tt.	
Nearest source of possible contamination: Septic Tank									
Sewer Lines Cess Pool Sewage Lagoon Fuel Storage Abandoned Water Well									
☐ Watertight Sewer Lines ☐ Seepage Pit ☐ Feedyard ☐ Fertilizer Storage ☐ Oil Well/Gas Well									
□ Other (Specify) ft. Direction from well? ft.									
10 FROM	TO								
0	4	Clay, silty, sa	ITHOLOG		FROM	TO L.	THO. LOG (cont.) or	PLUGGING INTERVALS	
4	24.5	Fill sand	iliuy, brov	WII	-				
24.5	25	Clay, Dark B	rown		 				
		Olay, Dark Di	OWII		+				

Notes: KDHE Project #U1-017-002						1-017-00296			
11 CONTRACTOR'S OR LANDOWNER'S CERTIFICATION: This water well was constructed, reconstructed, or plugged									
under my jurisdiction and was completed on (mo-day-year) 12/16/2021 and this record is true to the best of my knowledge and belief. Kansas Water Well Contractor's License No. 527 This Water Well Record was completed on (mo-day-year) 12/21/2021									
under the business name of GeoCore. LLC									
Mail 1 white copy along with a fee of \$5.00 for each constructed well to: Kansas Department of Health and Environment, Bureau of Water, GWTS Section,									
				66612-1367. Mail one to					
		ks.gov/waterwell/i			KSA 82a-12			Revised 7/10/2015	

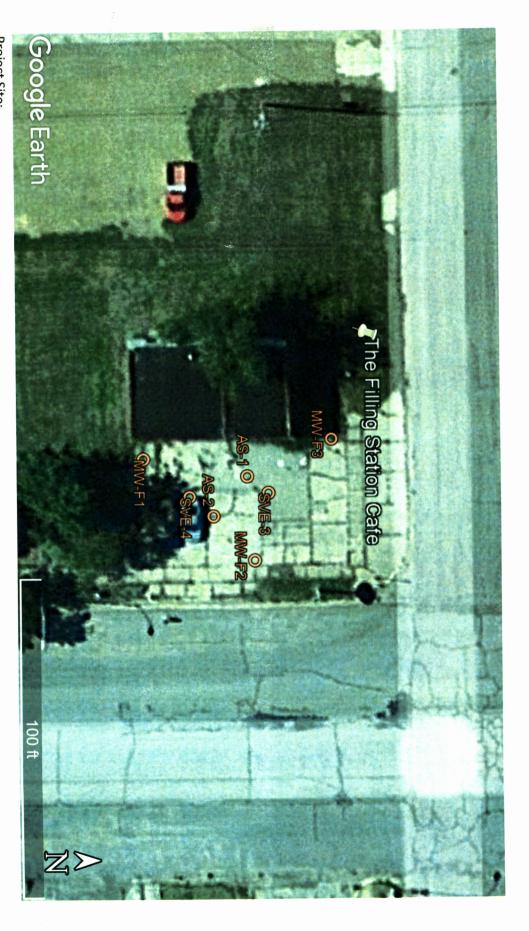

Project Site:

The Filling Station Café, 109 N. Broadway, Protection KDHE Project Code: U1-017-00296

GPS Coordinates:

AS-1: AS-2: MW-F2: MW-F1: 37.201725, -99.484446 37.201696, -99.484403 37.201637, -99.484465 37.201731, -99.484355 MW-F3: SVE-3: SVE-4:

MW-F3: 37.201797, -99.484486 SVE-3: 37.201743, -99.484428 SVE-4: 37.201676, -99.484424