

WATER WELL RECORD Form WWC-5


Original Record Correction Change in Well Use

Division of Water Resources App. No.

Well ID MW25

| | | | | |
|--|---------------------------------|---------------------|---------------------------|---|
| 1 LOCATION OF WATER WELL: County: Comanche | Fraction SW ¼ SW ¼ NE ¼ NW ¼ | Section Number 3 | Township Number T 33 S | Range Number R 20 <input type="checkbox"/> E <input checked="" type="checkbox"/> W |
|--|---------------------------------|---------------------|---------------------------|---|

| | |
|---|--|
| 2 WELL OWNER: Last Name: First: Business: Alliance Ag & Grain, LLC Address: 311 N. Main Address: City: Greensburg State: KS ZIP: 67054 | Street or Rural Address where well is located (if unknown, distance and direction from nearest town or intersection): If at owner's address, check here: <input type="checkbox"/> 401 N. Broadway, Protection |
|---|--|
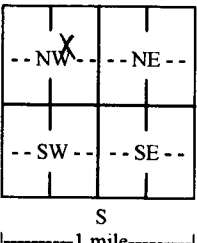
| | | |
|---|--|---|
| 3 LOCATE WELL WITH "X" IN SECTION BOX: N  W E S 1 mile | 4 DEPTH OF COMPLETED WELL: 25 ft. Depth(s) Groundwater Encountered: 1) 22 ft. 2) ft. 3) ft., or 4) <input type="checkbox"/> Dry Well WELL'S STATIC WATER LEVEL: ft. <input type="checkbox"/> below land surface, measured on (mo-day-yr)..... <input type="checkbox"/> above land surface, measured on (mo-day-yr)..... Pump test data: Well water was ft. after hours pumping gpm Well water was ft. after hours pumping gpm Estimated Yield: gpm Bore Hole Diameter: 8 in. to 25 ft. and in. to ft. | 5 Latitude: 37.204061 (decimal degrees) Longitude: -99.484830 (decimal degrees) Horizontal Datum: <input checked="" type="checkbox"/> WGS 84 <input type="checkbox"/> NAD 83 <input type="checkbox"/> NAD 27 Source for Latitude/Longitude: <input type="checkbox"/> GPS (unit make/model:) (WAAS enabled? <input type="checkbox"/> Yes <input type="checkbox"/> No) <input type="checkbox"/> Land Survey <input type="checkbox"/> Topographic Map <input checked="" type="checkbox"/> Online Mapper: Google Earth |
| 6 Elevation: ft. <input type="checkbox"/> Ground Level <input type="checkbox"/> TOC Source: <input type="checkbox"/> Land Survey <input type="checkbox"/> GPS <input type="checkbox"/> Topographic Map <input type="checkbox"/> Other | | |

7 WELL WATER TO BE USED AS:

| | | |
|--|--|---|
| 1. Domestic: <input type="checkbox"/> Household <input type="checkbox"/> Lawn & Garden <input type="checkbox"/> Livestock | 5. <input type="checkbox"/> Public Water Supply: well ID | 10. <input type="checkbox"/> Oil Field Water Supply: lease |
| 2. <input type="checkbox"/> Irrigation | 6. <input type="checkbox"/> Dewatering: how many wells? | 11. Test Hole: well ID |
| 3. <input type="checkbox"/> Feedlot | 7. <input type="checkbox"/> Aquifer Recharge: well ID | <input type="checkbox"/> Cased <input type="checkbox"/> Uncased <input type="checkbox"/> Geotechnical |
| 4. <input type="checkbox"/> Industrial | 8. <input checked="" type="checkbox"/> Monitoring: well ID MW25 | 12. Geothermal: how many bores? |
| | 9. Environmental Remediation: well ID | a) Closed Loop <input type="checkbox"/> Horizontal <input type="checkbox"/> Vertical |
| | <input type="checkbox"/> Air Sparge <input type="checkbox"/> Soil Vapor Extraction | b) Open Loop <input type="checkbox"/> Surface Discharge <input type="checkbox"/> Inj. of Water |
| | <input type="checkbox"/> Recovery <input type="checkbox"/> Injection | 13. <input type="checkbox"/> Other (specify): |

Was a chemical/bacteriological sample submitted to KDHE? Yes No If yes, date sample was submitted:

Water well disinfected? Yes No

8 TYPE OF CASING USED: Steel PVC Other CASING JOINTS: Glued Clamped Welded Threaded
Casing diameter 2 in. to 10 ft., Diameter in. to ft., Diameter in. to ft.
Casing height above land surface Flush in. Weight lbs./ft. Wall thickness or gauge No. Sch. 40

TYPE OF SCREEN OR PERFORATION MATERIAL:
 Steel Stainless Steel Fiberglass PVC Other (Specify)
 Brass Galvanized Steel Concrete tile None used (open hole)

SCREEN OR PERFORATION OPENINGS ARE:
 Continuous Slot Mill Slot Gauze Wrapped Torch Cut Drilled Holes Other (Specify)
 Louvered Shutter Key Punched Wire Wrapped Saw Cut None (Open Hole)

SCREEN-PERFORATED INTERVALS: From 10 ft. to 25 ft., From ft. to ft., From ft. to ft.
GRAVEL PACK INTERVALS: From 8 ft. to 25 ft., From ft. to ft., From ft. to ft.

9 GROUT MATERIAL: Neat cement Cement grout Bentonite Other


Grout Intervals: From 0 ft. to 1 ft., From 1 ft. to 8 ft., From ft. to ft.

Nearest source of possible contamination:
 Septic Tank Lateral Lines Pit Privy Livestock Pens Insecticide Storage
 Sewer Lines Cess Pool Sewage Lagoon Fuel Storage Abandoned Water Well
 Watertight Sewer Lines Seepage Pit Feedyard Fertilizer Storage Oil Well/Gas Well
 Other (Specify) Contaminated site

Direction from well? Distance from well? ft.

| 10 FROM | TO | LITHOLOGIC LOG | FROM | TO | LITHO. LOG (cont.) or PLUGGING INTERVALS |
|--|-----|---|------|----|--|
| 0 | 0.5 | Concrete | | | |
| 0.5 | 3.5 | Clay, silty, Dark Gray Brown | | | |
| 3.5 | 6 | Clay, silty, Gray Brown | | | |
| 6 | 18 | Clay, silty, Brown | | | |
| 18 | 22 | Clay, silty, Dark Gray Brown to Dark Gray | | | |
| 22 | 25 | Sand, vf-c, silty, Dark Gray | | | |
| Notes: KDHE Project #U1-017-00242 | | | | | |

11 CONTRACTOR'S OR LANDOWNER'S CERTIFICATION: This water well was constructed, reconstructed, or plugged under my jurisdiction and was completed on (mo-day-year) 3/7/2022 and this record is true to the best of my knowledge and belief. Kansas Water Well Contractor's License No. 527 This Water Well Record was completed on (mo-day-year) under the business name of GeoCore, LLC. Signature *[Signature]*

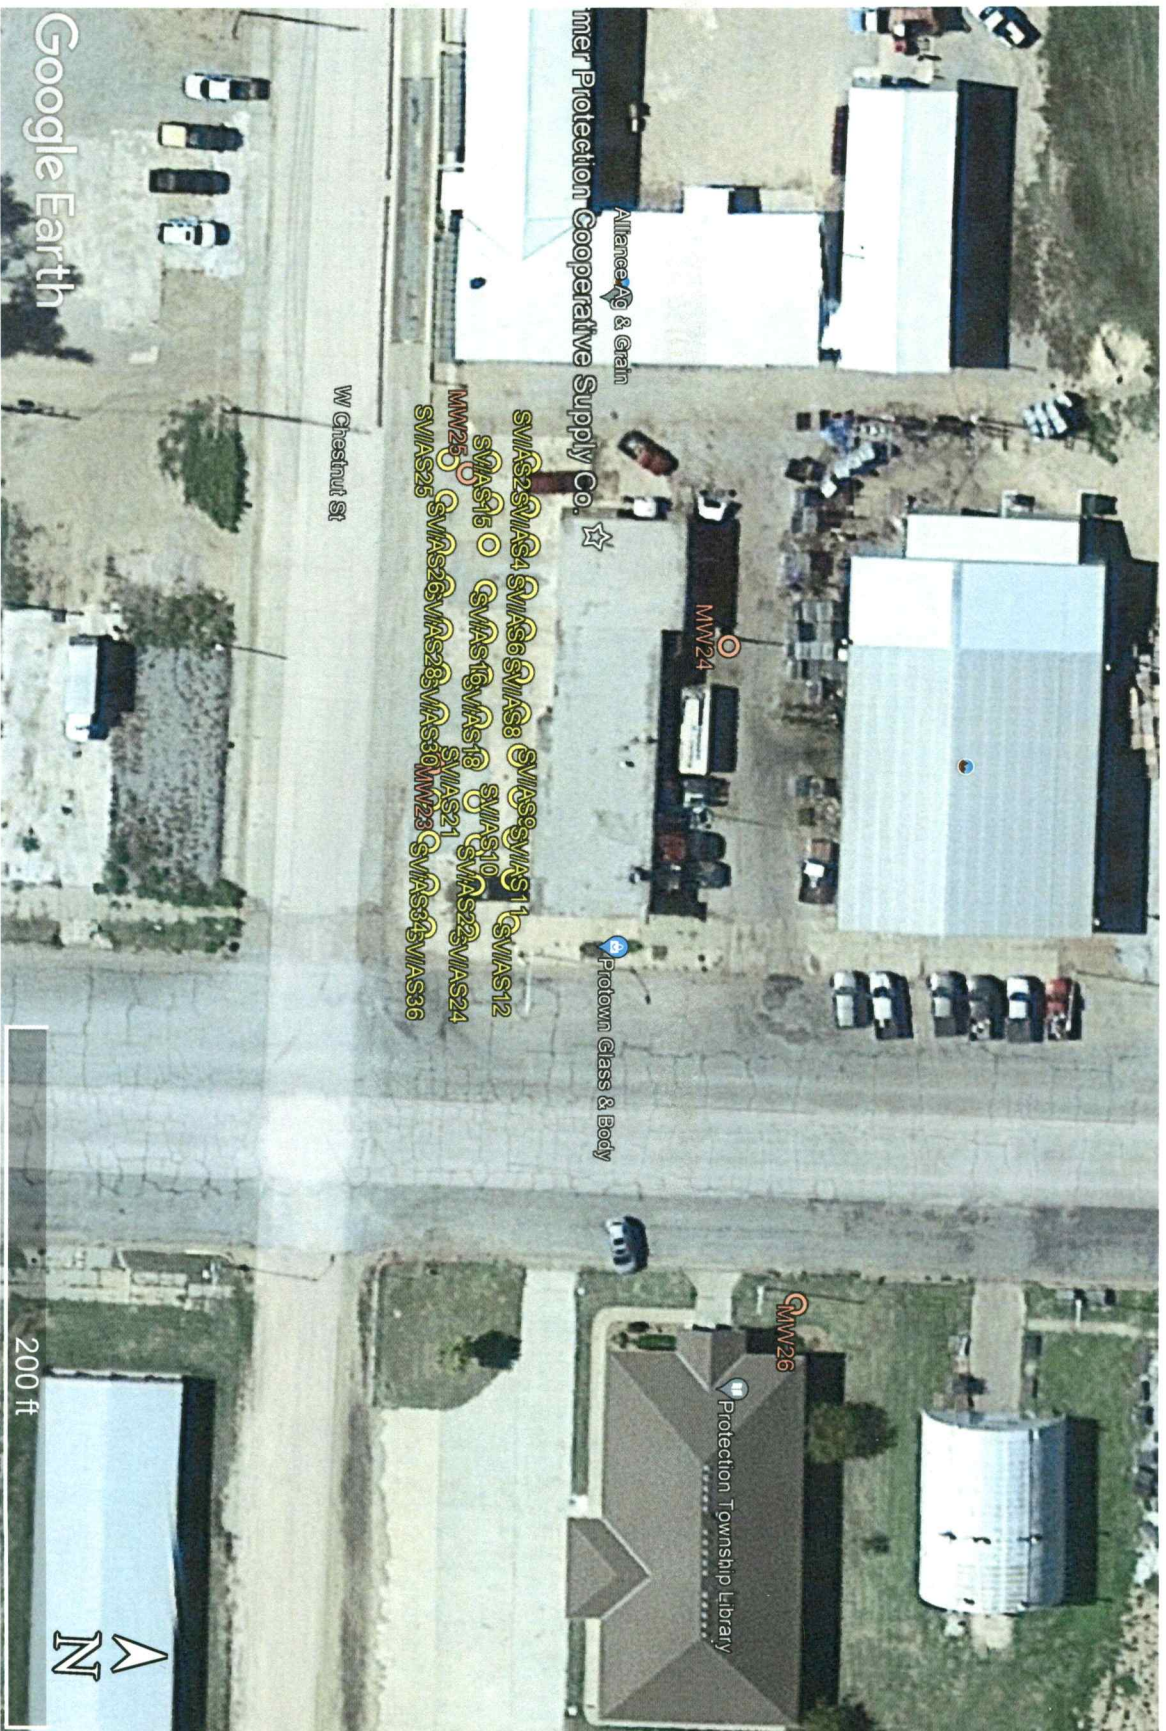

Project Site:


Protection Cooperative Supply Co., 401 N. Broadway Ave., Protection, Kansas

KDHE Project Code: U1-017-00242

Comanche

T335 - Row - Sec. 3

KS# 8834212
Comanche

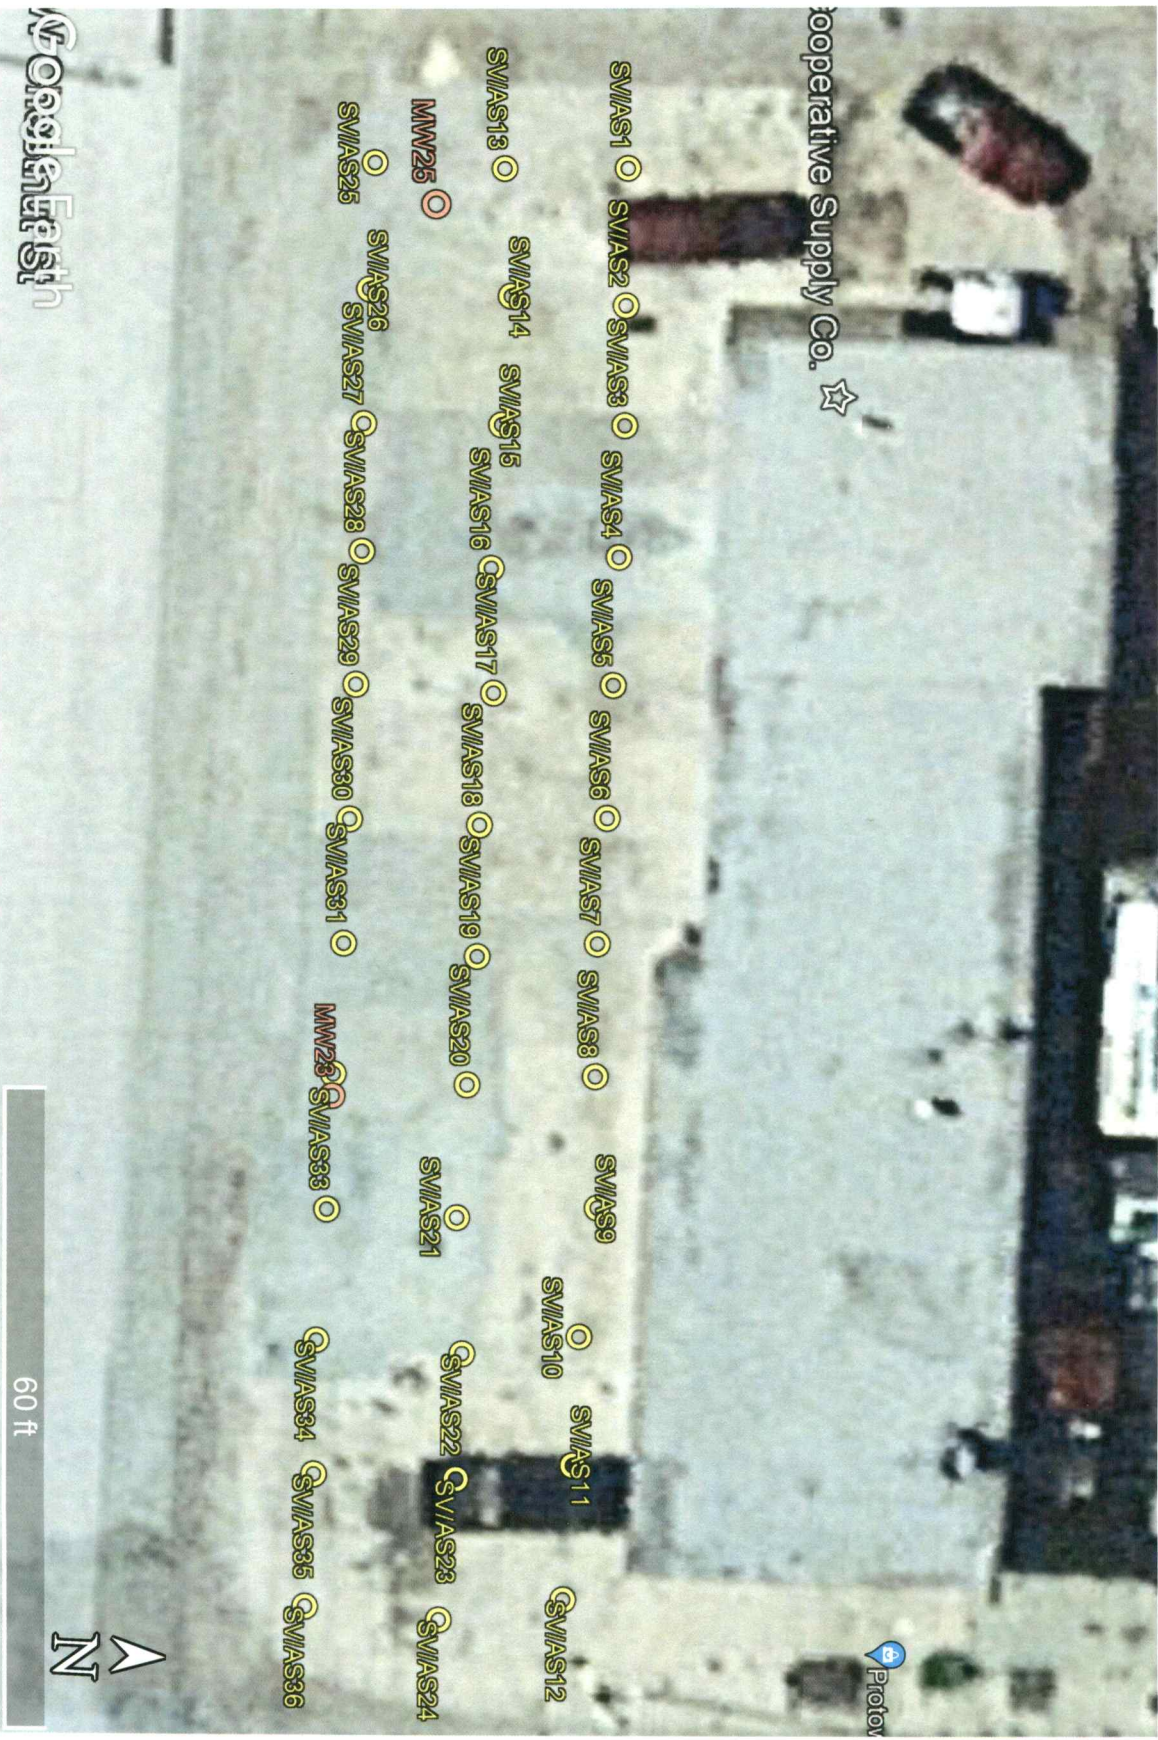

Comanche

1335 - ROW - Sec 3

*KSJ
Comanche*

Protection Cooperative Supply Co., 401 N. Broadway, Protection – KDHE Project #U1-017-00242
Page 3 of 3

GPS Coordinates:

| | | |
|--------------------------------|--------------------------------|--------------------------------|
| SV/AS1: 37.204109, -99.484843 | SV/AS13: 37.204078, -99.484842 | SV/AS25: 37.204045, -99.484843 |
| SV/AS2: 37.204110, -99.484799 | SV/AS14: 37.204081, -99.484801 | SV/AS26: 37.204045, -99.484802 |
| SV/AS3: 37.204111, -99.484761 | SV/AS15: 37.204080, -99.484760 | SV/AS27: 37.204045, -99.484759 |
| SV/AS4: 37.204111, -99.484719 | SV/AS16: 37.204079, -99.484714 | SV/AS28: 37.204046, -99.484718 |
| SV/AS5: 37.204111, -99.484678 | SV/AS17: 37.204081, -99.484674 | SV/AS29: 37.204046, -99.484675 |
| SV/AS6: 37.204111, -99.484636 | SV/AS18: 37.204079, -99.484632 | SV/AS30: 37.204046, -99.484632 |
| SV/AS7: 37.204110, -99.484596 | SV/AS19: 37.204080, -99.484590 | SV/AS31: 37.204046, -99.484592 |
| SV/AS8: 37.204111, -99.484554 | SV/AS20: 37.204079, -99.484549 | SV/AS32: 37.204045, -99.484550 |
| SV/AS9: 37.204113, -99.484513 | SV/AS21: 37.204078, -99.484507 | SV/AS33: 37.204045, -99.484507 |
| SV/AS10: 37.204110, -99.484472 | SV/AS22: 37.204081, -99.484464 | SV/AS34: 37.204044, -99.484465 |
| SV/AS11: 37.204110, -99.484431 | SV/AS23: 37.204081, -99.484424 | SV/AS35: 37.204045, -99.484422 |
| SV/AS12: 37.204109, -99.484388 | SV/AS24: 37.204078, -99.484379 | SV/AS36: 37.204044, -99.484380 |
| MMW23: 37.204045, -99.484543 | MMW25: 37.204061, -99.484830 | |
| MMW24: 37.204270, -99.484671 | MMW26: 37.204347, -99.484026 | |