
WATER WELL		WWC-5	Divi	sion of Water		AS04		
Original Record		ige in Well Use		urces App. No.		Well ID		
1 LOCATION OF	WATER WELL:	Fraction	I .	tion Number	Township Numl			
County: Clark	NW 1/4 NW 1/4 SE 1/4				R 24 □ E ■ W			
2 WELL OWNER: Last Name: First: Street or Rural Address where well is located (if unknown, distance and								
Business: DCP Midstream, LP direction from nearest town or intersection): If at owner's address, check here:								
Address: 370 17th Street, Ste 2500 Address: ~2 mi. NE of Engelwood, KS								
City: Denver	State: CC			,				
3 LOCATE WELL			20 0		27.0594	04		
WITH "X" IN	CATE WELL H "X" IN  4 DEPTH OF COMPLETED WELL:30 ft. 5 Latitude:37.058404 (decimal decimal decimal decimal decimal)							
SECTION BOX:		Depth(s) Groundwater Encountered: 1)				ngitude: -99.946520 (decimal degrees) rizontal Datum: ■ WGS 84 □ NAD 83 □ NAD 27		
N	WELL'S STATIC WATER LEVEL: ft.				Source for Latitude/Longitude:			
	□ below land surface, measured on (mo-day-yr) □ GPS (unit make/model:							
NW NE	above land surface			(WAAS enabled? ☐ Yes ☐ No)				
X		Pump test data: Well water was ft.				☐ Land Survey ☐ Topographic Map		
W		after hours pumpinggpm				Online Mapper: Google Earth		
SW SE		Well water was ft.						
31.		after hours pumping						
S	Estimated Yield:	Estimated Yield:gpm Bore Hole Diameter:8in. to30ft. and			Source: Land Survey GPS Topographic Map			
1 mile	Dote Hote Diameter min to min to make							
7 WELL WATER TO BE USED AS:								
1. Domestic:		ater Supply: well ID		10. □ Oil Fi	eld Water Supply	ease		
Household	Dewatering: how many wells?   Dewatering: how many wells?			10. Oil Field Water Supply: lease				
☐ Lawn & Garden					☐ Cased ☐ Uncased ☐ Geotechnical			
☐ Livestock	☐ Livestock 8. ☐ Monitoring: well ID				12. Geothermal: how many bores?			
2. Irrigation					a) Closed Loop    Horizontal    Vertical			
3. Feedlot	Air Spar		Extraction			ischarge  Inj. of Water		
4. Industrial Recovery Injection 13. Other (specify):								
Was a chemical/bacteriological sample submitted to KDHE?  Yes No If yes, date sample was submitted:								
Water well disinfected? ☐ Yes ■ No								
8 TYPE OF CASING USED: ☐ Steel ■ PVC ☐ Other								
Casing diameter								
Casing height above land surface in. Weight lbs./ft. Wall thickness or gauge No. Sch. 40								
TYPE OF SCREEN OR PERFORATION MATERIAL:								
☐ Steel     ☐ Stainless Steel     ☐ Fiberglass     ☐ PVC     ☐ Other (Specify)       ☐ Brass     ☐ Galvanized Steel     ☐ Concrete tile     ☐ None used (open hole)								
SCREEN OR PERFORATION OPENINGS ARE:								
☐ Continuous Slot ■ Mill Slot ☐ Gauze Wrapped ☐ Torch Cut ☐ Drilled Holes ☐ Other (Specify)								
□ Louvered Shutter □ Key Punched □ Wire Wrapped □ Saw Cut □ None (Open Hole)								
SCREEN-PERFORATED INTERVALS: From 25 ft. to 30 ft. From ft. to ft. From ft. to ft.								
GRAVEL PACK INTERVALS: From								
9 GROUT MATERIAL:  Neat cement  Cement grout Bentonite Other								
Grout Intervals: From								
Nearest source of possible contamination:								
☐ Septic Tank ☐ Lateral Lines ☐ Pit Privy ☐ Livestock Pens ☐ Insecticide Storage								
☐ Sewer Lines ☐ Cess Pool ☐ Sewage Lagoon ☐ Fuel Storage ☐ Abandoned Water Well								
☐ Watertight Sewer Lines ☐ Seepage Pit ☐ Feedyard ☐ Fertilizer Storage ☐ Oil Well/Gas Well								
■ Other (Specify) .Contaminated site								
10 FROM TO	LITHOLO		FROM			r PLUGGING INTERVALS		
0 10	Hydrovac	010 100	1 110111	TO LI				
10 25	Sand, f-m, Lt. Brown	and Brown	<del>                                     </del>					
25 30	Sand, f-m, Brown	S.IN DISTILL	1					
	Jana, Till, Brown							
			Notes:					
11 CONTRACTOR'S OR LANDOWNER'S CERTIFICATION: This water well was constructed, reconstructed, or plugged								
under my jurisdiction and was completed on (mo-day-year) .9/12/2018 and this record is true to the best of my knowledge and belief.								
Kansas Water Well Contractor's License No. 527 This Water Well Record was completed on (ppday-year) 1/11/2019								
under the business name of GeoCore Inc.  Signature Signature Of GeoCore Inc.								
Mail 1 white copy along with a fee of \$5.00 for each constructed well to: Kansas Department of Health and Environment, Bureau of Water, GWTS Section, 1000 SW Jackson St., Suite 420, Topeka, Kansas 66612-1367. Mail one to Water Well Owner and retain one for your records. Telephone 785-296-5524.								
			Water Well Own KSA 82a-121		or your records. Telepl	Revised 7/10/2015		
visit us at http://www.kdhe	ks.gov/waterwell/index.html		NOM 028-12	14	The second second second	ACVISCU //10/2013		

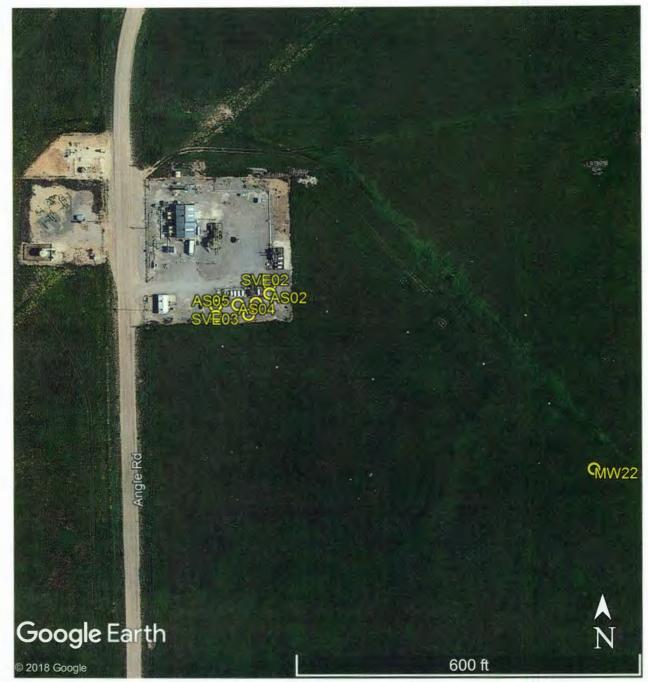

ALL INSTALLED WELLS (Sheet 1 of 2)

DCP Midstream, LP
~2 mi. NE of Englewood, KS Clark Co.#1
(Tasman Geoscience)

## **GPS Coordinates:**

AS02: 37.058458, -99.946332 MW22: 37.057615, -99.944401 AS03: 37.058401, -99.946413 SVE02: 37.058500, -99.946331 AS04: 37.058404, -99.946520 SVE03: 37.058356, -99.946456 AS05: 37.058400, -99.946651 SVE04: 37.058349, -99.946650 RECEIVED

JAN 3 1 2019

**BUREAU OF WATER** 

29-345 24W NW NW SE NE Clark



FOCUSED ON MAIN CLUSTER OF WELLS (Sheet 2 of 2)

DCP Midstream, LP ~2 mi. NE of Englewood, KS Clark Co. #1 (Tasman Geoscience)

## **GPS Coordinates:**

AS02: 37.058458, -99.946332 AS03: 37.058411, -99.946413 ASO4: 37.058404, -99.946520 AS05: 37.058400, -99.946651

MW22: 37.057615, -99.944401 SVE02: 37.058500, -99.946331 SVE03: 37.058356, -99.946456 SVE04: 37.058349, -99.946650 RECEIVED

JAN 3 1 2019

BUREAU OF WATER