
			WWC-5		Division of War		137 11 15	QMW-2R	
			ge in Well Use Fraction		esources App.		Well ID	aa Numbar	
1 LOCATION OF WATER WELL: County: Seward			SE 1/4 NE 1/4 SE 1/4		Section Number Township Number Number Township Number			ige Number 3 □ E ■ W	
	OWNER:		First:	Street or Rural Address where well is located (if unknown, distance and					
	Business: KDHE				direction from nearest town or intersection): If at owner's address, check here:				
II	Address: 1000 SW Jackson, Ste 410								
					1001 N. Lincoln, Liberal				
3 LOCA	<u>Topeka</u>	State: KS	ZIP: 66612				 		
	"X" IN	4 DEPTH OF COM	MPLETED WELL: .	200	ft. 5 Latit	ude: 37.0491	58	(decimal degrees)	
SECTION BOX: Depth(s) Groundwater Encountered: 1)				ft. Longitude: 100.923063 (decimal degrees)					
	N	2) ft.	3) ft., or 4) [ft., or 4) Dry Well Horizontal Datum: WGS 84 NAD 83					
		WELL'S STATIC WA	TER LEVEL:!82	R LEVEL:182.51ft. easured on (mo-day-yr)8/4/22 GPS (unit make/model: EPOCH					
'	'	below land surface	e, measured on (mo-day-	·yr) <u>9/4/</u>	₹ ■ (GPS (unit make/model: .EPOCH (WAAS enabled? ☐ Yes ■ No)			
NW -	NE	☐ above land surface	r, measured on (mo-day-					io)	
w	$\frac{1}{1}$ E	after hour	's pumping	ft.					
1 1 1	l l	Well	water was f	ì.		Jillile Mappel	•••••		
sw-	SE	after hour	s pumping	gpm 2839 60 0 7 G 17 1 7					
	للل	Estimated Yield:	ted Yield:gpm Jole Diameter: 8.5 in to 200 ft.			6 Elevation: 2839.60ft. ☐ Ground Level ■ TOC Source: ■ Land Survey ☐ GPS ☐ Topographic Map			
1. Domestic			ater Supply: well ID		10 🗆 0	nil Field Water Commiss. 1	anca		
ı	☐ Household 6. ☐ Dewatering: how many wells?				10. Oil Field Water Supply: lease				
	_ si zinating, nen manj				☐ Cased ☐ Uncased ☐ Geotechnical				
	☐ Lawn & Garden ☐ Livestock 7. ☐ Aquifer Recharge: well ID Monitoring: well ID OMI				12. Geot	12. Geothermal: how many bores?			
2. Irriga		9. Environment	al Remediation: well II						
3. ☐ Feedlot ☐ Air Sparge ☐ Soil 4. ☐ Industrial ☐ Recovery ☐ Injection				Extraction b) Open Loop Surface Discharge Inj. of Water					
		Recovery	_ ,			ther (specify):			
Was a chemical/bacteriological sample submitted to KDHE? ☐ Yes ■ No If yes, date sample was submitted:									
8 TYPE OF CASING USED: Steel DVC Other CASING IOINTS: Closed Closed Closed Closed Closed Closed Closed Closed Closed Closed Closed Closed Closed Closed Closed									
Casing diameter 4 in to 200 ft Diameter in to ft Diameter in to ft									
Casing diameter 4 in to 200 ft., Diameter in to ft. Casing height above land surface 4 in Weight lbs./ft. Wall thickness or gauge No.									
TIPE OF SCREEN OR PERFORATION MATERIAL:									
☐ Steel ☐ Stainless Steel ☐ Fiberglass ☐ PVC ☐ Other (Specify)									
☐ Brass ☐ Galvanized Steel ☐ Concrete tile ☐ None used (open hole)									
SCREEN OR PERFORATION OPENINGS ARE: ☐ Continuous Slot									
Louvered Shutter									
GRAVEL PACK INTERVALS: From 168 ft. to 200 ft., From ft. to ft., From ft. to ft.									
9 GROUT MATERIAL: Neat cement Cement grout Bentonite Other									
Grout Intervals: From									
Nearest source of possible contamination:									
☐ Septic		☐ Lateral Line	,		Livestock Po	ens 🔲 Insectio	cide Storage		
Sewer		☐ Cess Pool	☐ Sewage Lag		Fuel Storage		oned Water V	Well	
☐ Watertight Sewer Lines ☐ Seepage Pit ☐ Feedyard ☐ Fertilizer Storage ☐ Oil Well/Gas Well									
Under (Specify) Direction from well? Distance from well?									
10 FROM	ТО	LITHOLO	GIC LOG	FROM	ТО	LITHO. LOG (cont.) or		INTERVALS	
0	8	Silty clay		150	158	Gravelly sand	· FOODING	JATLKYALS	
8	15	Clay		158	160	Sandstone			
15	31	Sand		160	174	Clayey sand			
31	40	Sandy clay		174		Gravelly sand			
40	81	Sand			·		·		
81	93	Sandy clay							
93	104	Clayey sand	Notes:	Notes: Quality Laundry and Cleaners					
104 128 Clay KDHE Project Co						•			
128 150 Caliche and clay									
11 CONTRACTOR'S OR LANDOWNER'S CERTIFICATION: This water well was constructed, reconstructed, or plugged									
under my jurisdiction and was completed on (mo-day-year) .6/17/2022 and this record is true to the best of my knowledge and belief.									
Kansas Water Well Contractor's License No. 881 This Water Well Record was completed on two-day-year 19/16/2022 under the business name of Woofter Pump and Well Signature									
Mail	I white copy al	long with a fee of \$5.00 for each	ch constructed well to: Kan	sas Denartme	ent of Health and	Environment Burezii of Wa	ater, GWTS S	ection.	
Mail I white copy along with a fee of \$5.00 for each constructed well to: Kansas Department of Health and Environment, Bureau of Water, GWTS Section, 1000 SW Jackson St., Suite 420, Topeka, Kansas 66612-1367. Mail one to Water Well Owner and retain one for your records. Telephone 785-296-5524.									
		ss.gov/waterwell/index.html		KSA 82a-		,		7/10/2015	

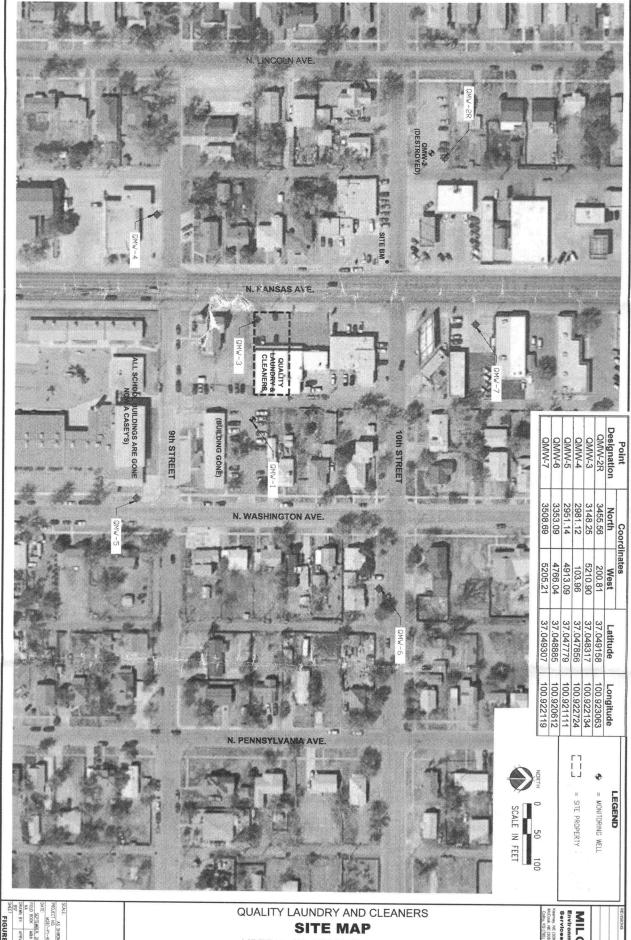

LIBERAL, KS KDHE #C1-088-71846

MILCO Environmental Services, Inc.