
_	WELL R		WWC-5			ion of Water		W 11 VD	QMW-3	
	Record _		e in Well Use			rces App. N		Well ID	NI1	
1 LOCATION OF WATER WELL: County: Seward			Fraction NW 1/4 SW 1/4 SW 1/2	4 NIM 1/4	Secti	on Number	Township Numbe		ige Number 3 □ E ■ W	
	OWNER: L	ast Name:	First:		Street or Rural Address where well is located (if unknown, distance and					
	KDHE	ast (vainc.	rust.		direction from nearest town or intersection): If at owner's address, check here:					
Address:	1000 SW	Jackson, Ste 410		907 N. Kansas, Liberal						
Address: City:	Topeka	State: KS	ZIP: 66612	307 14. 1	i (u) iSc	10, LIDOIG				
3 LOCAT										
WITH "			PLETED WELL: 200 ft.			5 Latitude: 37.048317 (decimal degrees)				
SECTION BOX.			Encountered: 1)			Longitude: 100.922134 (decimal degrees) Horizontal Datum: □ WGS 84 ■ NAD 83 □ NAD 27				
N	1	WELL'S STATIC WA	TER LEVEL 180).44 ft	CII		ntal Datum: WGS 84 for Latitude/Longitude:		83 LI NAD 27	
		below land surface, measured on (mo-day-yr)8/4/			2022	■ GPS (unit make/model: EPOCH				
NW	NE	above land surface	above land surface, measured on (mo-day-yr)			(WAAS enabled? ☐ Yes ■ No)				
x			imp test data: Well water was			☐ Land Survey ☐ Topographic Map				
W	E		Well water was ft.			Online Mapper:				
SW	SE		after hours pumping gpr			2837.87				
		Estimated Yield:	Estimated Yield:gpm			6 Elevation: 2037:07tt. Ground Level				
	S mile !		Hole Diameter: 8.5 in. to 200							
mile in. to ft.										
7 WELL WATER TO BE USED AS: 1. Domestic: 5.										
	☐ Household 6. ☐ Dewaterin			g: how many wells?			11. Test Hole: well ID			
☐ Lawn & Garden 7. ☐ Aquifer Re			echarge: well IDg: Well IDg: QMW-3			☐ Cased ☐ Uncased ☐ Geotechnical				
						12. Geothermal: how many bores?				
2. ☐ Irrigation 9. Environmenta 3. ☐ Feedlot ☐ Air Sparge				l Remediation: well ID			a) Closed Loop ☐ Horizontal ☐ Vertical b) Open Loop ☐ Surface Discharge ☐ Inj. of Water			
4. ☐ Industrial ☐ Recovery				Latiaction	13. Other (specify):					
Was a chemical/bacteriological sample submitted to KDHE? Yes No If yes, date sample was submitted:										
Water well disinfected? Yes No										
8 TYPE OF CASING USED: ☐ Steel ☐ PVC ☐ Other										
Casing diameter										
Casing height above land surface										
TYPE OF SCREEN OR PERFORATION MATERIAL:										
☐ Steel ☐ Fiberglass ■ PVC ☐ Other (Specify) ☐ Other (Specify) ☐ Brass ☐ Galvanized Steel ☐ Concrete tile ☐ None used (open hole)										
SCREEN OR PERFORATION OPENINGS ARE:										
☐ Continuous Slot ■ Mill Slot ☐ Gauze Wrapped ☐ Torch Cut ☐ Drilled Holes ☐ Other (Specify)										
□ Louvered Shutter □ Key Punched □ Wire Wrapped □ Saw Cut □ None (Open Hole)										
SCREEN-PERFORATED INTERVALS: From 170 ft. to 200 ft., From ft. to ft., From ft. to ft.										
GRAVEL PACK INTERVALS: From 168 ft. to 200 ft., From ft. to ft., From ft. to ft.										
9 GROUT MATERIAL: Neat cement Cement grout Bentonite Other Grout Intervals: From 1 ft. to 168 ft., From ft. to ft.										
Nearest source of possible contamination:										
☐ Septic Tank ☐ Lateral Lines ☐ Pit Privy ☐ Livestock Pens ☐ Insecticide Storage										
Sewer		Cess Pool	☐ Sewage L			uel Storage	☐ Abandor			
□ Watertight Sewer Lines □ Seepage Pit □ Feedyard □ Fertilizer Storage □ Oil Well/Gas Well □ Other (Specify) □ Other (Specify)										
Direction from well?										
10 FROM	TO	LITHOLO	GIC LOG	FRO			LITHO. LOG (cont.) or	PLUGGIN	G INTERVALS	
0		Thin layer of asphalt,	then concrete	130			Caliche and clay			
0.5		Clay		153			Clay			
16		Sand		178	2	201 (Gravelly sand			
69		Sandy clay								
78		Clayey sand Sandy clay					to			
96		Gravelly sand	Nato	Notes: Quality Laundry and Cleaners						
	104 118 Clay				KDHE Project Code: C1-088-71846					
118 130 Clay and caliche										
11 CONTRACTOR'S OR LANDOWNER'S CERTIFICATION: This water well was constructed, reconstructed, or plugged										
under my jurisdiction and was completed on (mo-day-year) .6/17/2022 and this record is true to the best of my knowledge and belief.										
Kansas Water Well Contractor's License No. 881 This Water Well Record was completed on (mo-day-year) 9/16/2022 under the business name of Woofter Pump and Well Signature										
Mail I white copy along with a fee of \$5.00 for each constructed well to: Kansas Department of Health and Environment, Bureau of Water, GWTS Section,										
1000 SW Jackson St., Suite 420, Topeka, Kansas 66612-1367. Mail one to Water Well Owner and retain one for your records. Telephone 785-296-5524.										
Visit us at http://www.kdhcks.gov/waterwell/index.html KSA 82a-1212 Revised 7/10/2015										

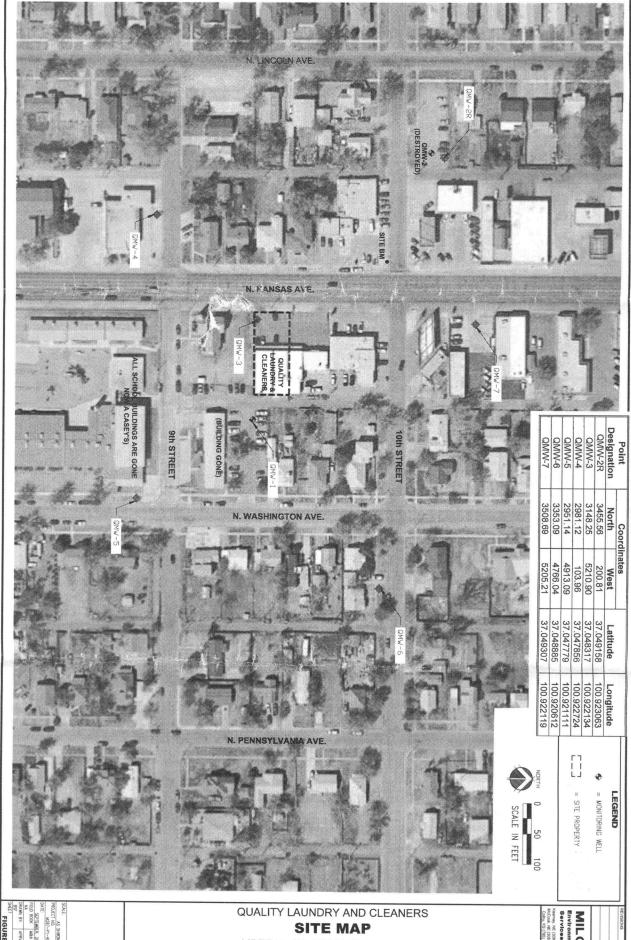

LIBERAL, KS KDHE #C1-088-71846

MILCO Environmental Services, Inc.