
		RECORI		WWC-5 ge in Well Use		vision of Wa				QMW-7	
Original Record Correction Change LOCATION OF WATER WELL:			Fraction	Resources App. No. Section Number				Well ID	- N1		
County: Seward			SW 1/4 NW 1/4 SW 1/4						ge Number		
2 WELL OWNER: Last Name:				First:	Street or Rural Address where well is located (if unknown, distance and						
	Business: KDHE				direction from	lirection from nearest town or intersection): If at owner's address, check here				neck here: 🗌	
Address:	Address: 1000 SW Jackson, Ste 410				1011 N. Ka	011 N. Kansas, Liberal					
City:	Topeka		State: KS	ZIP: 66612							
3 LOCAT		4 DED			200 -			27.040207			
WITH "		3		(PLETED WELL: .		t. 5 Latii	tude:	37.049307	(0	decimal degrees)	
1					ıntered: 1) ft. ft., or 4) ☐ Dry Well			Longitude: 100.922036 (decimal degrees) Horizontal Datum: □ WGS 84 ■ NAD 83 □ NAD 27			
N	·	WELL'S	STATIC WA	TER LEVEL: 180	.95 ft			itum: □ WGS 84 I titude/Longitude:	M NAD 8	3 LJ NAD 27	
	■ below land surface			, measured on (mo-day-	yr) 8/4/2022		GPS (unit	t make/model:EP	OCH)	
NW	NE	☐ abov	e land surface	, measured on (mo-day-	yr)	. -	(WA	AS enabled? \(\sigma\)	es 🔳 No		
\ \ \ \ \ \ \ \ \ \ \ \ \ \ \ \ \ \ \	Pump test data: Well w			vater was f				vey 🗌 Topograph	ic Map		
W	Well w			s pumping f vater was f	gpm		Online M	lapper:			
SW					nina anm						
	Estimated Yield:			gpm 6 Elev			ration: 2839.01ft. Ground Level TOC				
	S Bore Hole Diameter:			8.5 in. to 200 ft. and			ource: Land Survey GPS Topographic Map				
1 m				in. to	ft.	Other					
7 WELL WATER TO BE USED AS: 1. Domestic: 5 Public Water Supply: well ID 10 Public Water Supply: loses											
	1. Domestic: 5. ☐ Public Water Supply: well ID ☐ Household 6. ☐ Dewatering: how many wells?					10. ∐ C	10. Oil Field Water Supply: lease				
									•••		
☐ Livesto	☐ Lawn & Garden ☐ Livestock 7. ☐ Aquifer Recharge: we 8. ■ Monitoring: well ID				W-7	12. Geot		how many bores?			
	2. Irrigation 9. Environmental Remediation: well							op Horizontal			
1 =				□ Soil Vapor I	Extraction	xtraction b) Open Loop Surface Discharge In					
4. Industrial Recovery Injection 13. Other (specify):											
Was a chemical/bacteriological sample submitted to KDHE? ☐ Yes ■ No If yes, date sample was submitted:											
Water well disinfected? Yes No											
8 TYPE OF CASING USED: ☐ Steel ☐ PVC ☐ Other											
Casing diameter 4 in to 200 ft., Diameter in to ft. Casing height above land surface 4 in. Weight lbs./ft. Wall thickness or gauge No.											
TYPE OF SCREEN OR PERFORATION MATERIAL:											
☐ Steel ☐ Stainless Steel ☐ Fiberglass ■ PVC ☐ Other (Specify)											
☐ Brass ☐ Galvanized Steel ☐ Concrete tile ☐ None used (open hole)											
SCREEN OR PERFORATION OPENINGS ARE: Continuous Slot Mill Slot Gauze Wrapped Torch Cut Drilled Holes Other (Specify)											
☐ Continuous Slot ☐ Mill Slot ☐ Gauze Wrapped ☐ Torch Cut ☐ Drilled Holes ☐ Other (Specify)											
SCREEN-P	SCREEN-PERFORATED INTERVALS: From										
GRAVEL PACK INTERVALS: From 167 ft. to 200 ft., From ft. to ft., From ft. to ft.											
9 GROUT MATERIAL: ☐ Neat cement ☐ Cement grout ■ Bentonite ☐ Other											
Grout Intervals: From ft. to ft., From ft. to ft., From ft. to ft.											
Nearest sour				. III bu bu		T			~		
☐ Septic Tank ☐ Lateral Lines ☐ Pit Privy ☐ Livestock Pens ☐ Insecticide Storage ☐ Sewer Lines ☐ Cess Pool ☐ Sewage Lagoon ■ Fuel Storage ☐ Abandoned Water Well								rall			
☐ Watertight Sewer Lines ☐ Seepage Pit ☐ Feedyard ☐ Fertilizer Storage ☐ Oil Well/Gas Well								en			
Other (S	Specify)		· · · · · · · · · · · · · · · · · · ·				Ü		, •11		
10 FROM	m well?		· · · · · · · · · · · · · · · · · · ·	Distance from we	11?			ft.			
	TO 0.5	Concrete	LITHOLOG	AC LOG	FROM	TO		. LOG (cont.) or PL	UGGING	INTERVALS	
	12	Silt			123 163	163		e and clay			
	32	Sand				177 201	Sand	y and caliche			
	50	Clay		177	201	Saliu					
50		Sandy clay		 							
	79	Sand Sand			L						
	101	Clay and c	aliche	Notes: C	Notes: Quality Laundry and Cleaners						
101	105	Gravelly s		_	KDHE Project Code: C1-088-71846						
105 123 Clay and caliche											
11 CONTRACTOR'S OR LANDOWNER'S CERTIFICATION: This water well was constructed, or plugged under my inriediction and was annually described by the constructed of the											
Kansas Wat	under my jurisdiction and was completed on (mo-day-year) .6/17/2022 and this record is true to the best of my knowledge and belief. Kansas Water Well Contractor's License No. 881 This Water Well Record was completed on (mp-day-year) .6/16/2022										
under the bu	isiness nam	ne of Woof	ter Pump ar	ad Well	ier weil Ked	ora was con	inpleted	on trae-may-year)	191.10121	ł4.4	
Mail 1	white copy al	ong with a fee	of \$5.00 for eac	od Well.	sas Department	of Health and	Environm	nent, Bureau of Water.	GWTS Se	ction,	
1000	SW Jackson S	St., Suite 420, 7	Topeka, Kansas (66612-1367. Mail one to V	Vater Well Own	ner and retain o	one for you	ur records. Telephone	785-296-55	524.	
Visit us at http://www.kdhcks.gov/waterwell/index.html KSA 82a-1212 Revised 7/10/201											

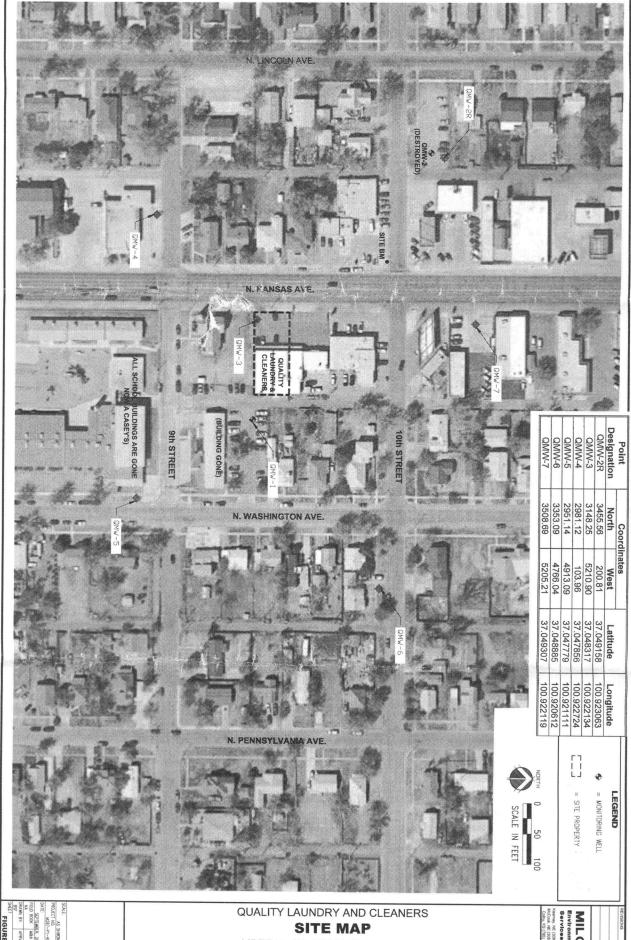

LIBERAL, KS KDHE #C1-088-71846

MILCO Environmental Services, Inc.