
			RECORD		WWC-5			sion of Wate	•			MW-11	
			Correction		e in Well Use			urces App. N		T	Well ID		
1 1		ION OF Mortor	WATER WELI	L :	Fraction SE 1/4 NE 1/4 SE 1	¼ N		tion Numbe 2	r	Township Numb		nge Number 0 □ E ■ W	
, ,			Last Name:		First:				wher	e well is located			
		Elkhart			1 1100.	direction from nearest town or intersection): If at owner's address, check here:							
- 1	Address:	P.O. Bo				An	Approx. 40' N of Hwy 56 on the E side of Hwy 51, Rolla						
	Address:	P*11.bank		State: KS	ZIP: 67950								
	City: LOCATE	Elkhart				ا،	444 -	1		07.40000	2011		
-	WITH "				PLETED WELL:								
	Depth(s) Groundwater Encountered: 1)												
	WELL'S STATIC WATER LEVEL: 115.20 0							Source for Latitude/Longitude:					
Γ	777		below la	nd surface,	measured on (mo-da	y-yr).	/-yr)11-29-16 ☐ GI			mit make/model:	EPOCH)	
.	above land surface, measured on (mo-						• • • • • • • • • • • • • • •		(WAAS enabled? Tyes No)				
	Pump test data: Well water was									and Survey Topographic Map			
W	E after hours pumping										i		
-	- SW SE after hours pumping						W WARRANT CONTROL OF THE PROPERTY OF THE PROPE						
L	Estimated Yield:gpm						6 Elevation:						
	S Bore Hole Diameter:8.5 in. to						- I DAL				, ;		
in. toft. Other													
7 WELL WATER TO BE USED AS: 1. Domestic: 5. Public Water Supply: well ID													
. =	Household 6. ☐ Dewatering: how many wells												
_													
_	Lawn & Garden 7. ☐ Aquifer Recharge: well ID Livestock 8. ☐ Monitoring: well ID						V-11 12. Geothermal: how many bores?						
	☐ Irrigation 9. Environmental Remediation: wel							a) Cl	osed	Loop Horizon	tai ∐ Vert	ical	
	3. ☐ Feedlot ☐ Air Sparge ☐ Soil Vap 4. ☐ Industrial ☐ Recovery ☐ Injection						raction	b) Open Loop Surface Discharge Inj. of Water 13. Other (specify):					
_													
Was a chemical/bacteriological sample submitted to KDHE? Yes No If yes, date sample was submitted:													
0 7	POPO	FCASIN	C HEED. The	aal B DV	C Other		CASIN	G IOINTS		Glued □ Clamper	d D Welde	d Threaded	
Cas	ine diame	eler	in. to	ິໄ ໄ ໄດ້	Diameter	in.		fl., Dian	neter	in. to	ถึ		
Casing diameter													
TYPE OF SCREEN OR PERFORATION MATERIAL:													
☐ Steel ☐ Stainless Steel ☐ Fiberglass ☐ PVC ☐ Other (Specify)													
	☐ Brass ☐ Galvanized Steel ☐ Concrete tile ☐ None used (open hole) SCREEN OR PERFORATION OPENINGS ARE:												
		uous Slot				Torch	Cut 🗆 🗅	rilled Holes		Other (Specify)			
		red Shutte				Saw (lone (Open H		•····· (••••···), ····			
SC	REEN-P	ERFORA	ATED INTERVA	LS: From	n111 ft. to .141								
	GI	RAVEL	PACK INTERVA	LS: From	<u>ո107</u>	<u> 11</u>	ft., From .	fl. to	0	ft., From	fl. te) fl.	
9 (GROUT	MATE	RIAL: Neat o	ement [Cement grout	Bento	onite 📕 C	ther CONCIO	ete c)-1 II	<u>.</u>		
					ft., From	fl.	10	A., From	•••••	fl. to	fl.		
	rest sou! Septic		sible contaminatio	on: .ateral Line	s 📋 Pit Privy		П	Livestock Pe	ns	□ Insectio	cide Storage	_	
	_ Sewer I			ess Pool	☐ Sewage I			Fuel Storage			oned Water		
	Waterti	ght Sewer	Lines 🔲 S	eepage Pit	☐ Feedyard	1		Fertilizer Sto	rage	☐ Oil We	ell/Gas Well	ŀ	
					Distance from					•			
	FROM	m well?			Distance from GIC LOG	well?	FROM					JG INTERVALS	
0		0.5	Grass		GIC EUG	+	TROM	10	<u> </u>	ino. Eou (cont.) o	ייייייייייייייייייייייייייייייייייייייי	O INTERVALO	
0.5		19	Silt with clay			\dashv					<u>,,,,,,,,,,,,,,,,,,,,,,,,,,,,,,,,,,,,,</u>		
19		42	Sand with cla	av .		1					*************************************		
42		72	Sand with cla		liche							<u></u>	
72		131	Silty Clay and										
131		142	Sand with gra	avel and	clay								
-	Notes:												
11	CONT	RACTO	R'S OR LANDO	WNFD	S CERTIFICATIO)N.	This wate	r well vac f		nstructed [7] roa	onetwork	or I plucand	
nuc	der my ii	urisdictio	n and was compl	cted on (r	no-day-year) .1.1:1.	7:-16	and	this record i	is tra	e to the best of	onstructed Wknowler	ige and belief.	
11 CONTRACTOR'S OR LANDOWNER'S CERTIFICATION: This water well was constructed, reconstructed, or plugged under my jurisdiction and was completed on (mo-day-year) .1.1.17.16													
under the business name of Wootter Pump & Well. Mail I white copy along with a fee of \$5.00 for each constructed well to: Kansas Department of Health and Environment, Burgan of Water GWTS Section,													
	1000 Mari	SW Inches	y along with a ICC 01 : on St. Suite 470. Ton	cka Kansas	66612-1367. Mail one	musus Ma	ter Well Own	or measurand per and minim o	CDVH	runinent, Burgaerof W	hone 785-204	Section,	
Vis	it us at htt	p://www.kd	heks.gov/waterwell/i	ndex.html	OGGIZ-130). Wint One		SA 82a-12		101	. , our records, terepi		d 7/10/2015	

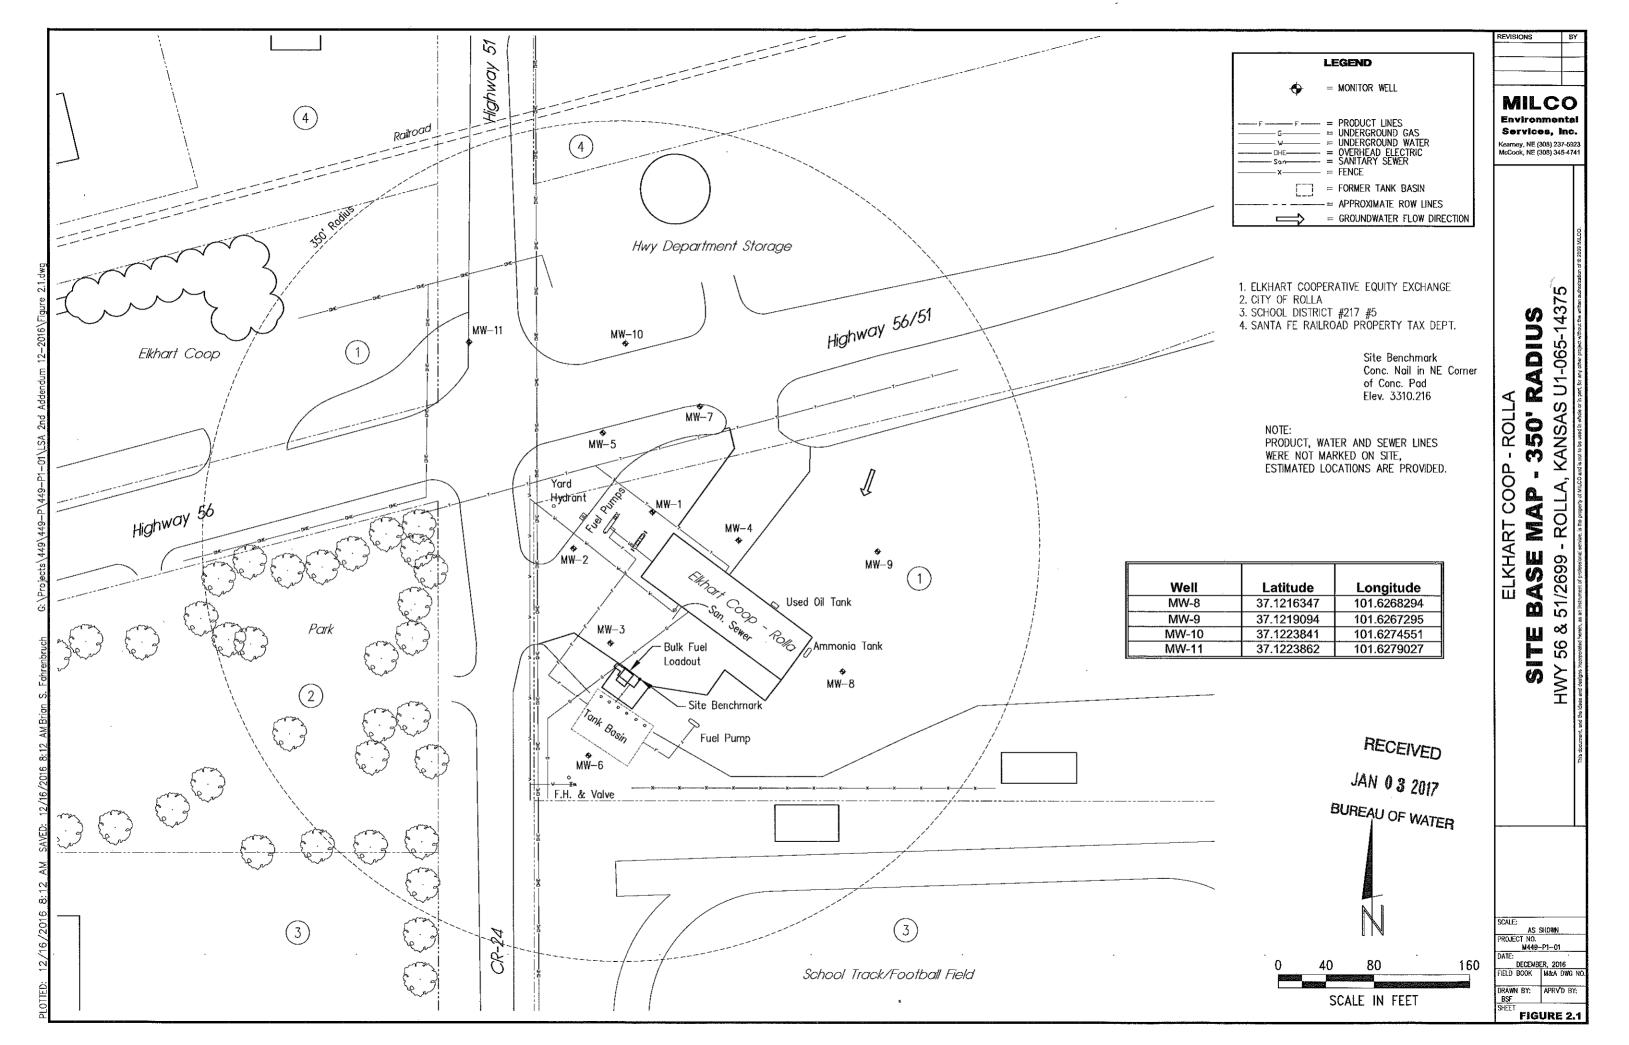

Fax: 785-460-4220 www.milcoinc.com

December 28, 2016

Kansas Department of Health and Environment Bureau of Water, Geology Section 1000 SW Jackson St, Ste 420 Topeka, KS 66612-1367

Re:

Elkhart Coop-Rolla, Rolla

KDHE Project Code U1-065-14375 MILCO Project No. M449-P1-01

To Bureau of Water, Geology Section:

Enclosed, please find 4 Form WWC-5s for wells MW-8, MW-9, MW-10, and MW-11 at the Elkhart Coop site in Rolla, Kansas along with payment of \$5.00 for each, totaling \$20.00. A map showing locations and latitude/longitude data for the 4 wells is included.

If you have any questions or need additional information, please do not hesitate to contact us.

Respectfully submitted,

MILCO Environmental Services, Inc.

Kathy Wheelbarger Office Assistant

Enclosures

RECEIVED

JAN 03 2017

BUREAU OF WATER