
WATER WELL R				sion of Water				
Original Record		ge in Well Use		urces App. No.		Well ID	-	
1 LOCATION OF W		Fraction		ion Number	Township Number		ge Number	
County: SEWARD		SE14 NW 14 SE 14		6	T 35 S		B □ E ■ W	
2 WELL OWNER: Last Name: First: Street or Rural Address where well is located (if unknown, distance and								
Business: TRC Companies, INC Address: 650 Suffolk Street direction from nearest town or intersection): If at owner's address, check here:								
Address: 650 Suffo								
City: Lowell State: MA ZIP: 01854								
3 LOCATE WELL	4 DEPTH OF COL		210 A		37 02758	<u>R</u>		
WITH "X" IN	A DEPTH OF COM	MPLETED WELL: Encountered: 1)7	π Δ Δ	5 Latitude	-100 0434		(decimal degrees)	
SECTION BOX:	2) 175 A	3) ft., or 4)	? 1L. 1 Dry Well		de: -100.9436			
N		TER LEVEL:	Horizontal Datum: ■ WGS 84 □ NAD 83 □ NAD 27 Source for Latitude/Longitude:					
	1 1	e, measured on (mo-day-		GPS (unit make/model: Iphone)				
NW NE	above land surface	e, measured on (mo-day-	ут)	(WAAS enabled? ☐ Yes ☐ No)				
		water was ft		☐ Land Survey ☐ Topographic Map				
W E		rs pumping		Online Mapper:				
SW SE		water was fl						
		rs pumping	6 Elevation:ft. Ground Level TOC					
S	Bore Hole Diameter: 8 in to 210 ft. and Source: ☐ Land Survey ☐ GPS ☐ Topographic						pographic Map	
mile	Dole Hote Blancier.	9 in to 128	ft.		Other			
7 WELL WATER TO BE USED AS:								
1. Domestic:		ater Supply: well ID		10. 🔲 Oil F	ield Water Supply: lea	ase		
☐ Household	6. Dewatering: how many wells?			11. Test Hole: well ID				
☐ Lawn & Garden	7. Aquifer Recharge: well ID			☐ Cased ☐ Uncased ☐ Geotechnical				
Livestock		ng: well ID		12. Geothermal: how many bores?				
2. Irrigation		9. Environmental Remediation: well ID			a) Closed Loop ☐ Horizontal ☐ Vertical b) Open Loop ☐ Surface Discharge ☐ Inj. of Water			
3. ☐ Feedlot 4. ☐ Industrial	☐ Air Sparg ☐ Recovery		xuraction					
Was a chemical/bacteriological sample submitted to KDHE? ☐ Yes ■ No If yes, date sample was submitted:								
Water well disinfected? Yes No CASDIC IODITS: FIGURE 1								
8 TYPE OF CASING USED: ☐ Steel ☐ PVC ☐ Other								
Casing diameter 4 in. to 180 ft., Diameter in. to ft., Diameter in. to ft., Diameter in. to ft. Casing height above land surface 30 in. Weight lbs/ft. Wall thickness or gauge No. SCH40								
TYPE OF SCREEN OR PERFORATION MATERIAL:								
☐ Steel ☐ Stainless Steel ☐ Fiberglass ■ PVC ☐ Other (Specify)								
☐ Brass ☐ Galvanized Steel ☐ Concrete tile ☐ None used (open hole)								
SCREEN OR PERFORATION OPENINGS ARE:								
☐ Continuous Slot ☐ Mill Slot ☐ Gauze Wrapped ☐ Torch Cut ☐ Drilled Holes ☐ Other (Specify)								
□ Louvered Shutter □ Key Punched □ Wire Wrapped □ Saw Cut □ None (Open Hole)								
SCREEN-PERFORATED INTERVALS: From .180 ft. to .210 ft., From ft. to ft., From ft. to ft.								
GRAVEL PACK INTERVALS: From								
9 GROUT MATERIAL: Neat cement Cement grout Bentonite Other Bentonite Chips								
Grout Intervals: From 177 ft. to 168 ft., From 168 ft. to 0 ft., From ft. to ft.								
Nearest source of possible contamination: □ Septic Tank □ Lateral Lines □ Pit Privy □ Livestock Pens □ Insecticide Storage								
Sewer Lines Cess Pool Sewage Lagoon Fuel Storage Abandoned Water Well								
□ Watertight Sewer Lines □ Seepage Pit □ Feedyard □ Fertilizer Storage □ Oil Well/Gas Well								
Other (Specify) N/A								
Direction from well?								
10 FROM TO	LITHOLO	GIC LOG	FROM	TO LI	THO. LOG (cont.) or	PLUGGIN	G INTERVALS	
	clayey sand							
175 210	sand							
			1					
Notes:								
44 CONTRACTIONS OF LANDOWNERS CERTIFICATION, TI'								
11 CONTRACTOR'S OR LANDOWNER'S CERTIFICATION: This water well was constructed, reconstructed, or plugged under my jurisdiction and was completed on (mo_day-year) 9/15/17								
Kansas Water Well Contractor's License No. 59.7 This Water Well Record was completed on (mo-day-year)								
under the business name of Cascade Drilling Signature								
under the business name of Cascade Drilling. Mail I white copy along with a fee of \$5.00 for each constructed well to: Kansas Department of Health and Environment, Bureau of Water, GWTS Section,								
1000 SW Jackson St., Suite 420, Topeka, Kansas 66612-1367. Mail one to Water Well Owner and retain one for your records. Telephone 785-296-5524.								
Visit us at http://www.kdheks.gov/waterwell/index.html KSA 82a-1212 Revised 7/10/2015								

HECEIVED

PRICEIVED

Google Maps 37°01'39.3"N 100°56'37.7"W

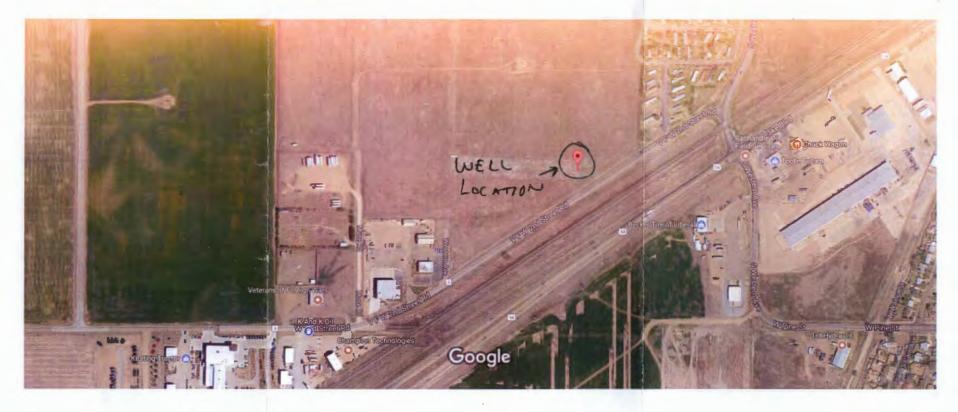

Imagery ©2017 Google, Map data ©2017 Google 200 ft